
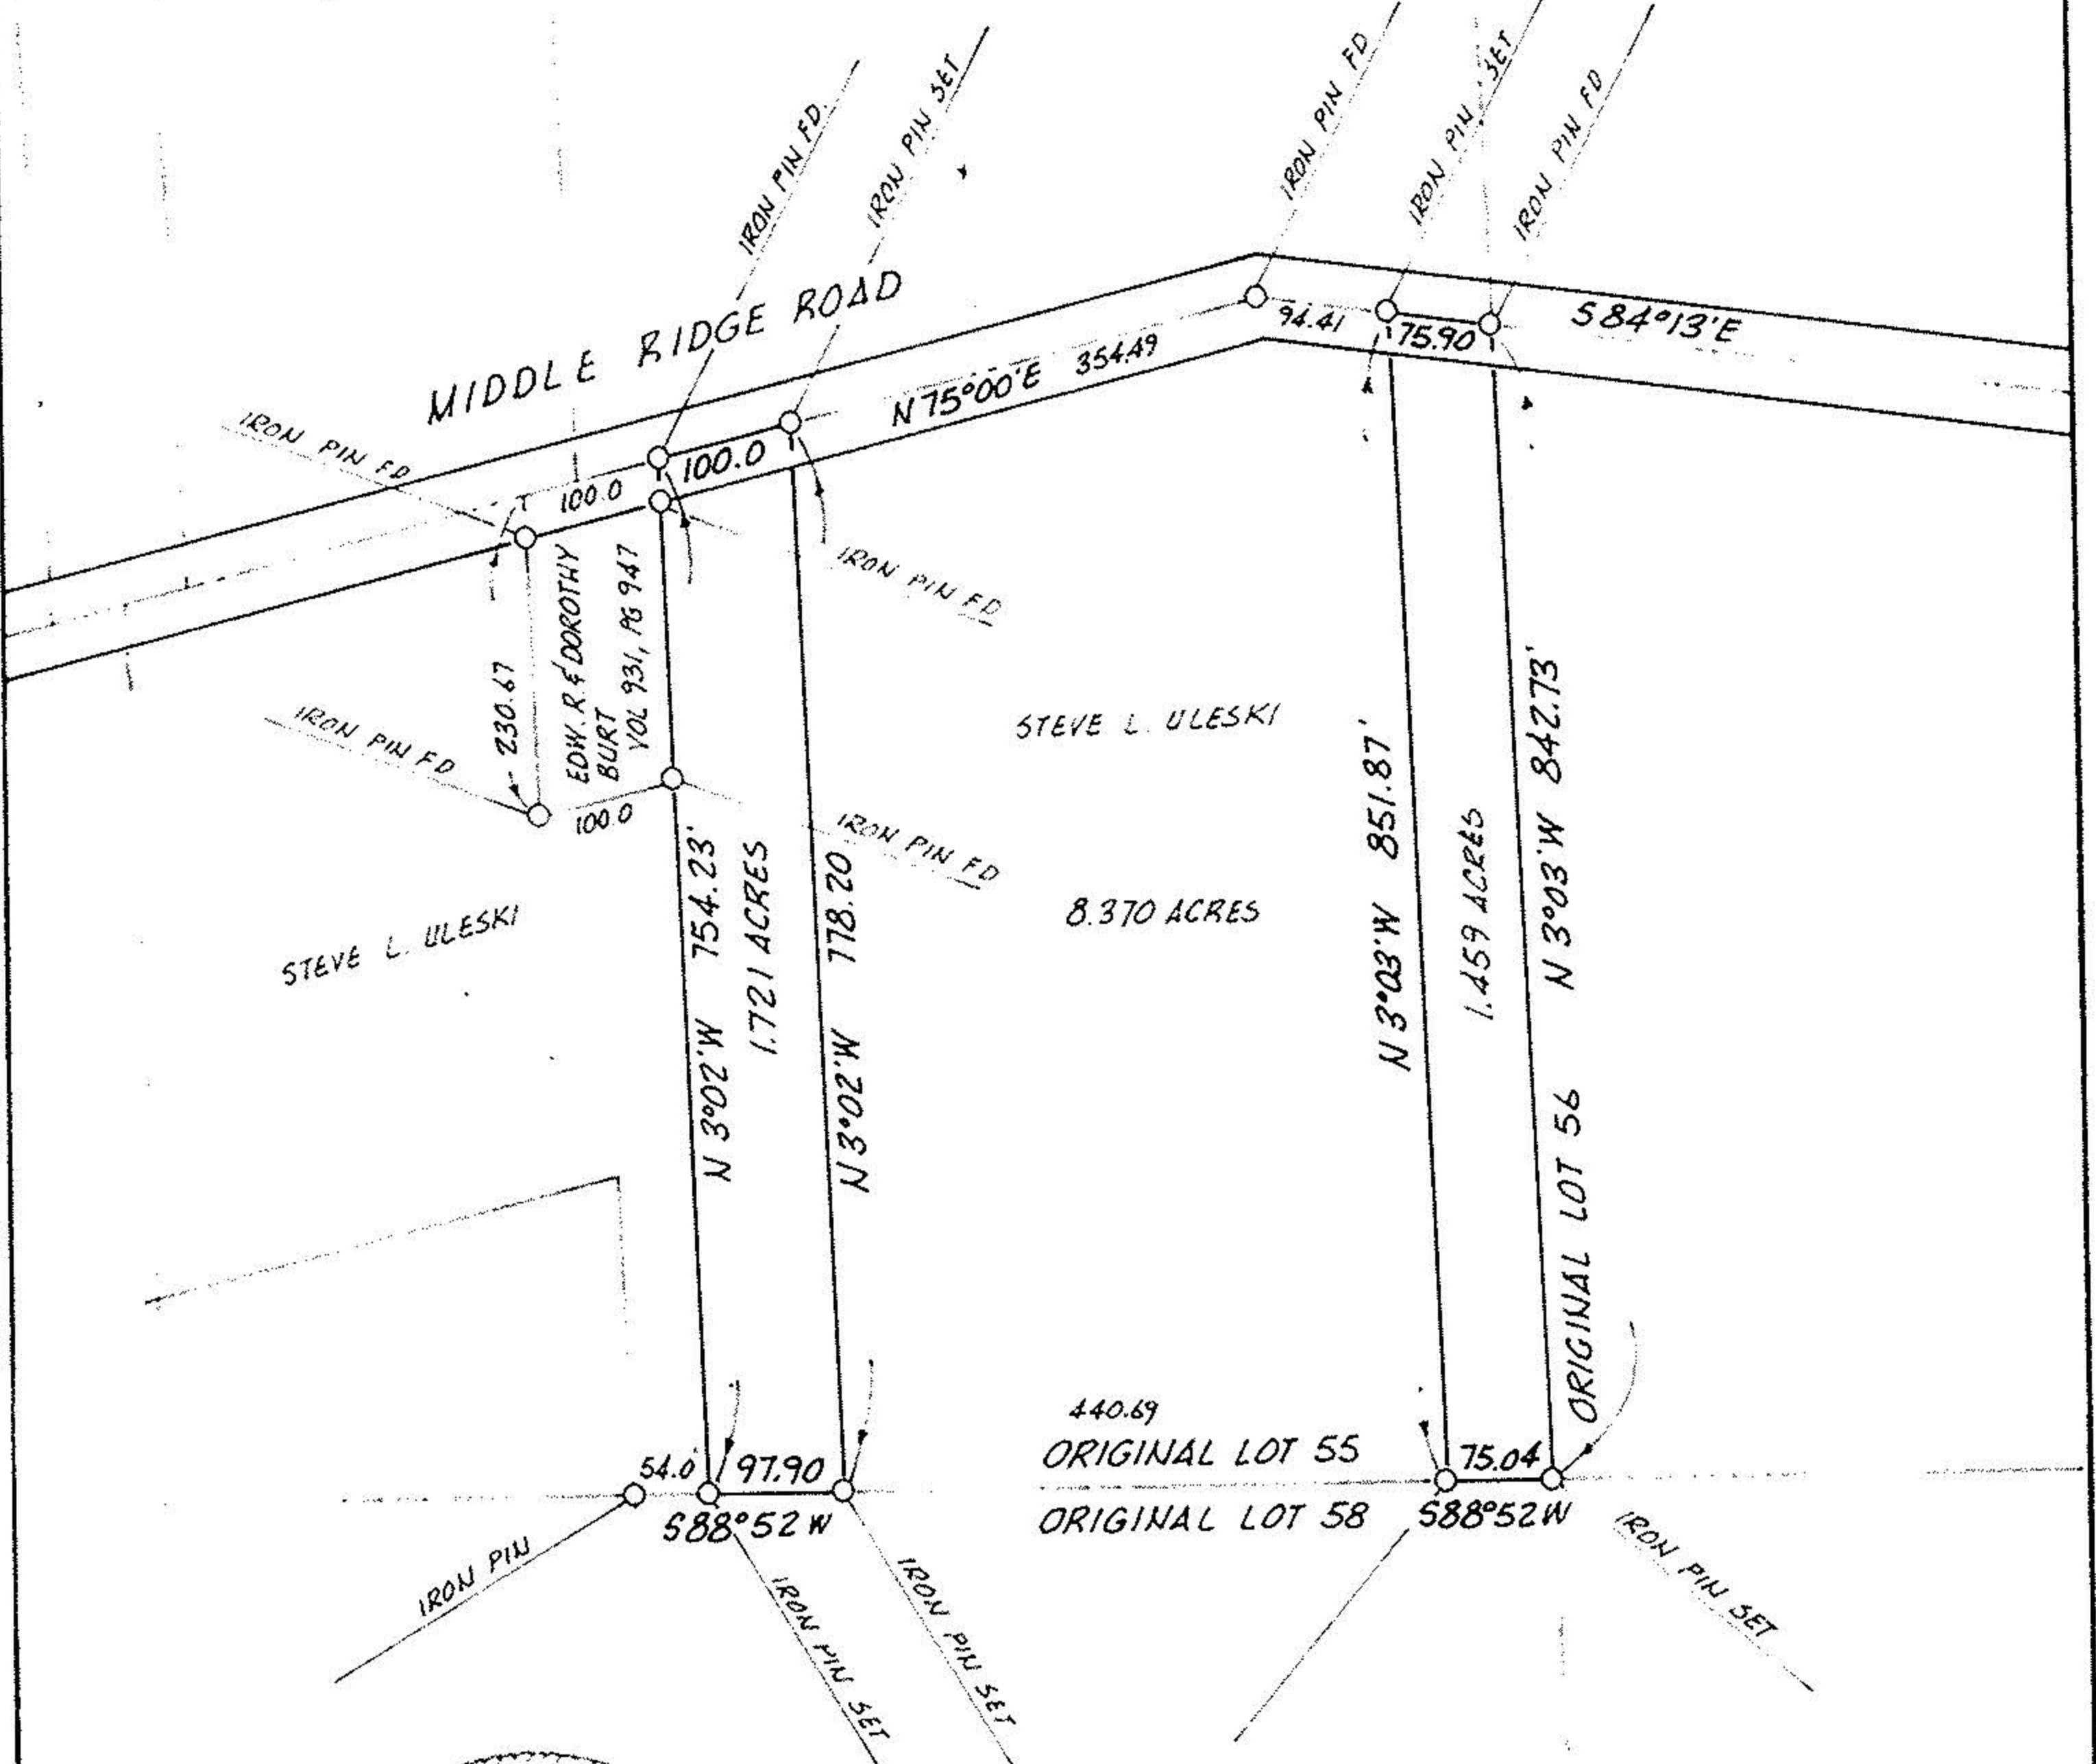


01-00-055-000-020
 01-00-055-000-022
 01-00-055-000-024
 01-00-055-000-028
 01-00-055-000-029
 1-L

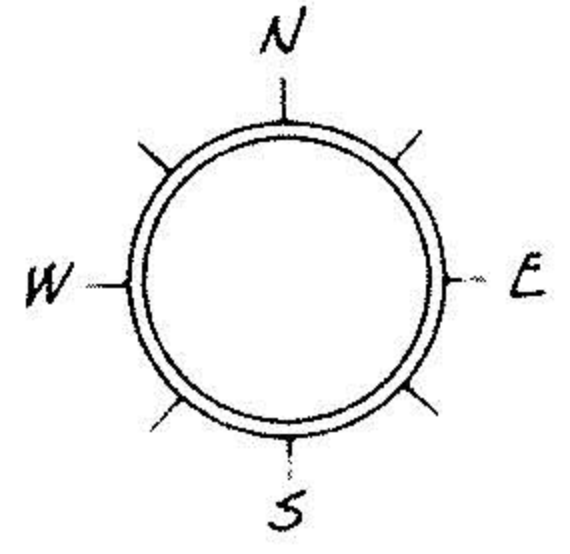

acreage 11.550 TOTAL SURVEY

DWG No.	PERIMETER SURVEY		MICHAEL G. HURA REGISTERED SURVEYOR 199 PARK AVENUE AMHERST, OHIO 44001
	Sublot _____ of _____	Vol. _____ Page _____	
	Part of O.L. 55 Sect. _____ Tr. _____		drawn MGH
	City of _____		date 4-18-74
	BROWNHELM Twp. LORAIN Co.		scale 1"=200'