
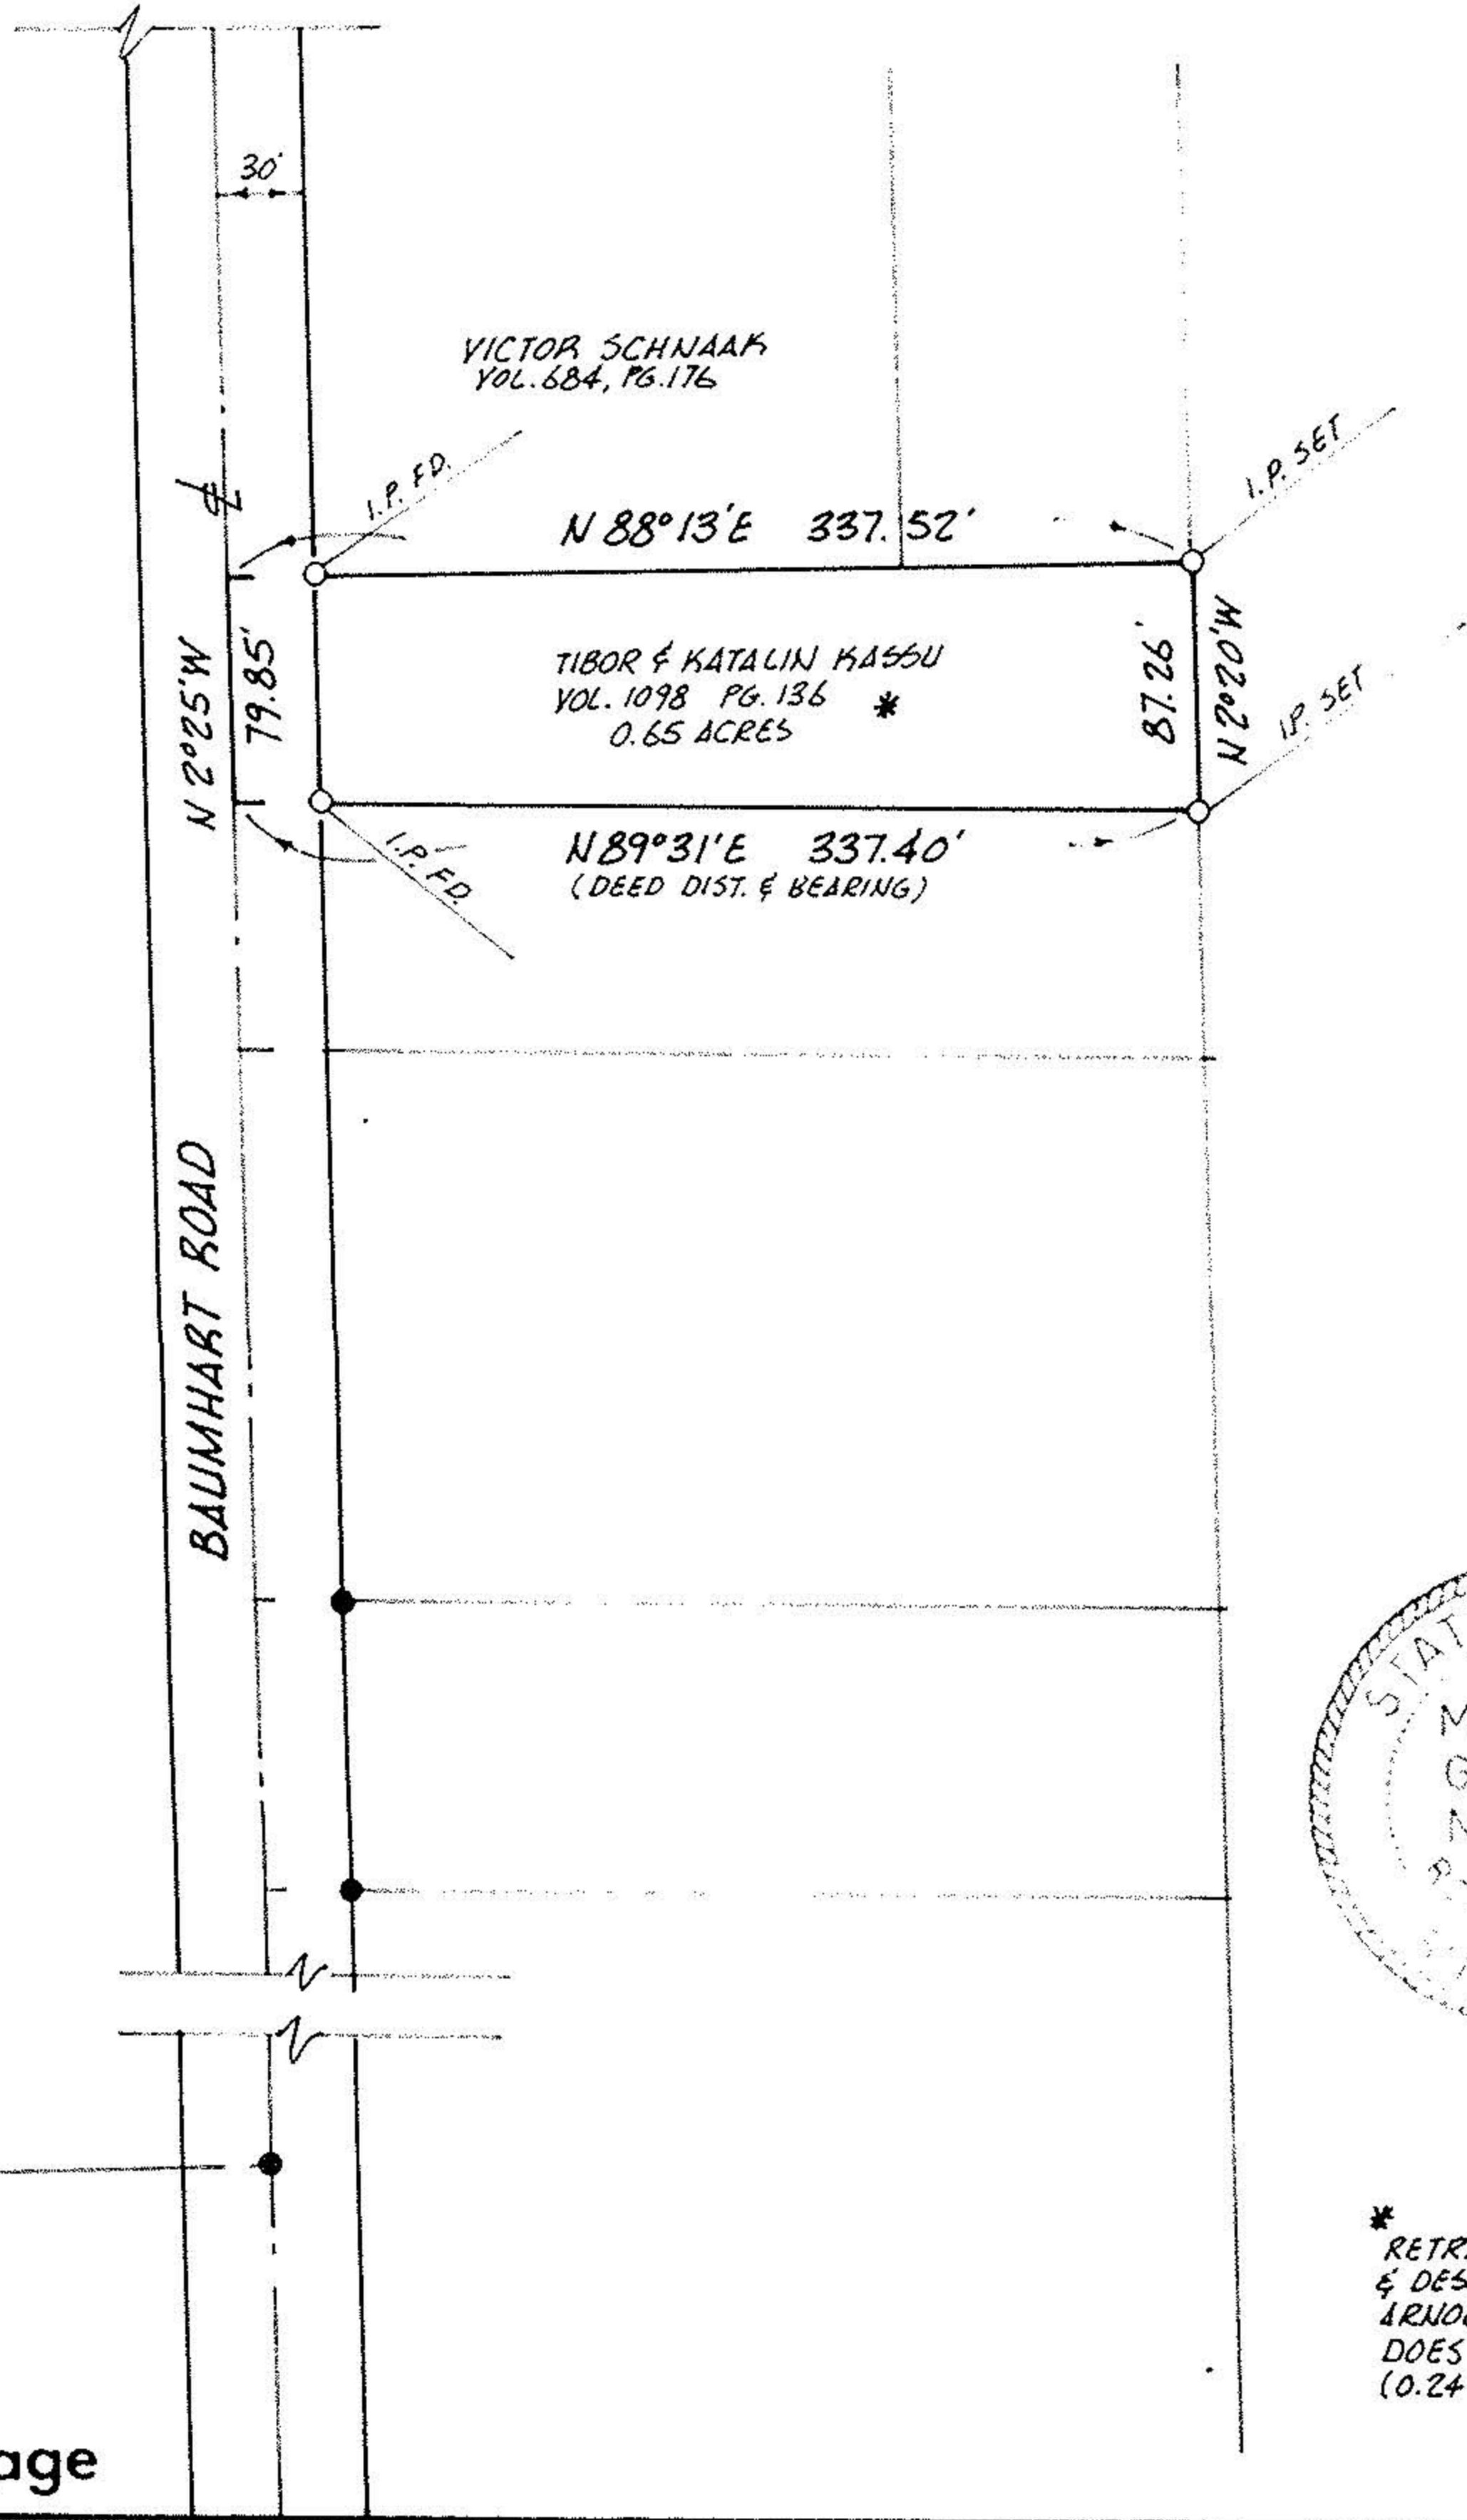


01-00-042-000-009
1-00-042-A

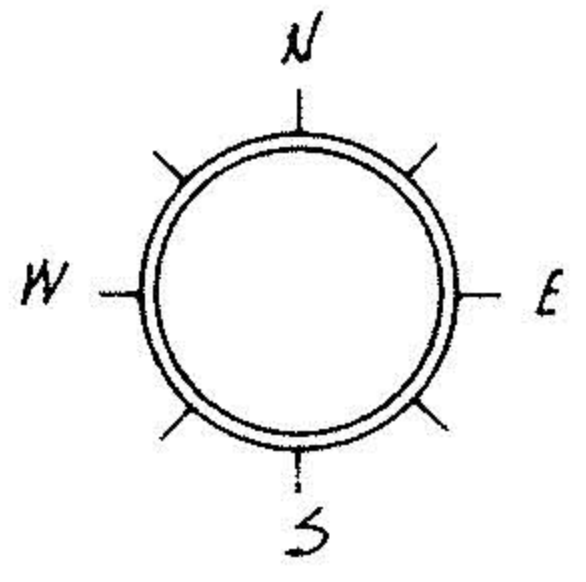

* RETRACE OF SURVEY
& DESCRIPTION BY
ARNOLD F. KOEPP
DOES NOT BALANCE
(0.24'-N-S, 0.15'-E-W)

acreage

DWG No	PERIMETER SURVEY		MICHAEL G. HURA REGISTERED SURVEYOR 199 PARK AVENUE AMHERST, OHIO 44001
	Sublot ____ of ____ Vol. ____ Page ____ Part of O.L. 42 Sect. ____ Tr. ____ City of ____ BROWNHELM Twp. LORAIN Co.		
	drawn MGH		date 4-18-74
			scale 1" = 100'