

PARENT PARCEL: 03-00-034-101-001, 03-00-034-102-026 & -026

CHILD PARCEL: XX-XX-XXX-XXX-XXX

STARTING POINT: CL OF LAKE RD. & THE EAST LINE OF O.L. 35

NO. 00260-D

# DEED CHECK

DEED DOESN'T CLOSE NO TRANSFER




14.56 : 10,000

03-00-034-101-001

03-00-034-102-029

03-00-034-102-026

03-00-034-102-021

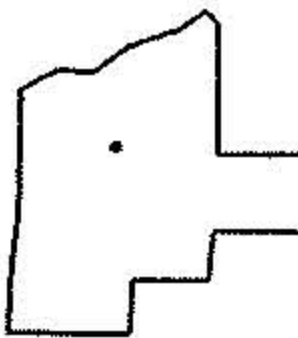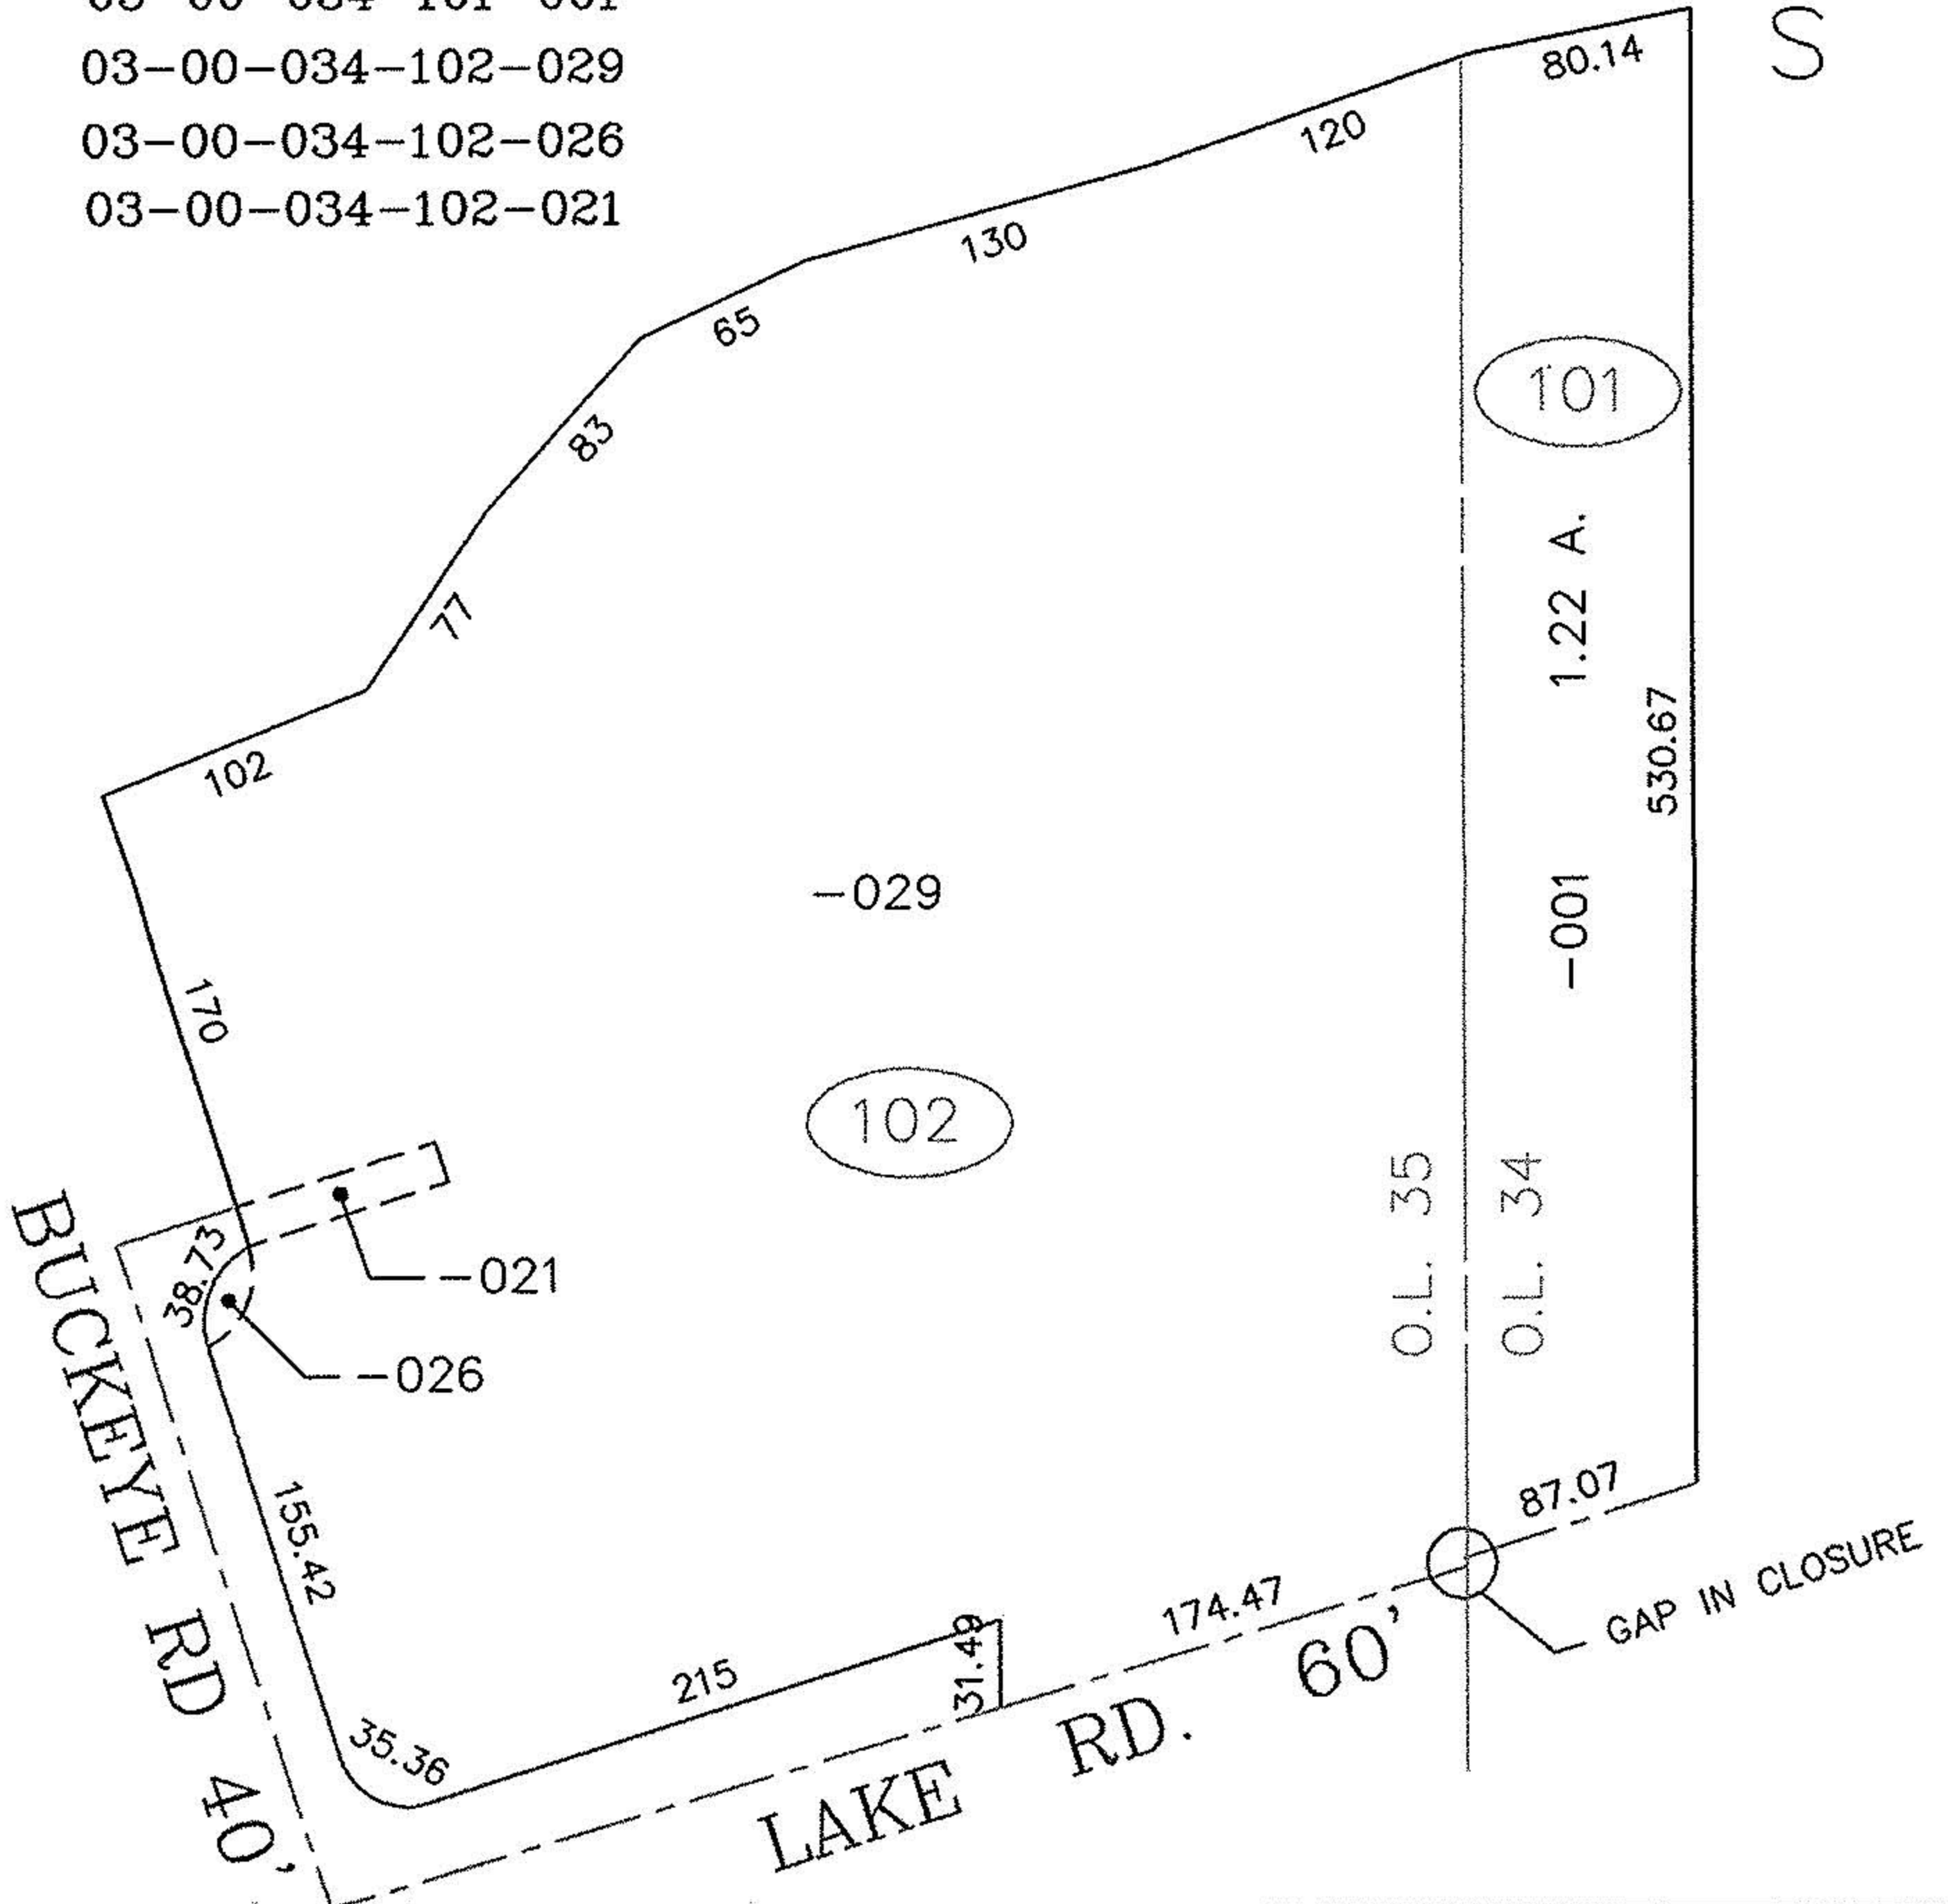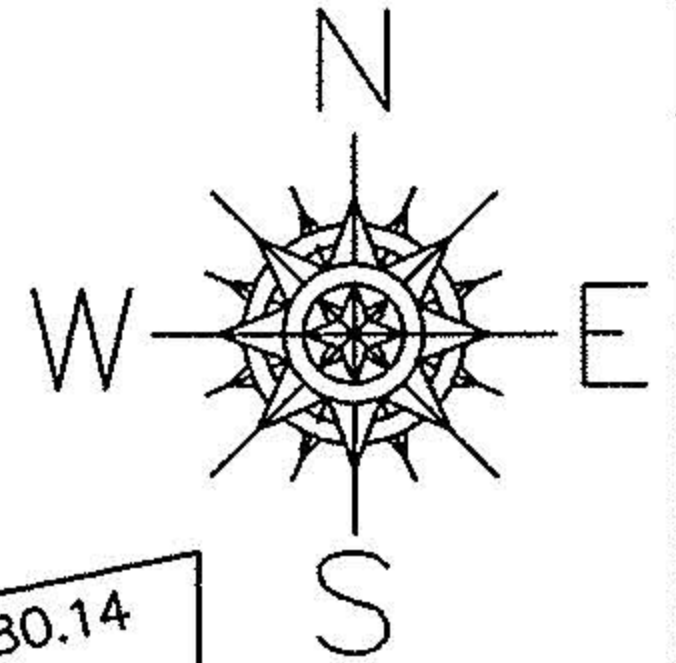

## SPLITS/DEEDS PROCESSED

LORAIN COUNTY TAX MAP DEPARTMENT  
226 MIDDLE AVE. ELYRIA, OHIO

SURVEYED BY: EDWARD B. DUDLEY III

CLOSURE: 14.56 : 10,000

MAP PAGE(S): 03-00-034-A & 03-00-035

APPROVED BY: T. SPILLMAN DATE: 02/03/00

SCALE: 1" = 100' PRIOR INSTRUMENT: OR 73/247