


01-00-003-117-001 01-00-003-117-002 01-00-003-117-003 01-00-003-117-050

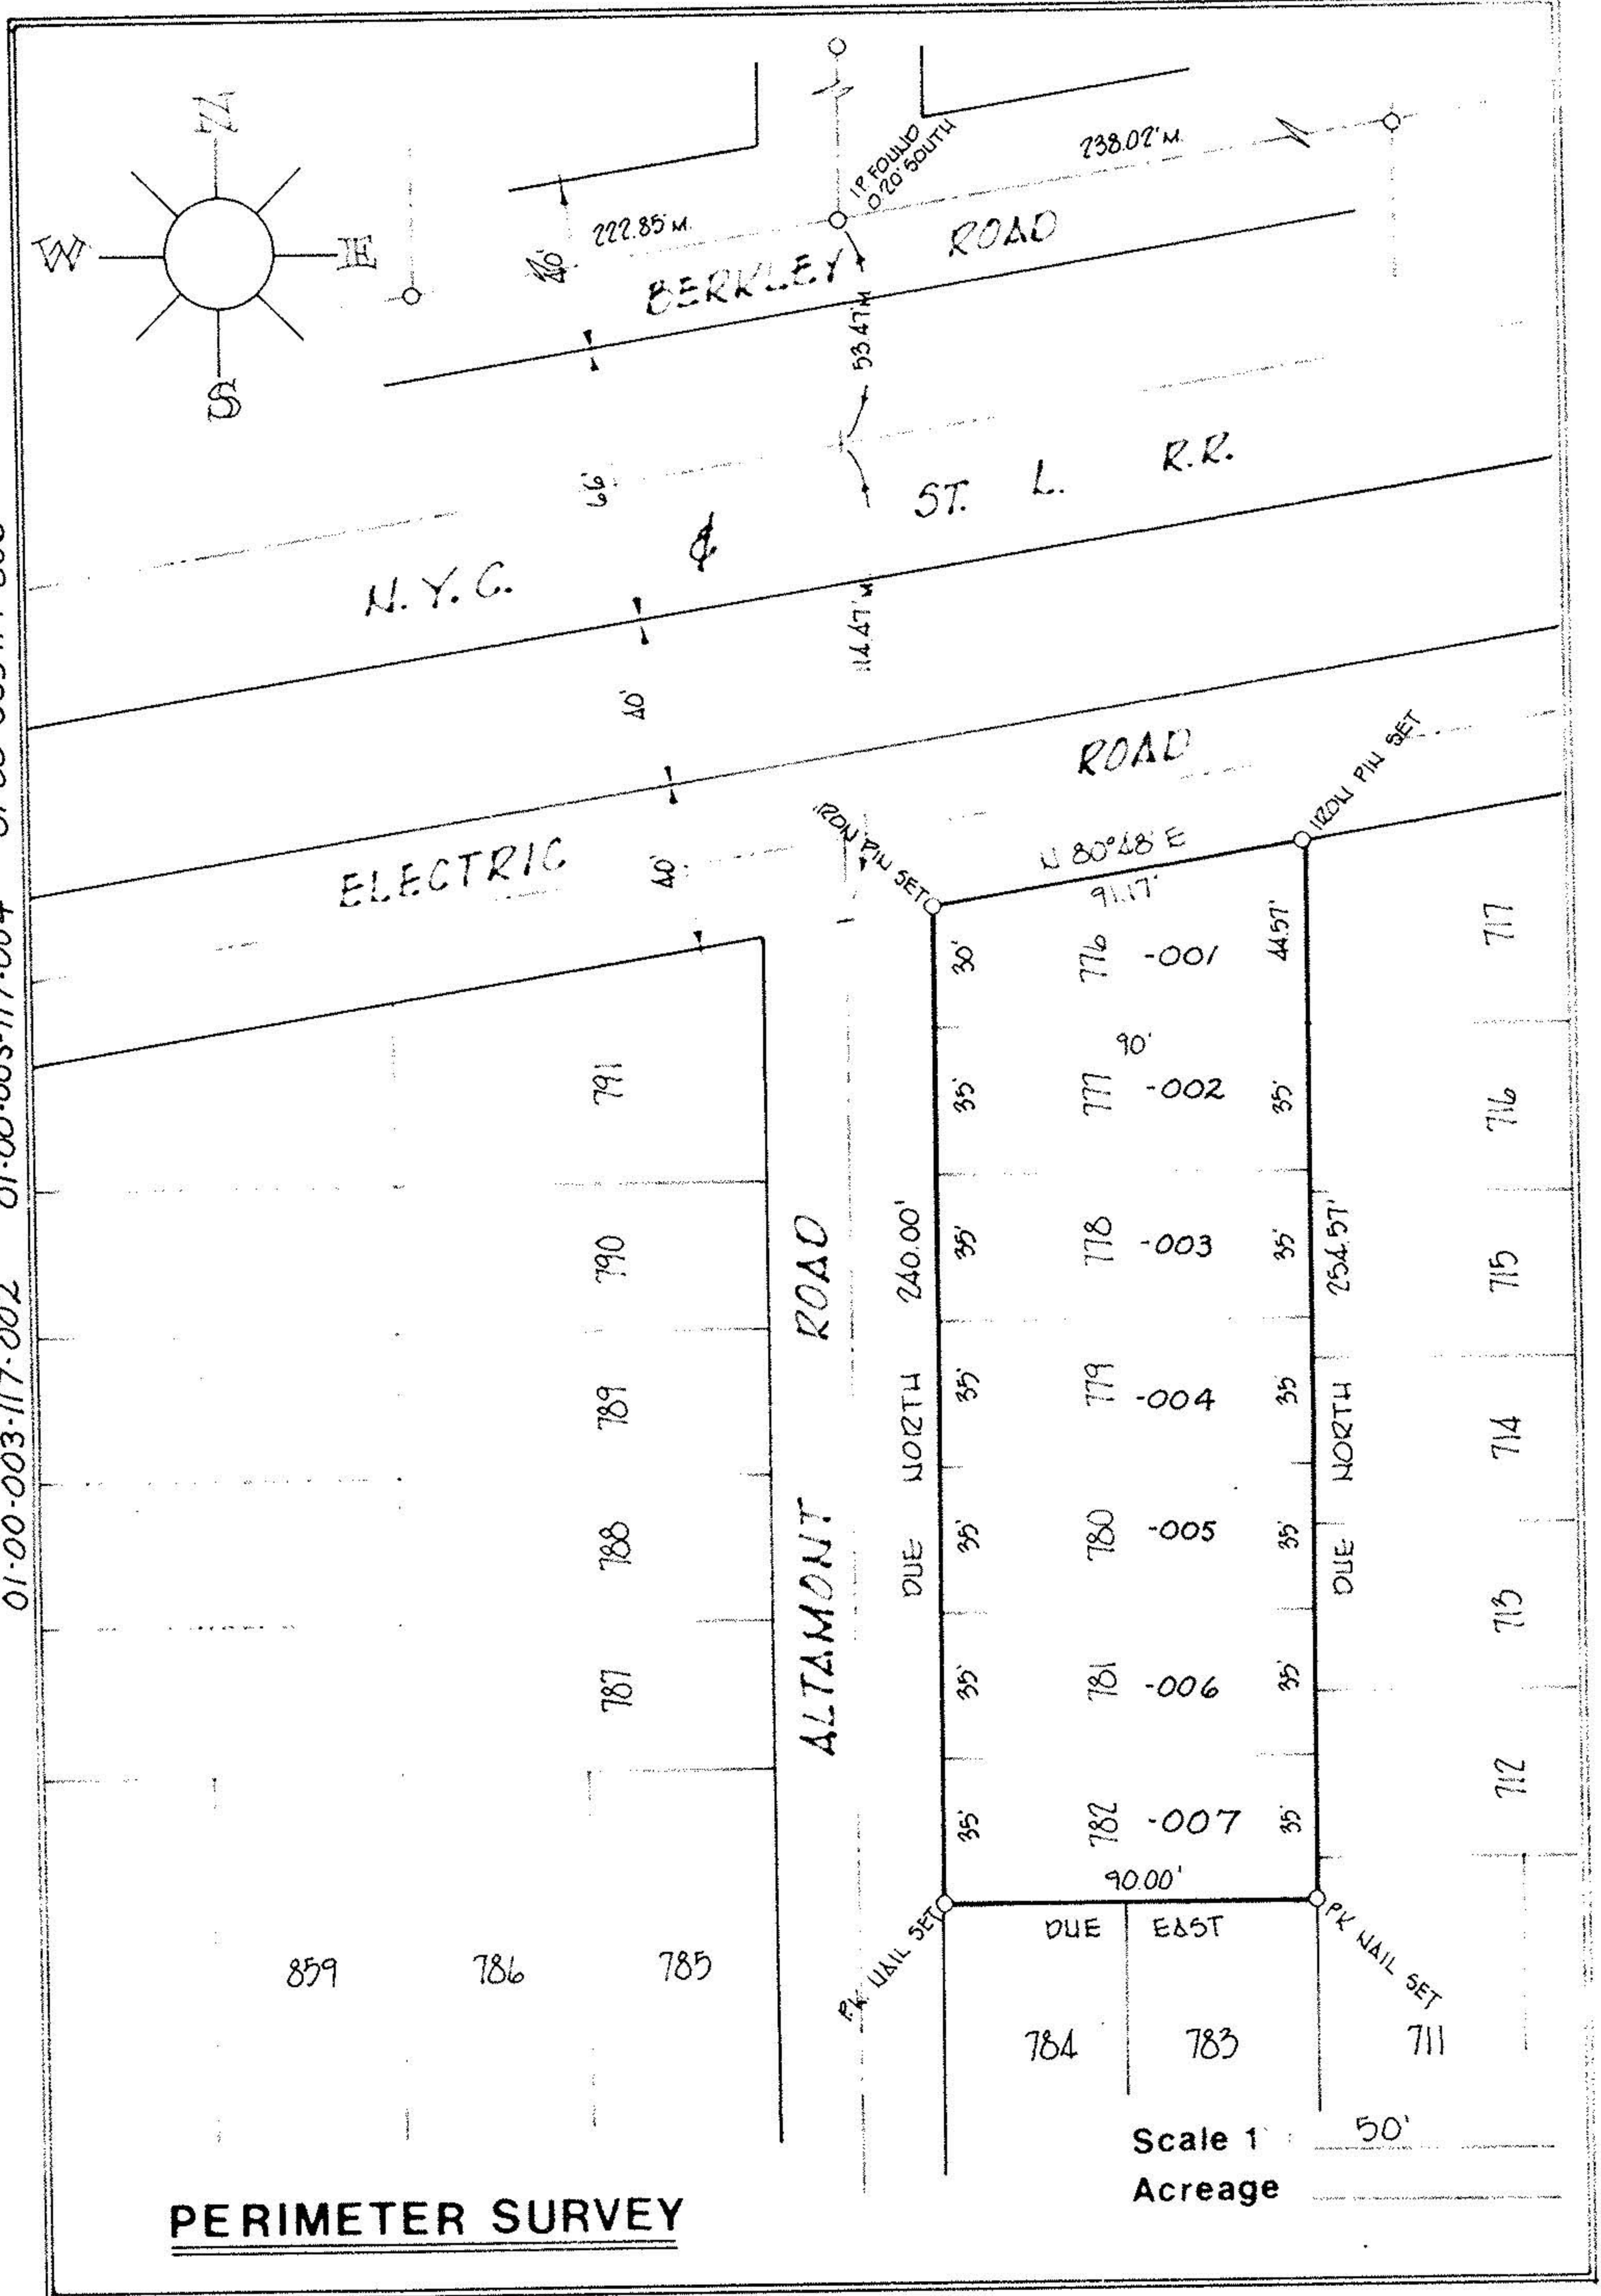

SUBLOT 776, 777, 778, 779, 780, 781, 782 OF
 VERMILION-ON-THE-LAKE SUB. NO 1
 Plat Vol 10 Page 18
 Part of O.L. 3 Section
 Tract BROWNHILL TWP
 City of VERMILION
LORDAN Co., Ohio

Michael G. Hura & Associates
 4560 Liberty Ave. Vermilion, Ohio

drawn p.a.r.
 date 7-2-80
 scale 1" = 50'
 field book

PERMANENT
 PARCEL NUMBER
 01-00-003-117-
 001 THRU 007