
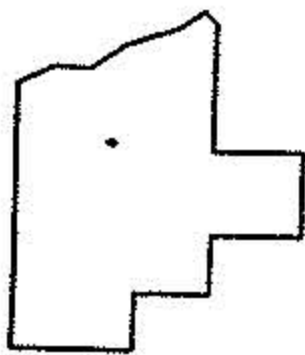
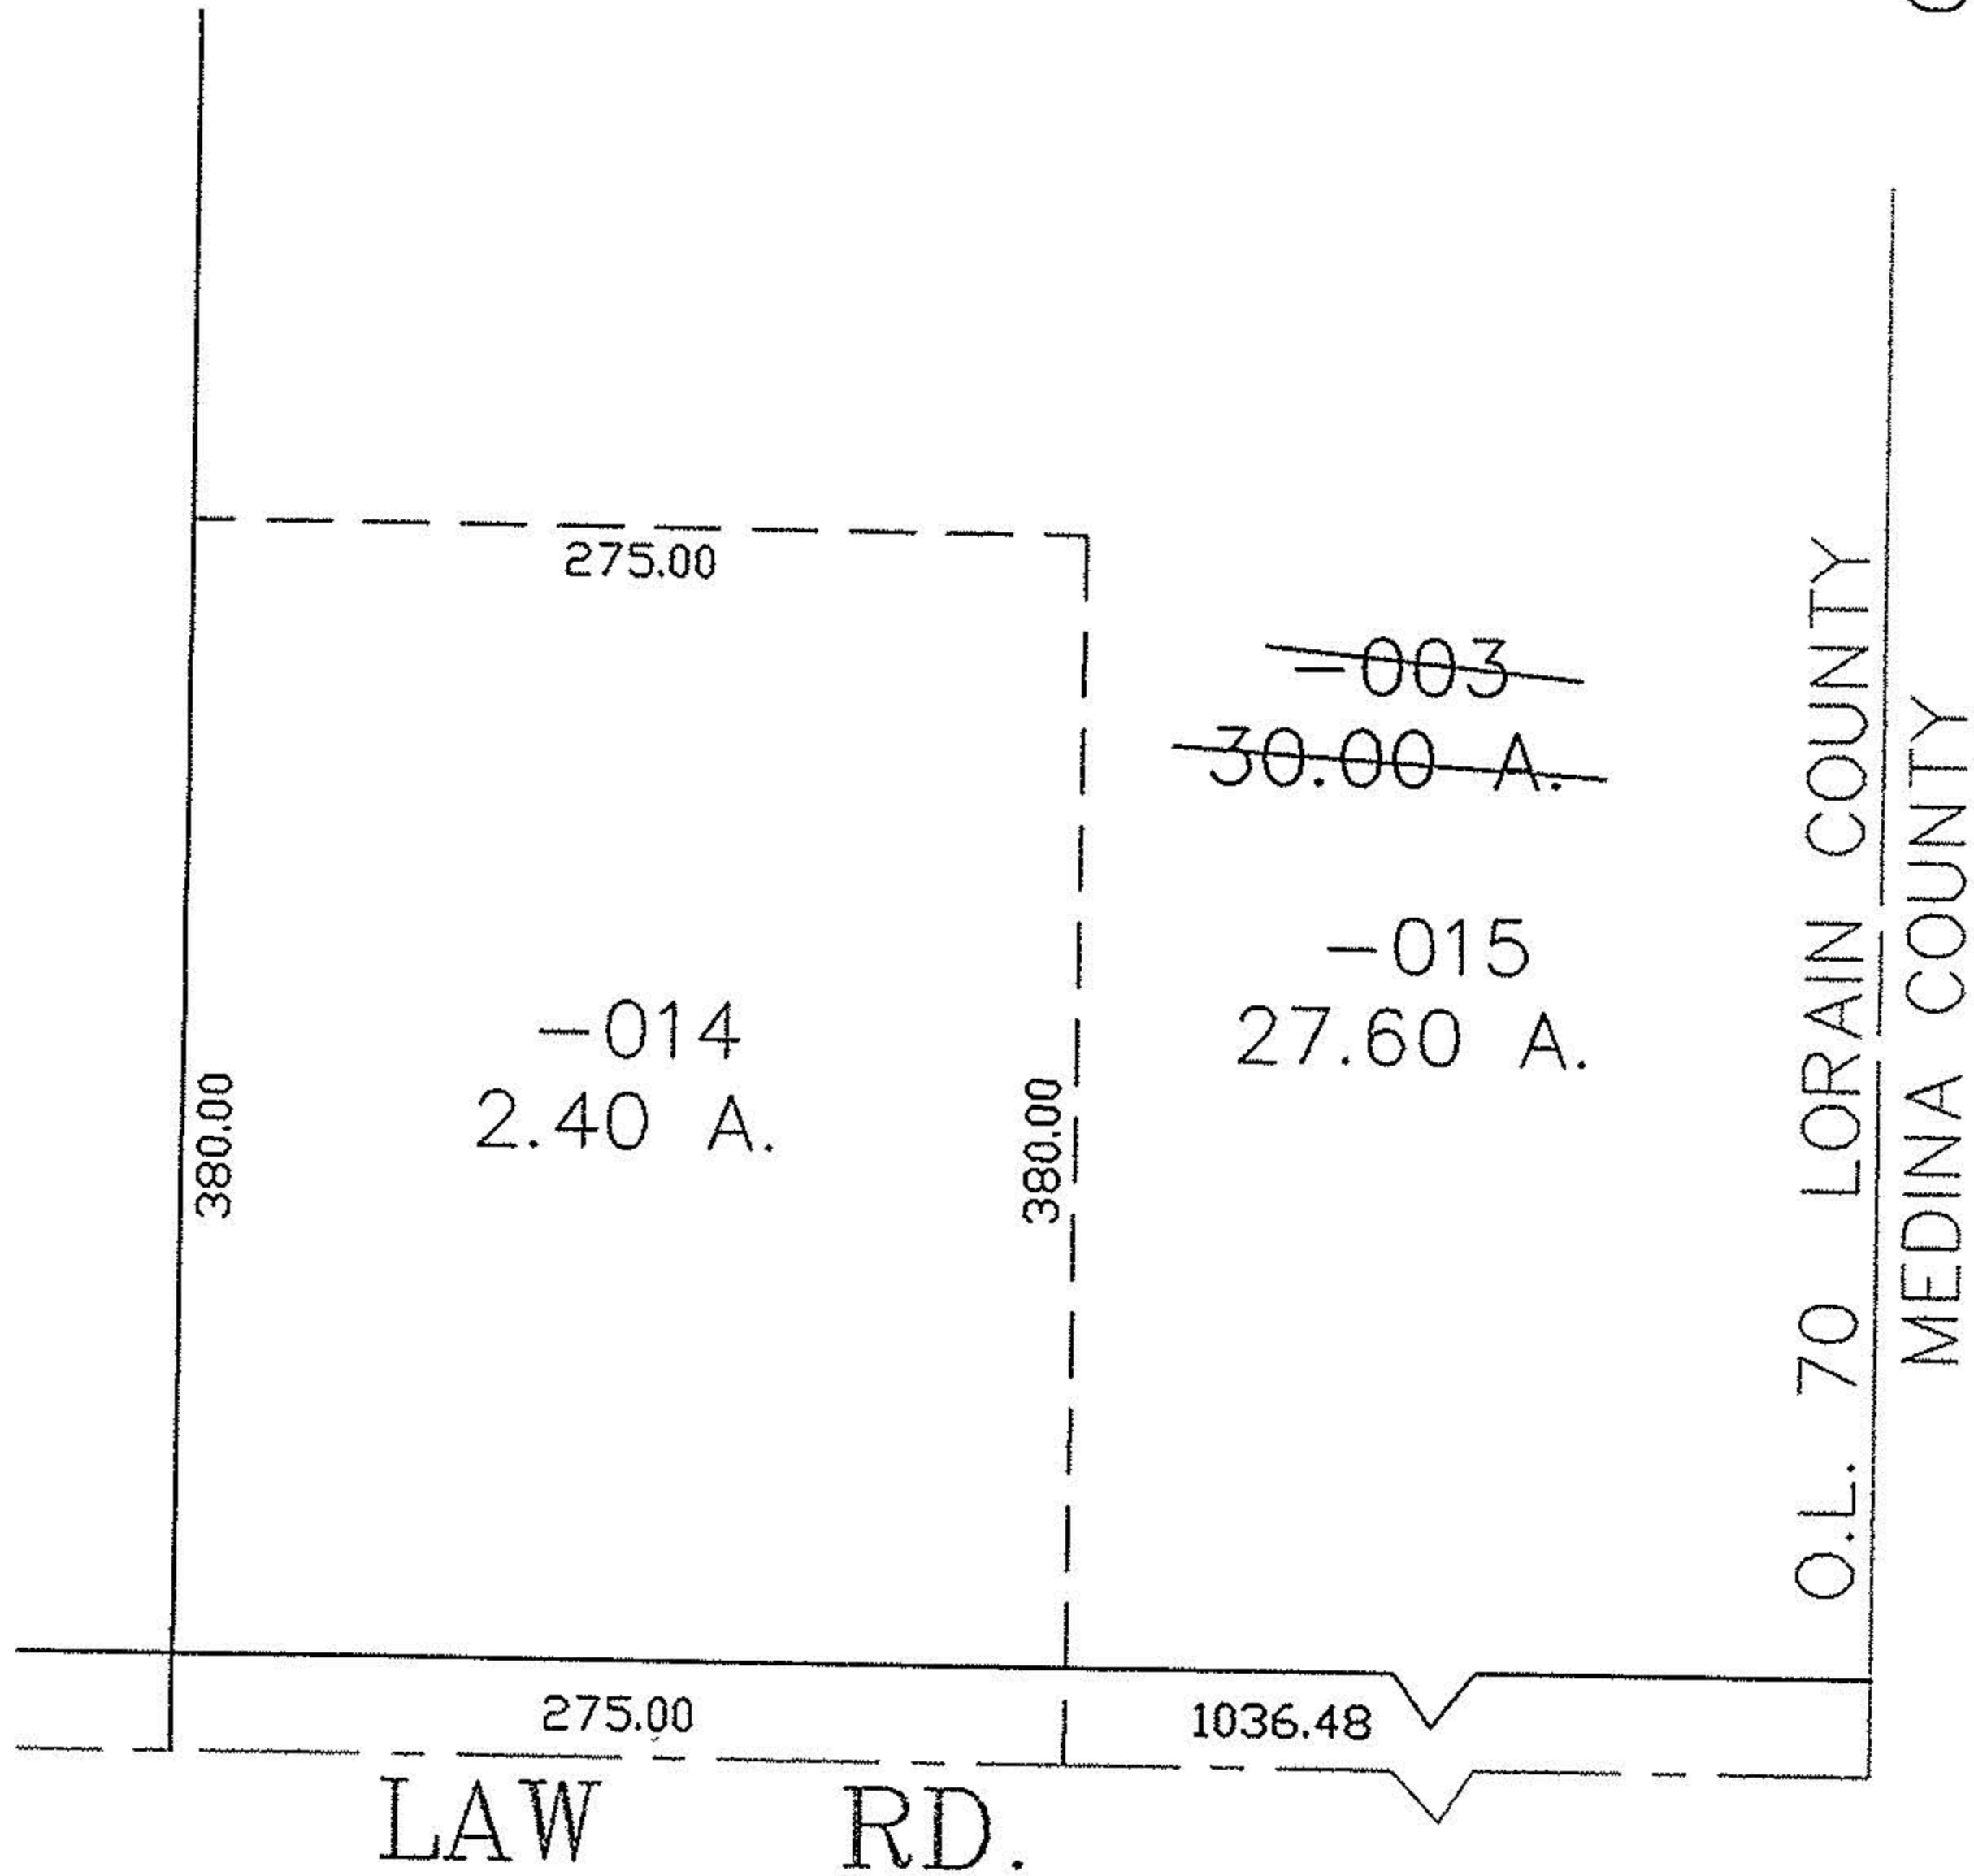


PARENT PARCEL: 16-00-070-000-003

CHILD PARCEL: 16-00-070-000-014, -015

STARTING POINT: CENTERLINE OF LAW RD. & O.L. 70

NO. 01494

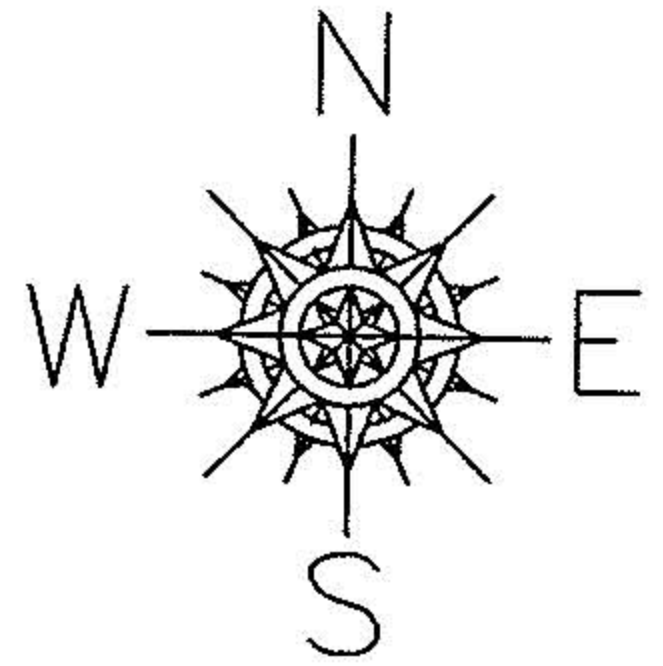

SPLITS/DEEDS PROCESSED

LORAIN COUNTY TAX MAP DEPARTMENT  
226 MIDDLE AVE. ELYRIA, OHIO

SURVEYED BY: RICHARD CARLSON

CLOSURE: 0.00 : 10.000

MAP PAGE(S): 16-00-070-B

APPROVED BY: JAH DATE: 10-16-03

SCALE: 1" = 100 PRIOR INSTRUMENT: DV 1428/576