
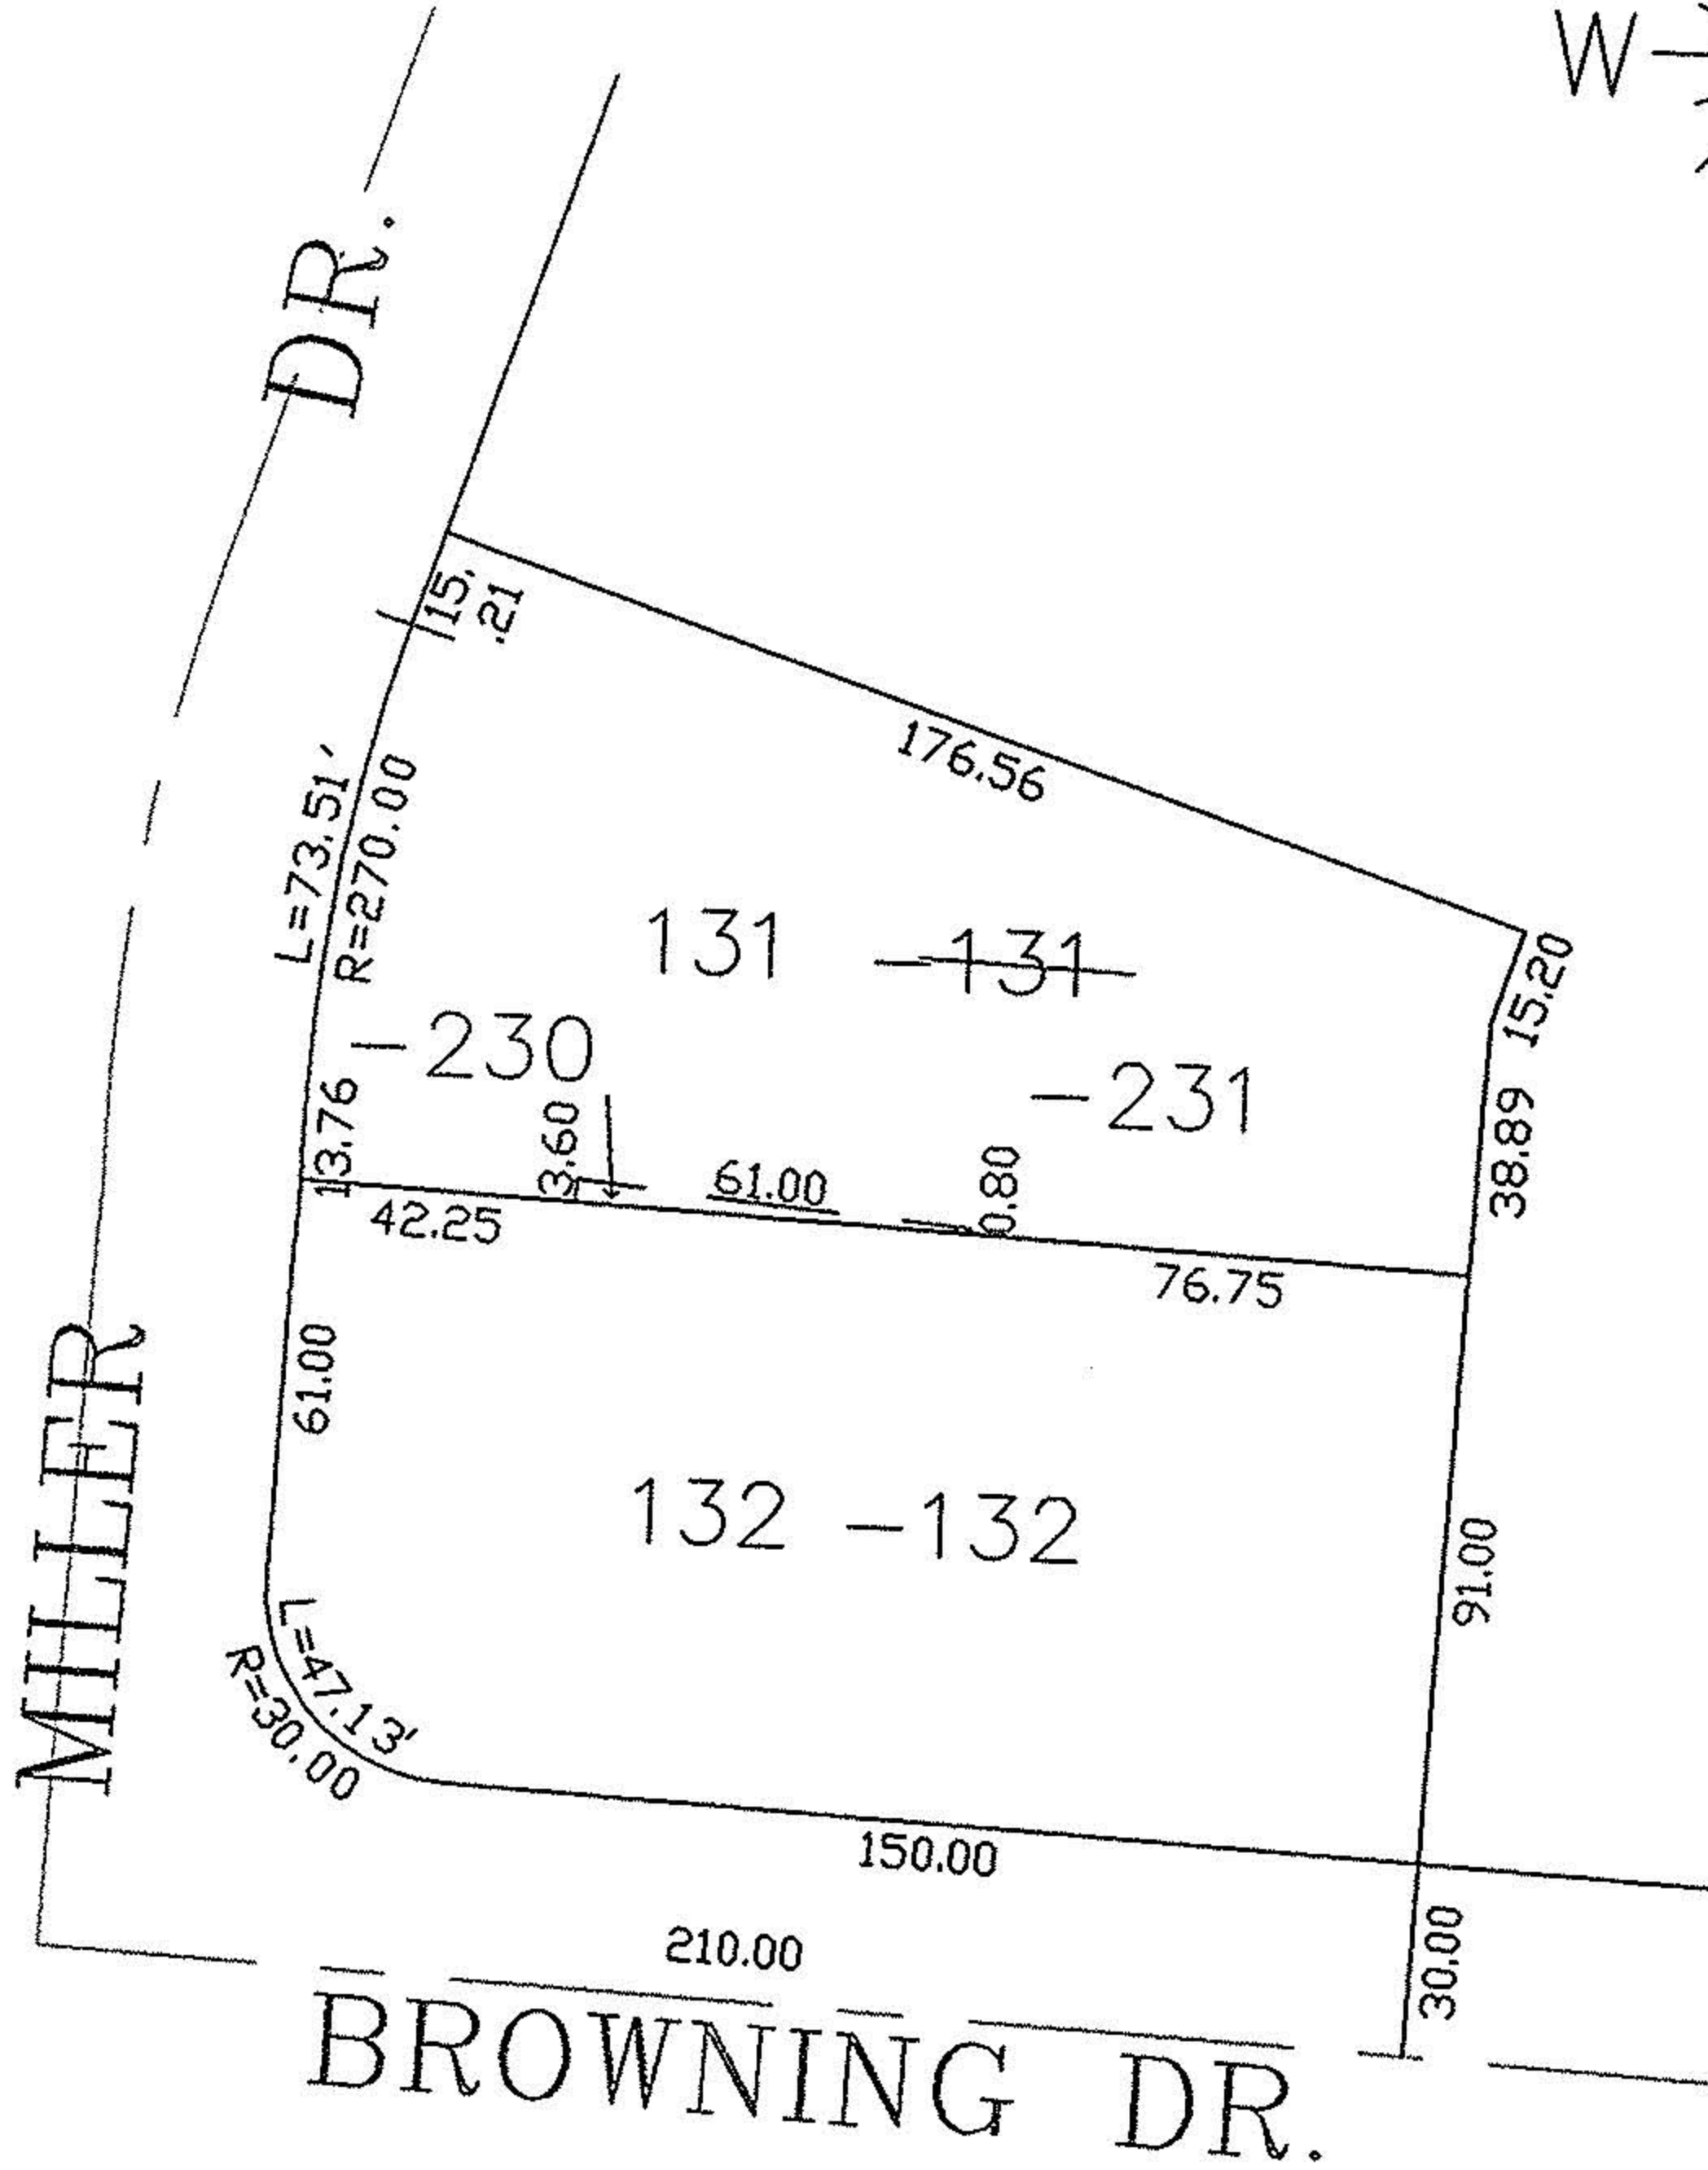


PARENT PARCEL: 07-00-009-120-131


CHILD PARCEL: 07-00-009-120-230, 231

STARTING POINT: CENTERLINE OF BROWNING DR. & MILLER DR.

NO. 01523

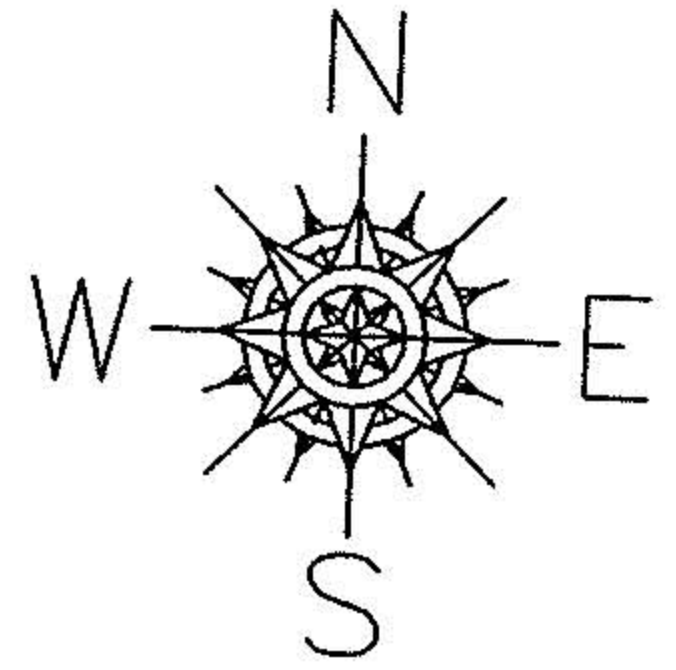

R

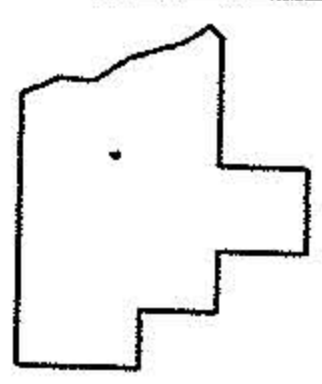

SPLITS/DEEDS PROCESSED

LORAIN COUNTY TAX MAP DEPARTMENT
226 MIDDLE AVE. ELYRIA, OHIO

SURVEYED BY: EDWARD DUDLEY
 CLOSURE: 0.00 : 10.000
 MAP PAGE(S): 7-00-009-C
 APPROVED BY: JAH DATE: 11-21-03
 SCALE: 1" = 100' PRIOR INSTRUMENT: 20010743850