

PORT 2


TENNEY STREET 50'

#22719
APPROVED
LORAIN CO.
MAP DEPT.
 DATE 12-7-98
 PAGE 5-00-037A
 BY *T. Spik*
 VOID AFTER 22719

5/8" CAPPED REBAR SET. 10-15-98

271

JAMES STREET 50'

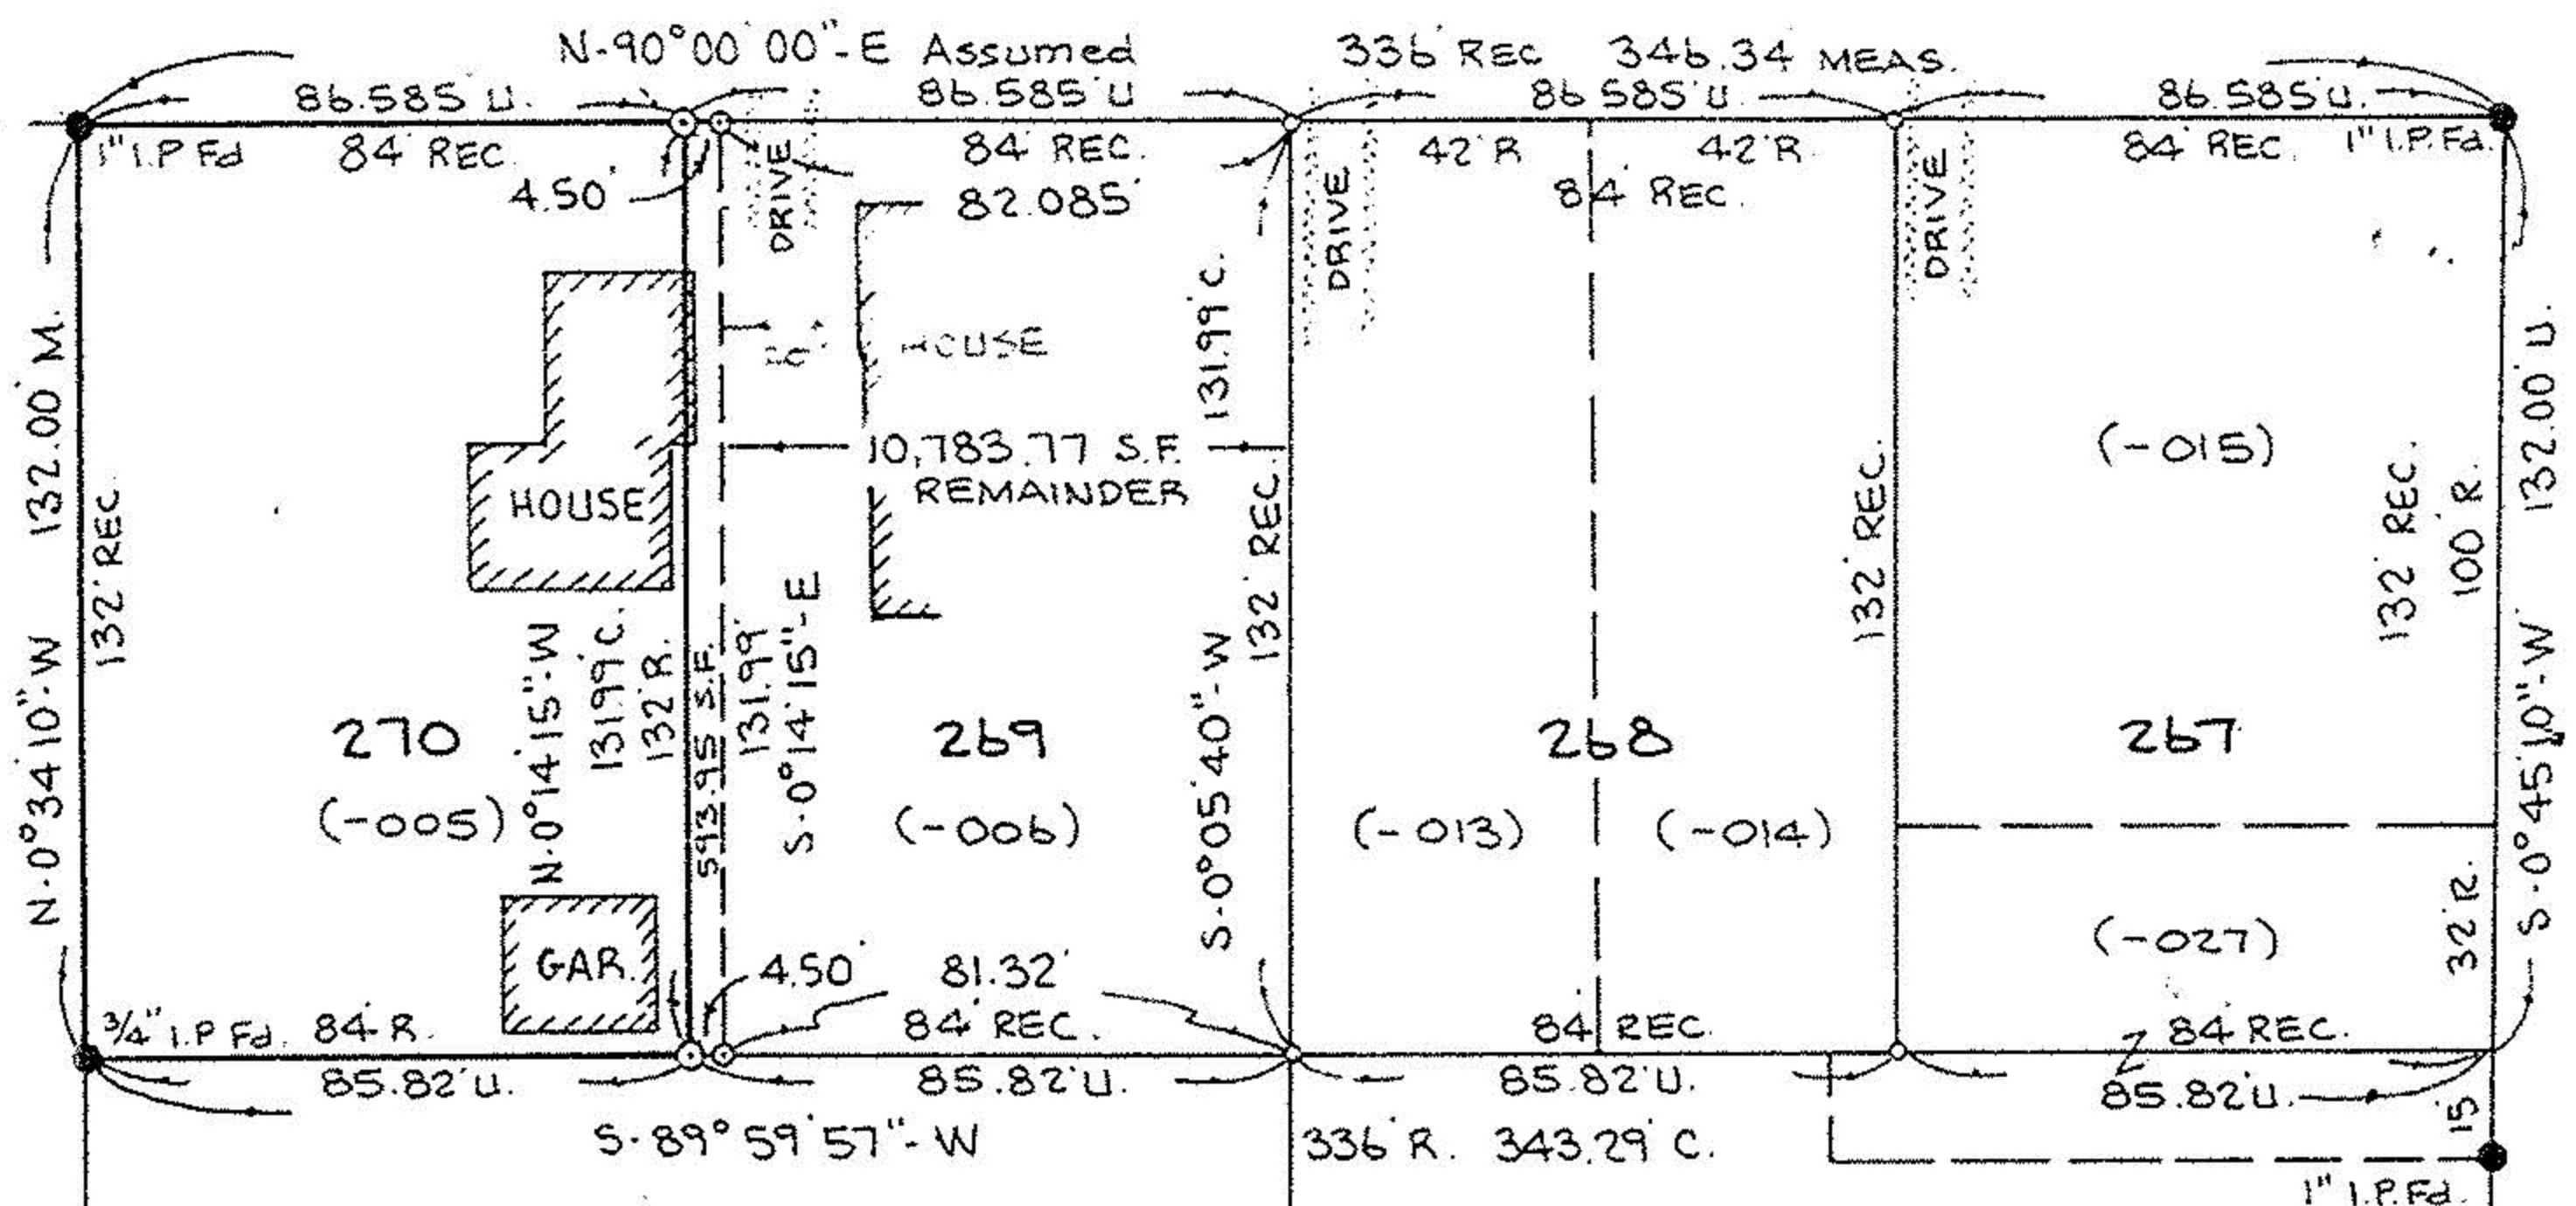

JACKSON STREET 50'

BOUNDARY SURVEY

SUBLOT 270
JAMES JACKSON'S ADDITION
P.V. 2 P. 5
PT. AMHERST TWP. ORIGINAL LOT 37
(CO. PCL. NO. 05-00-037-103-005)
CITY OF AMHERST COUNTY OF LORAIN
STATE OF OHIO


PREPARED BY
KS ASSOCIATES INC.
 ENGINEERS SURVEYORS
 REV. 10-19-98

David L. Elwell
 REG. SURV. NO. 6333
 3-25-98



103

SCALE: 1" = 50'

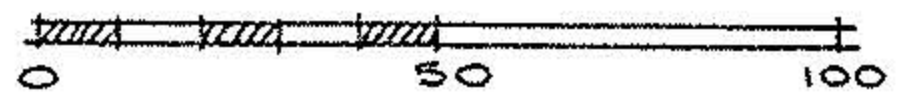

98077