


EXHIBIT C-2



SUBJECT PARCEL  
CLAIMED BY  
RINGWALL  
6 PP

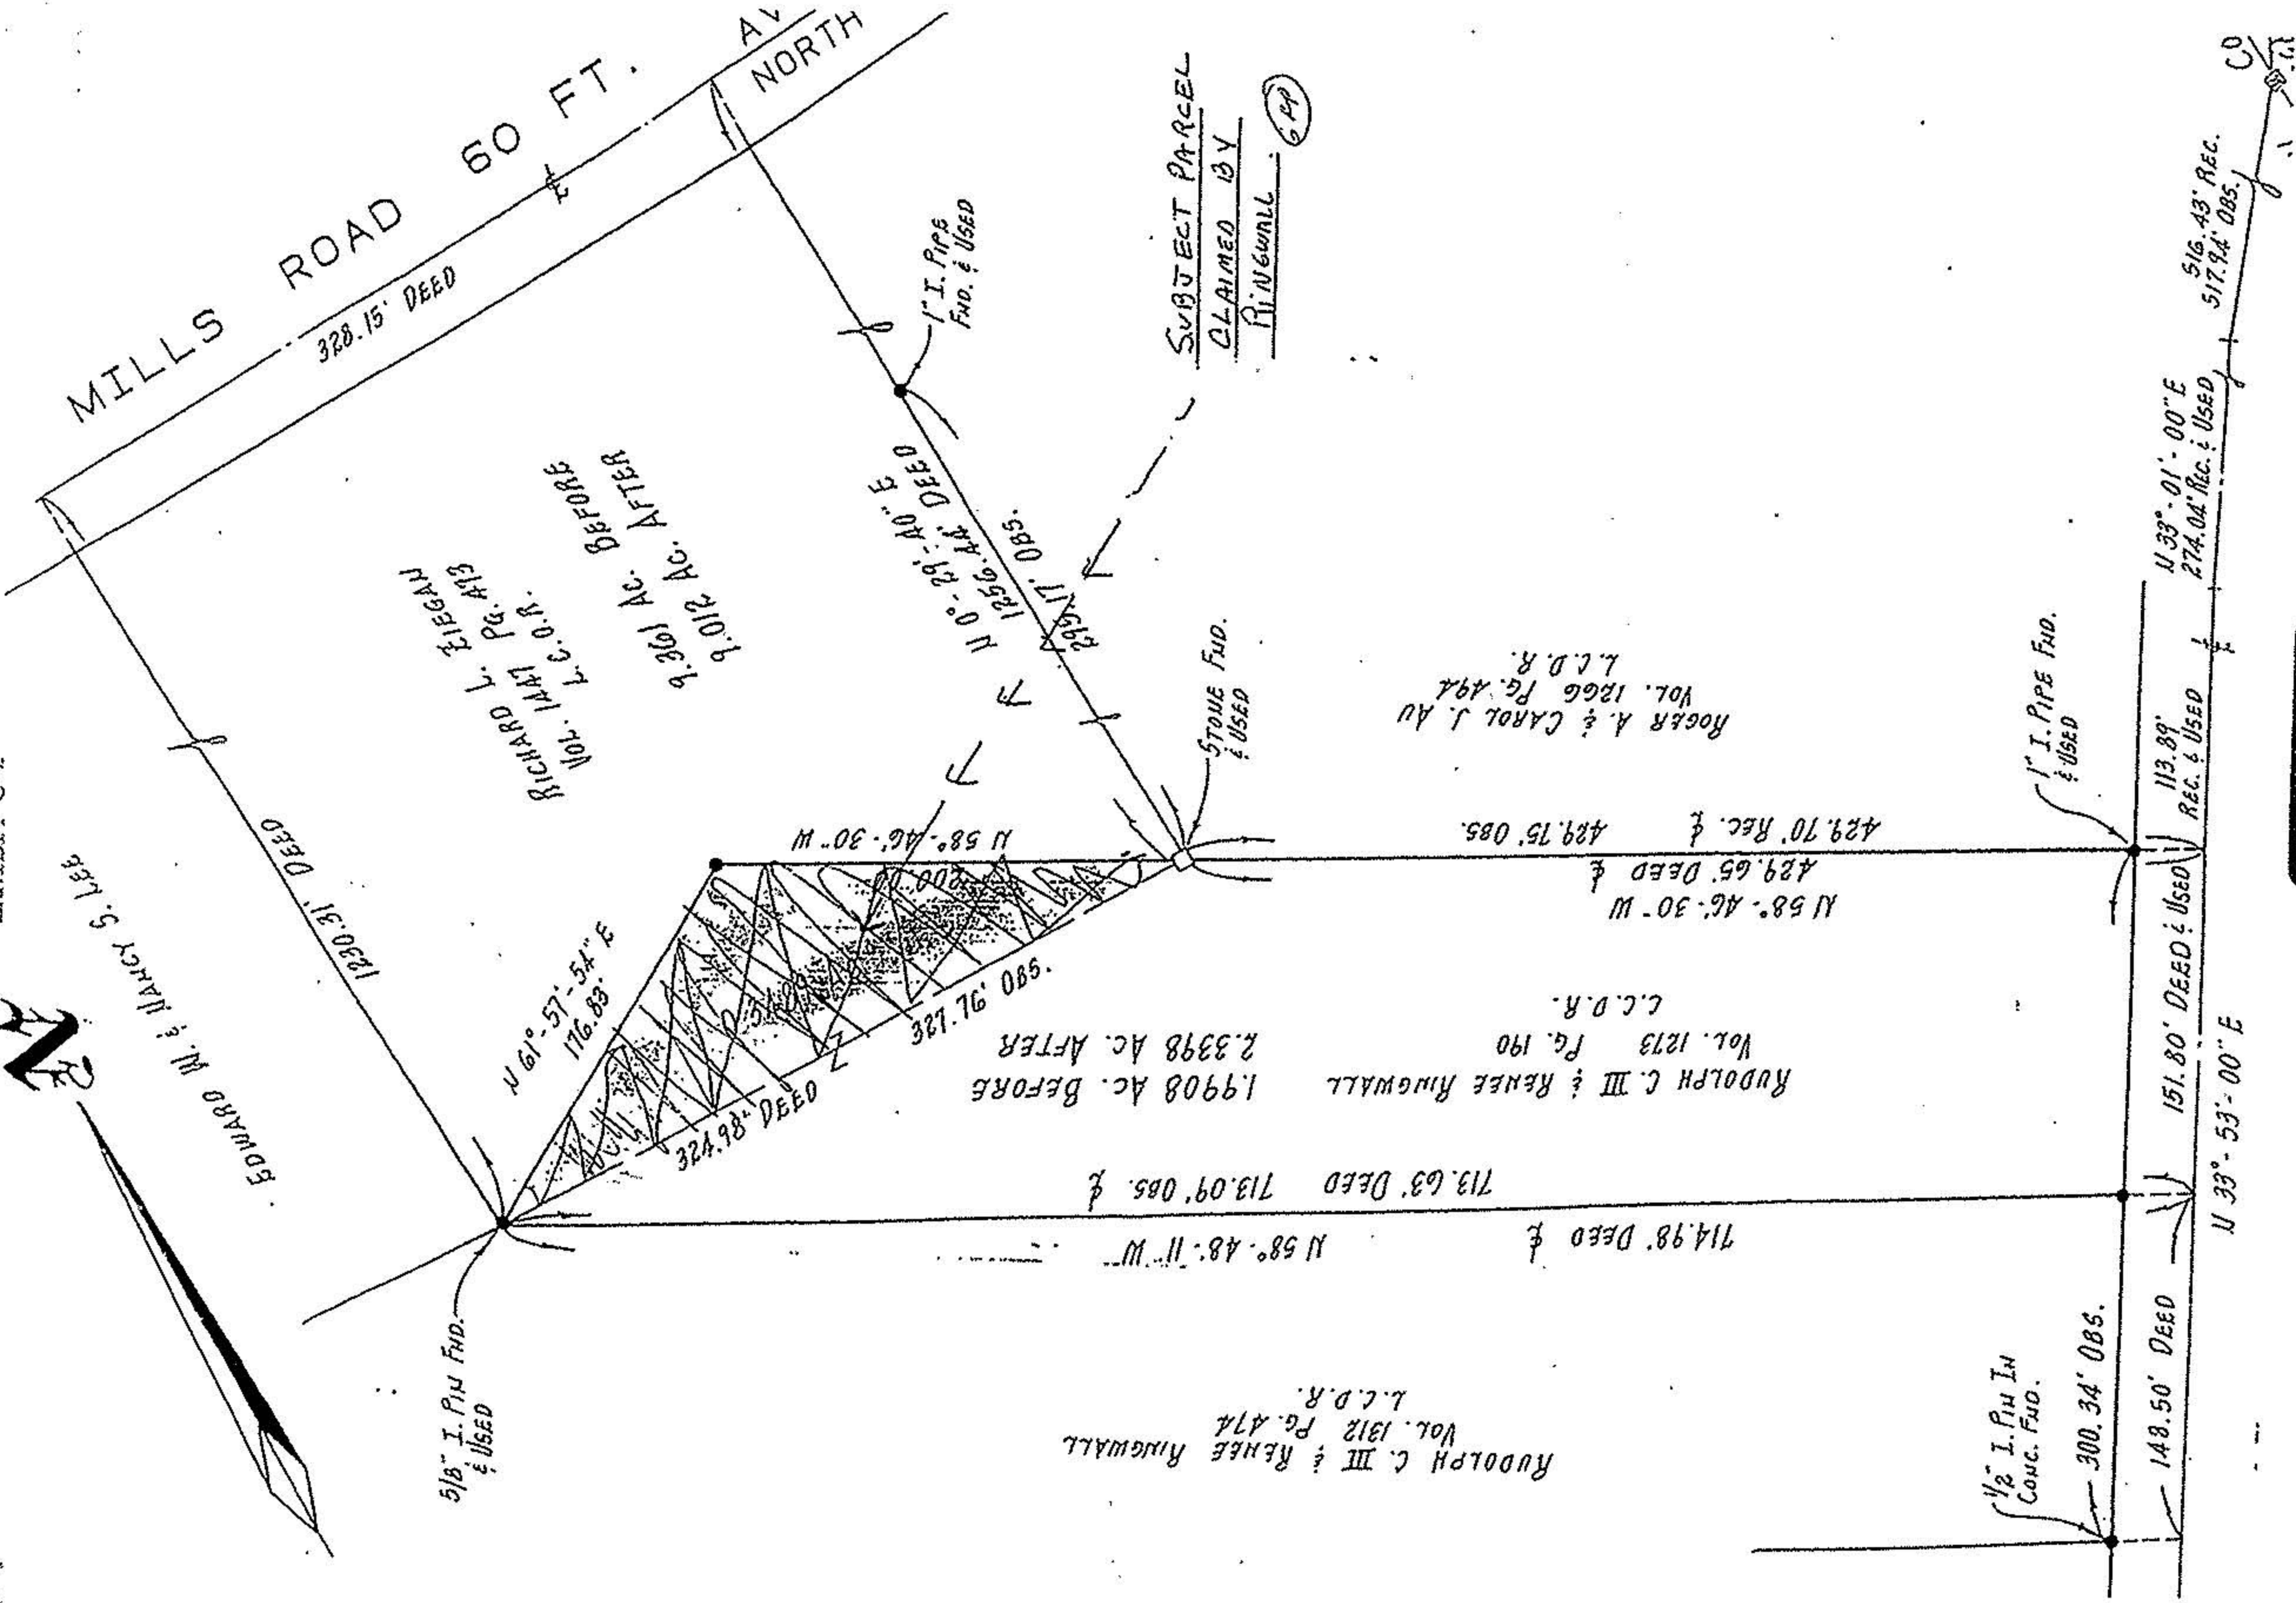