
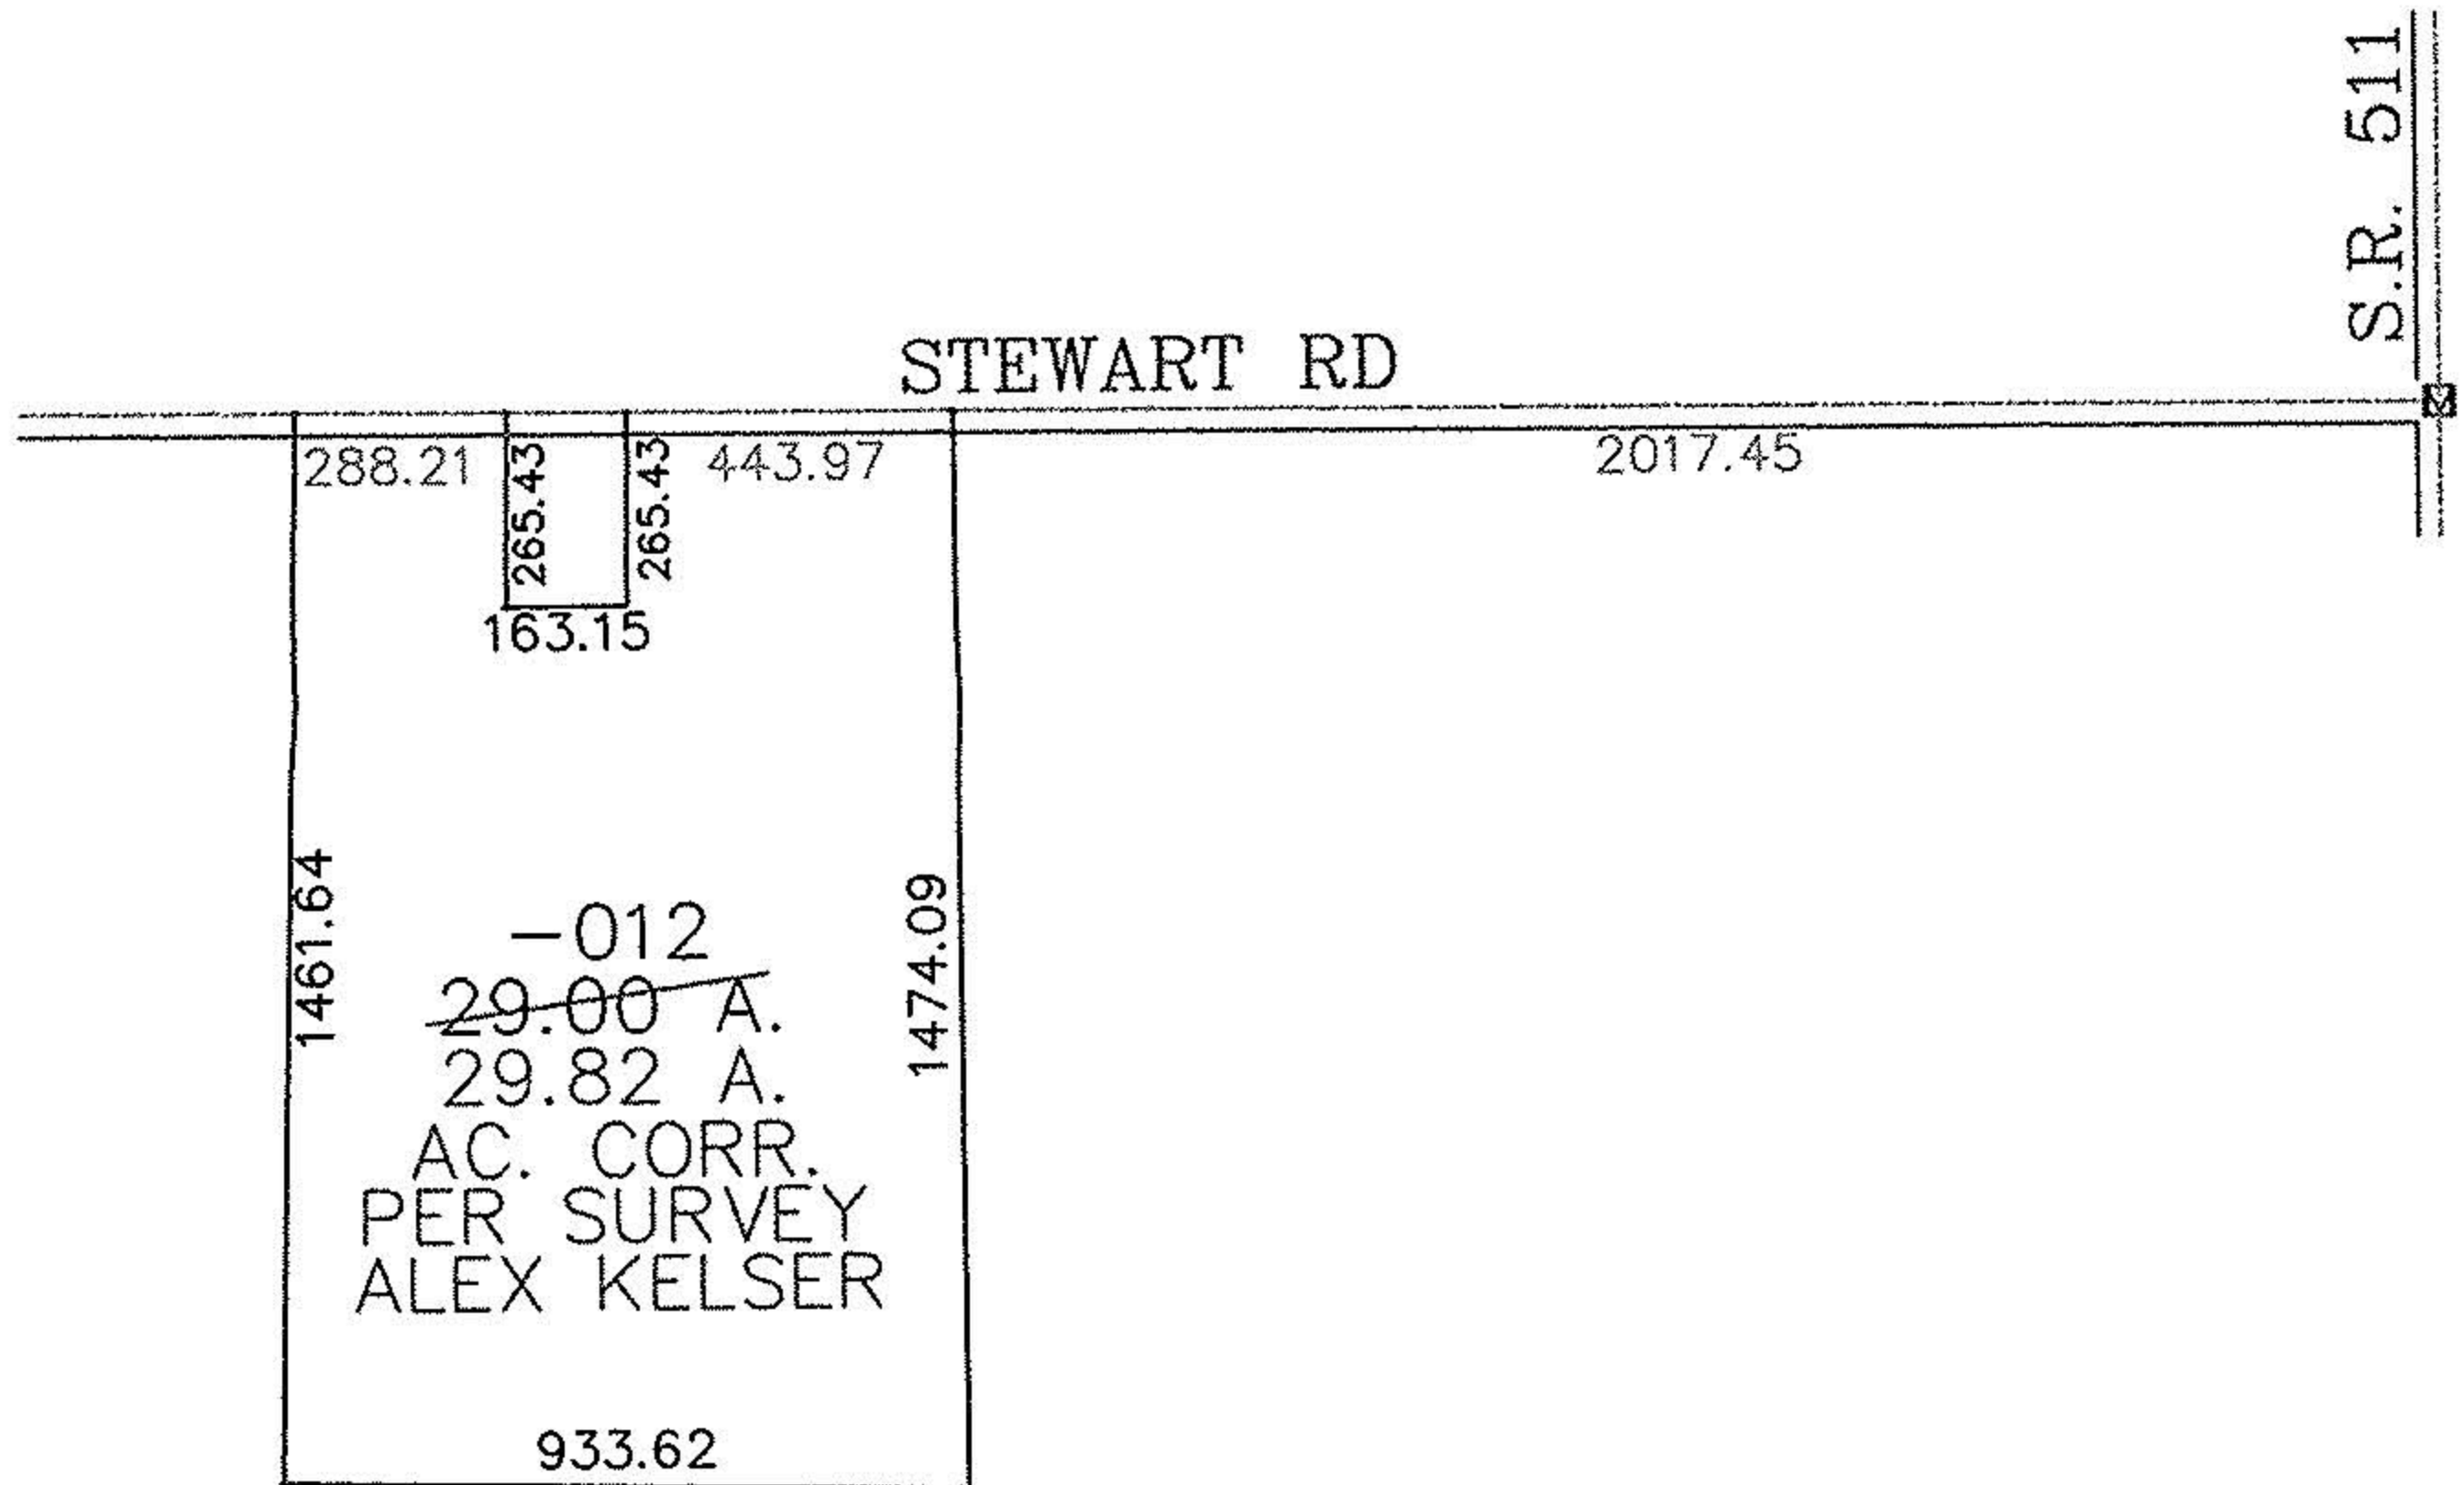


PARENT PARCEL: 20-03-002-000-012

CHILD PARCEL: SAME

STARTING POINT: INT CL STEWART RD AND SR 511

NO. 00883-A

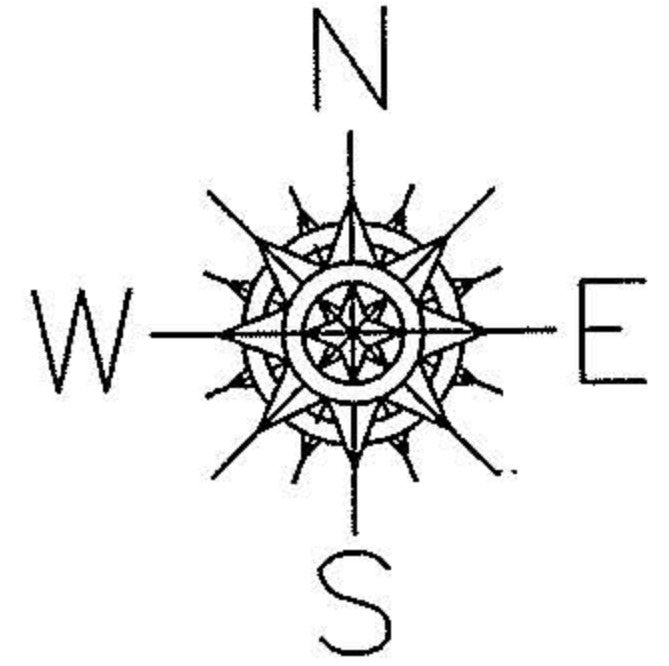

STEWART RD

S.R. 511

288.21

265.43

265.43

443.97

2017.45


163.15

1461.64

-012  
~~29.00~~ A.  
29.82 A.  
AC. CORR.  
PER SURVEY  
ALEX KELSER

1474.09

933.62

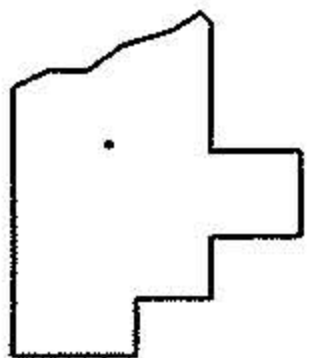

SPLITS/DEEDS PROCESSED

LORAIN COUNTY TAX MAP DEPARTMENT  
226 MIDDLE AVE. ELYRIA, OHIO

SURVEYED BY: ALEX KELSER

CLOSURE: 0:00

MAP PAGE(S): 20-G

APPROVED BY: DRH DATE: 7/21/2003

SCALE: 1" = 500 PRIOR INSTRUMENT: DV 516/403