
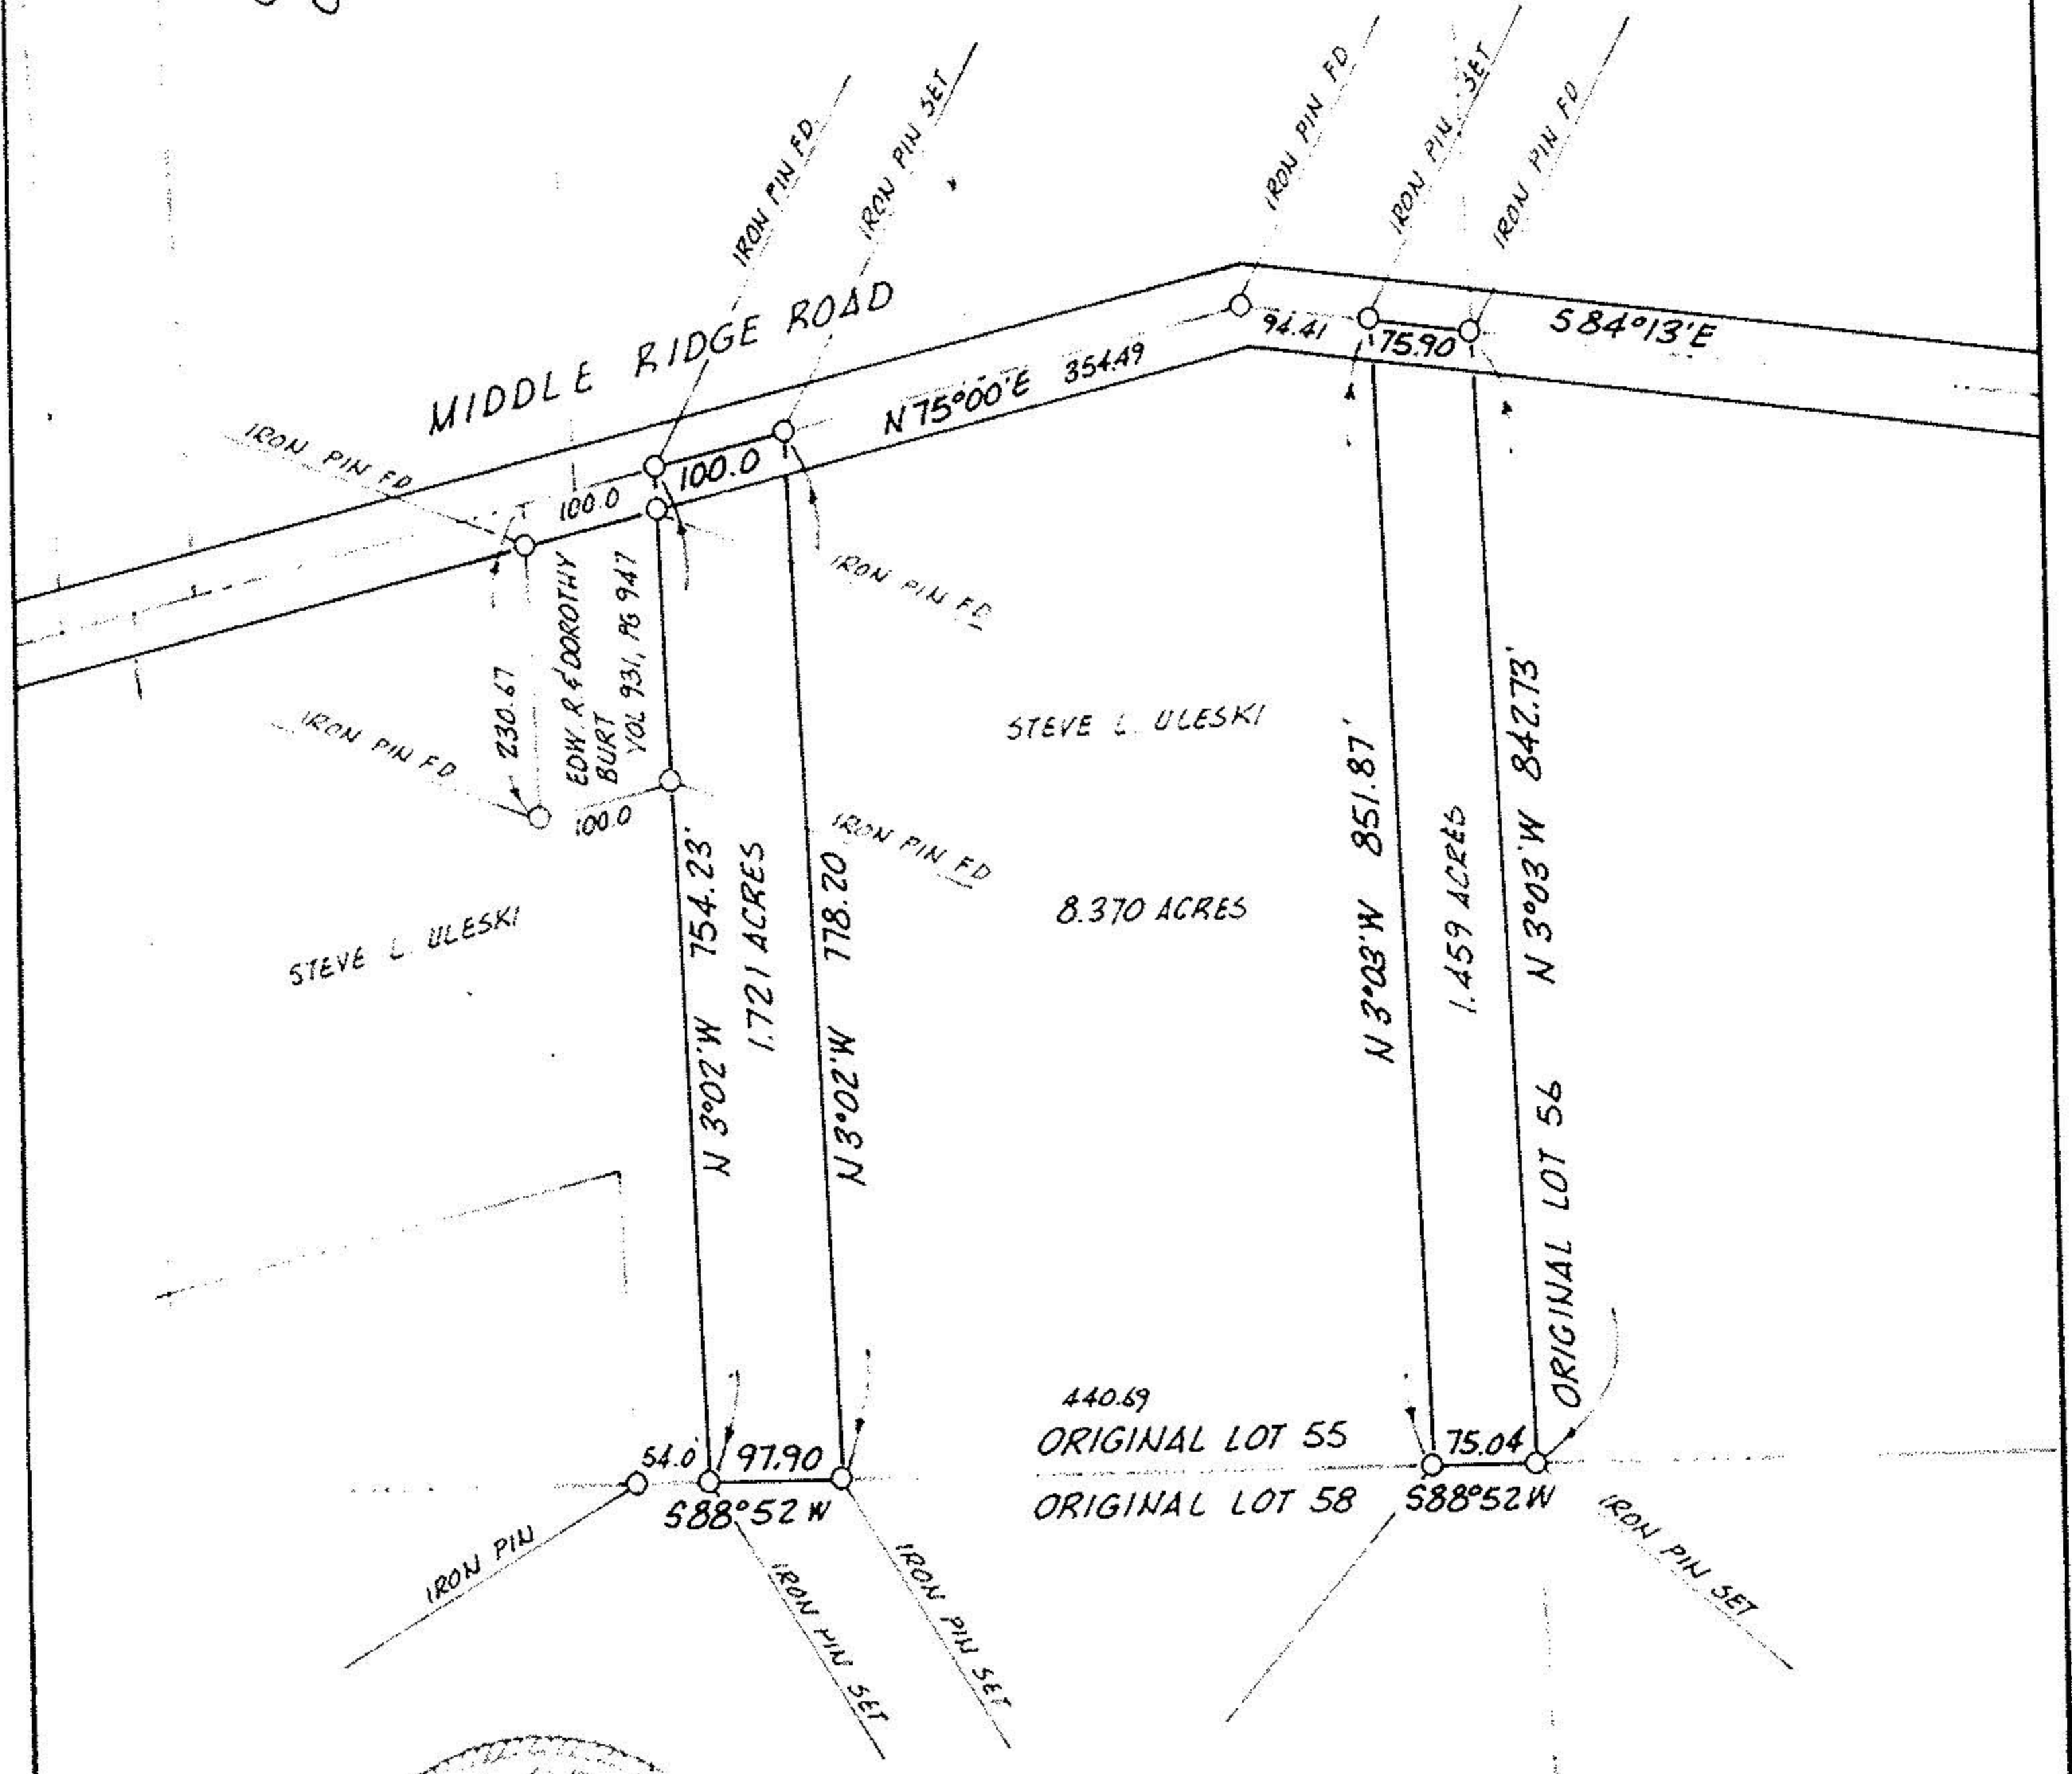


01-00-055-000-020  
 01-00-055-000-022  
 01-00-055-000-024  
 01-00-055-000-028  
 01-00-055-000-029  
 1-L

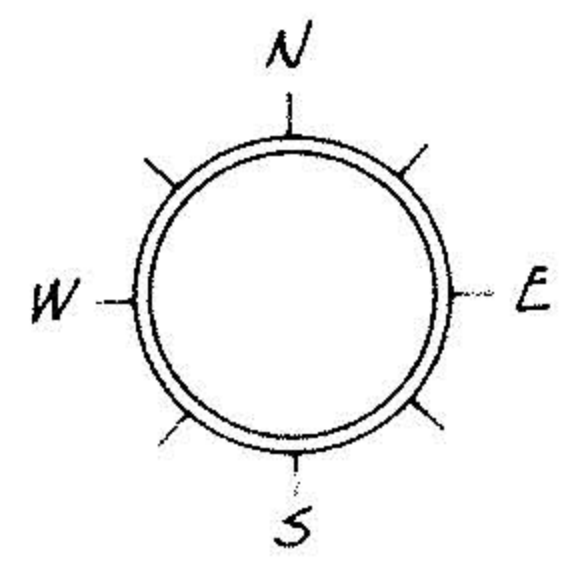

acreage 11.550 TOTAL SURVEY

DWG No.	<b>PERIMETER SURVEY</b>		<b>MICHAEL G. HURA</b> REGISTERED SURVEYOR 199 PARK AVENUE AMHERST, OHIO 44001
	Sublot _____ of _____	Vol. _____ Page _____	
	Part of O.L. <u>55</u> Sect. _____ Tr. _____		drawn MGH
	City of _____		date 4-18-74
	<u>BROWNHELM</u> Twp. <u>LORAIN</u> Co.		scale 1"=200'