
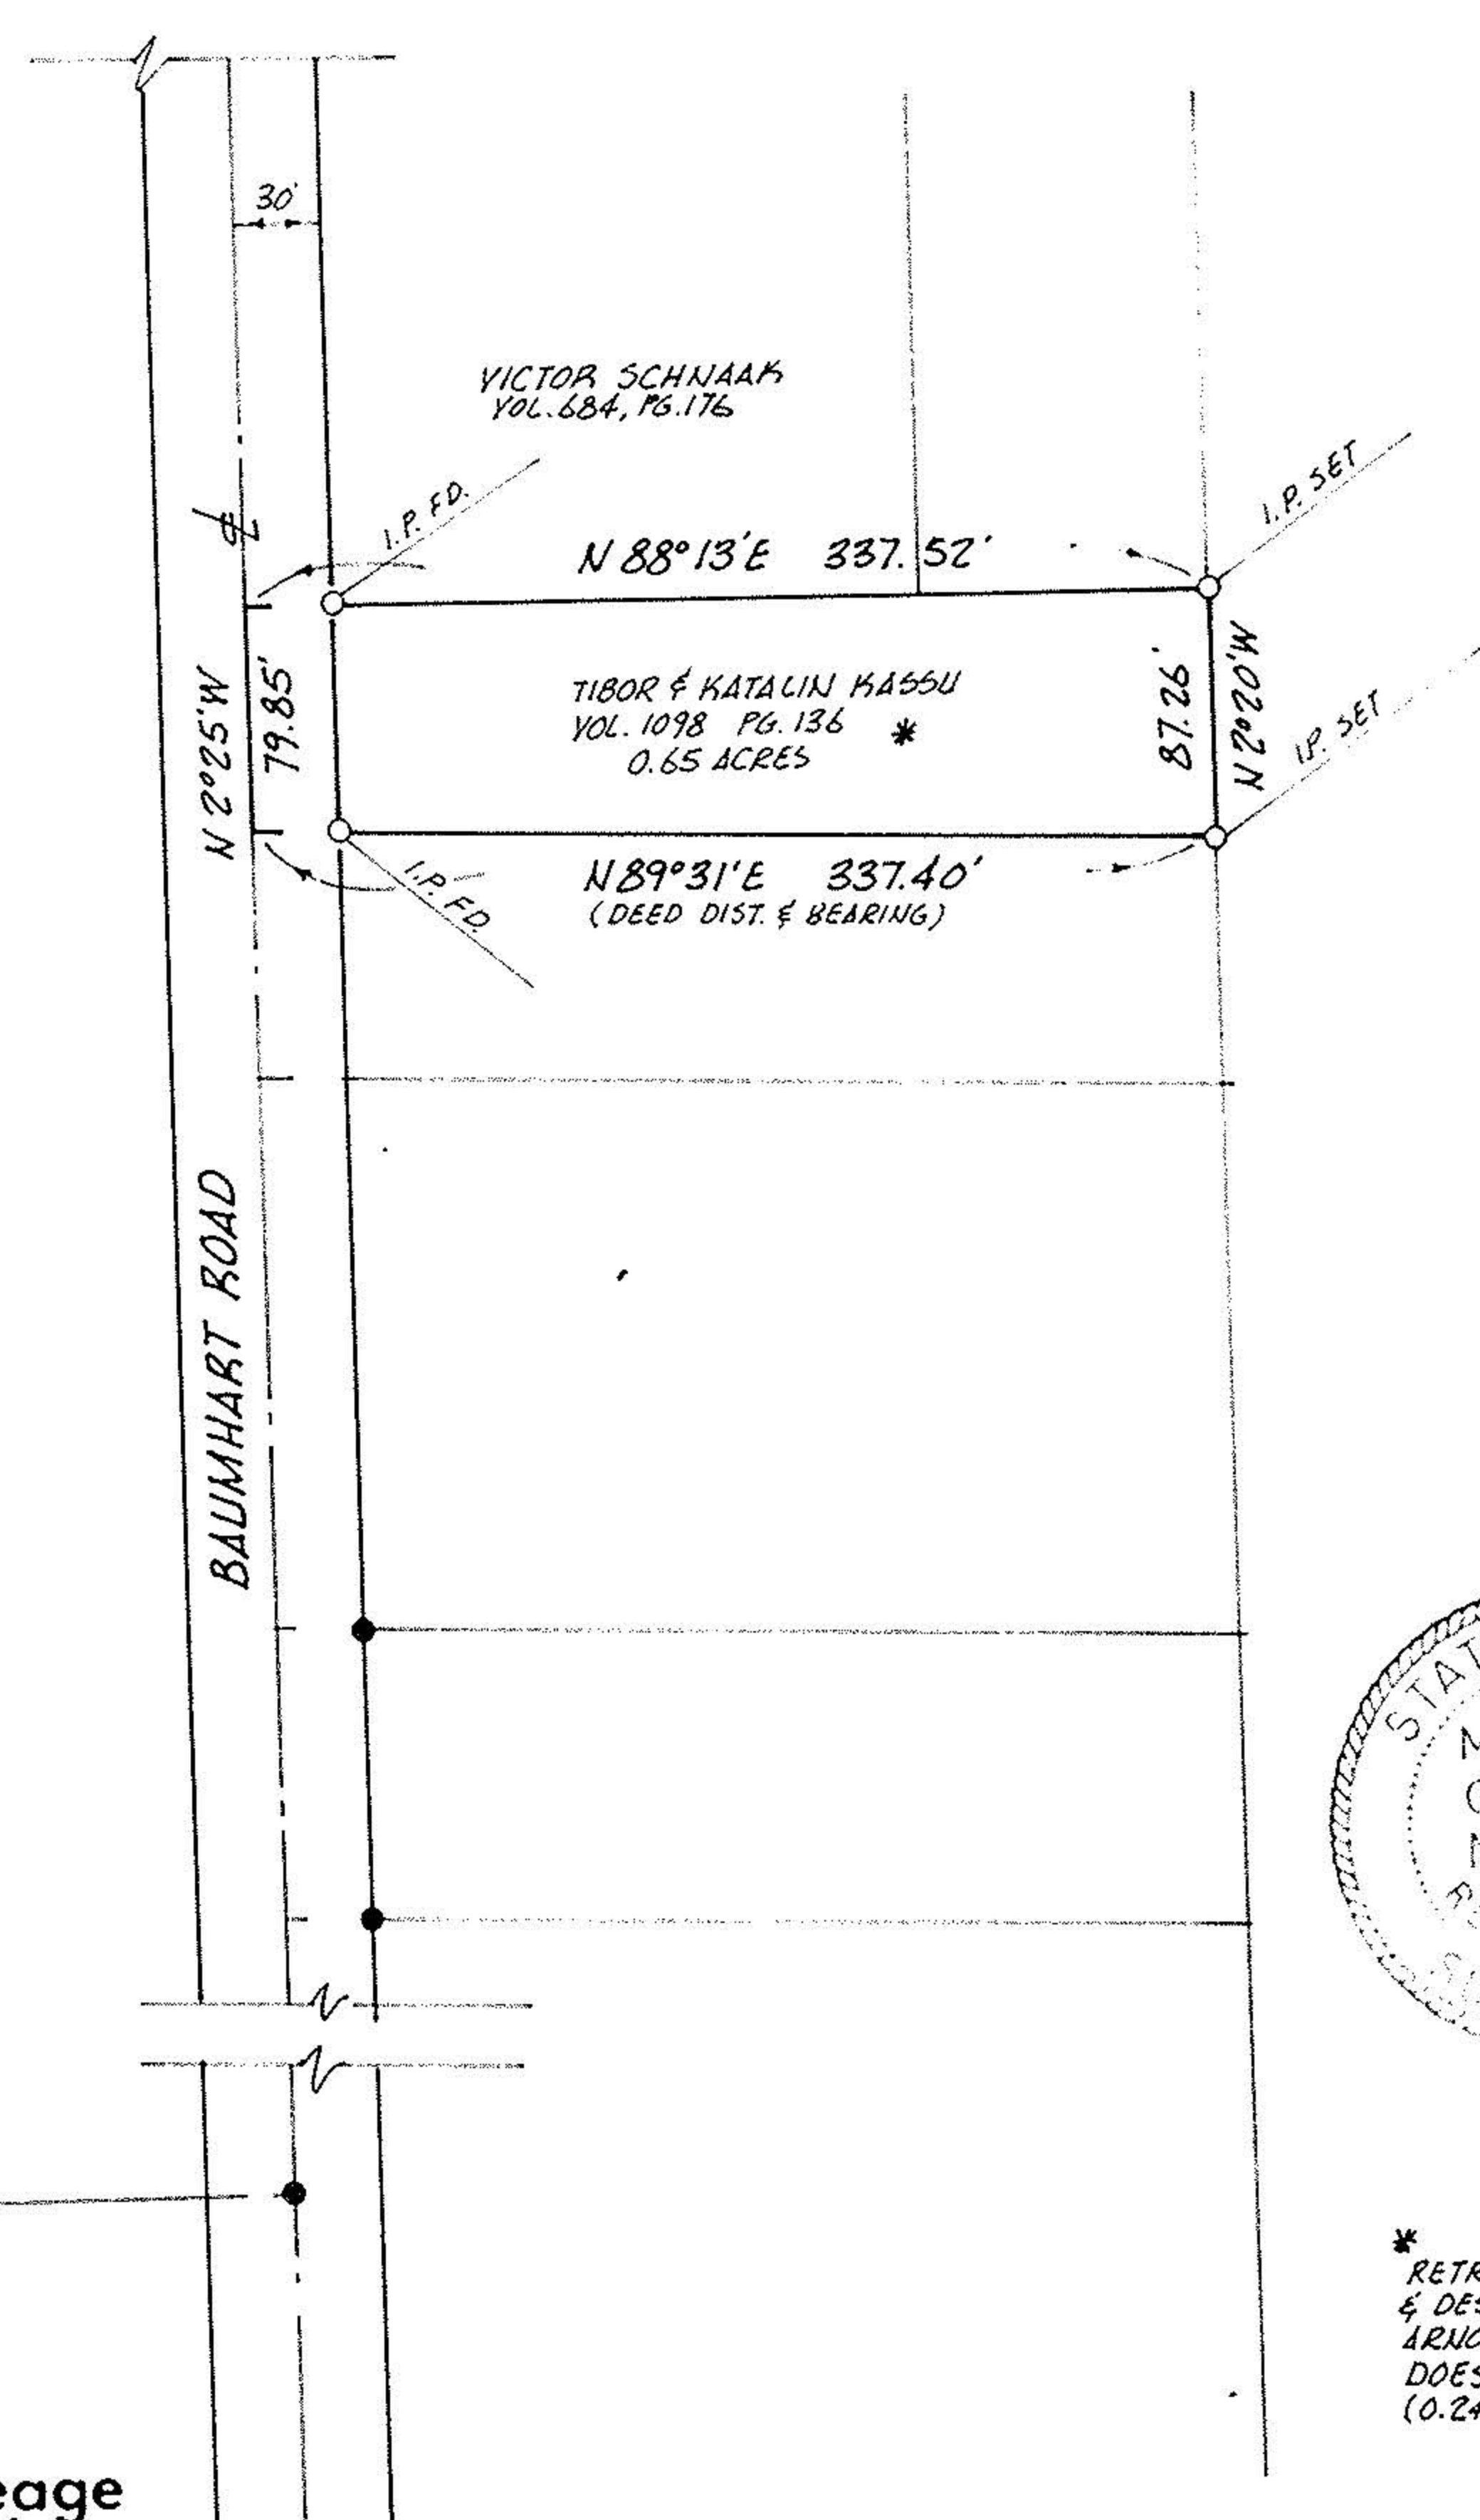


01-00-042-000-009  
1-00-042-A

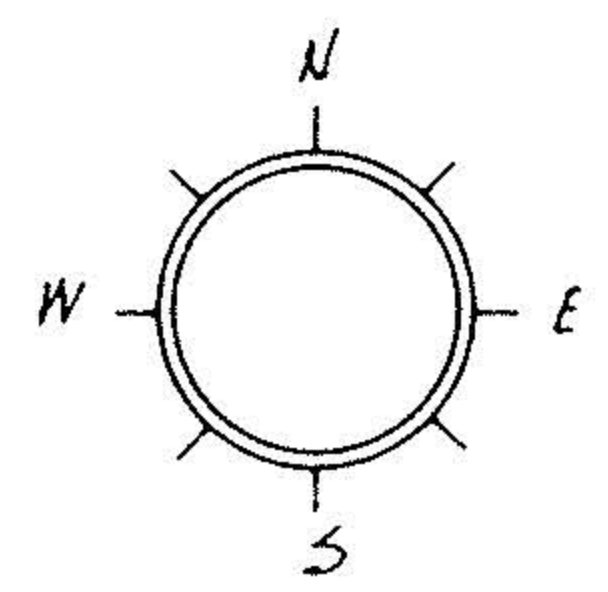

\* RETRACE OF SURVEY  
& DESCRIPTION BY  
ARNOLD F. KOEPP  
DOES NOT BALANCE  
(0.24'-N-S, 0.15'-E-W)

acreage

DWG No.	<b>PERIMETER SURVEY</b>		<b>MICHAEL G. HURA</b> REGISTERED SURVEYOR	
	Sublot _____ of _____		199 PARK AVENUE	
	Vol. _____ Page _____		AMHERST, OHIO 44001	
	Part of O.L. 42 Sect. _____ Tr. _____		drawn MGH	
	City of _____		date 4-18-74	
	BROWNHELM Twp. LORAIN Co.		scale 1" = 100'	