


14-00-080

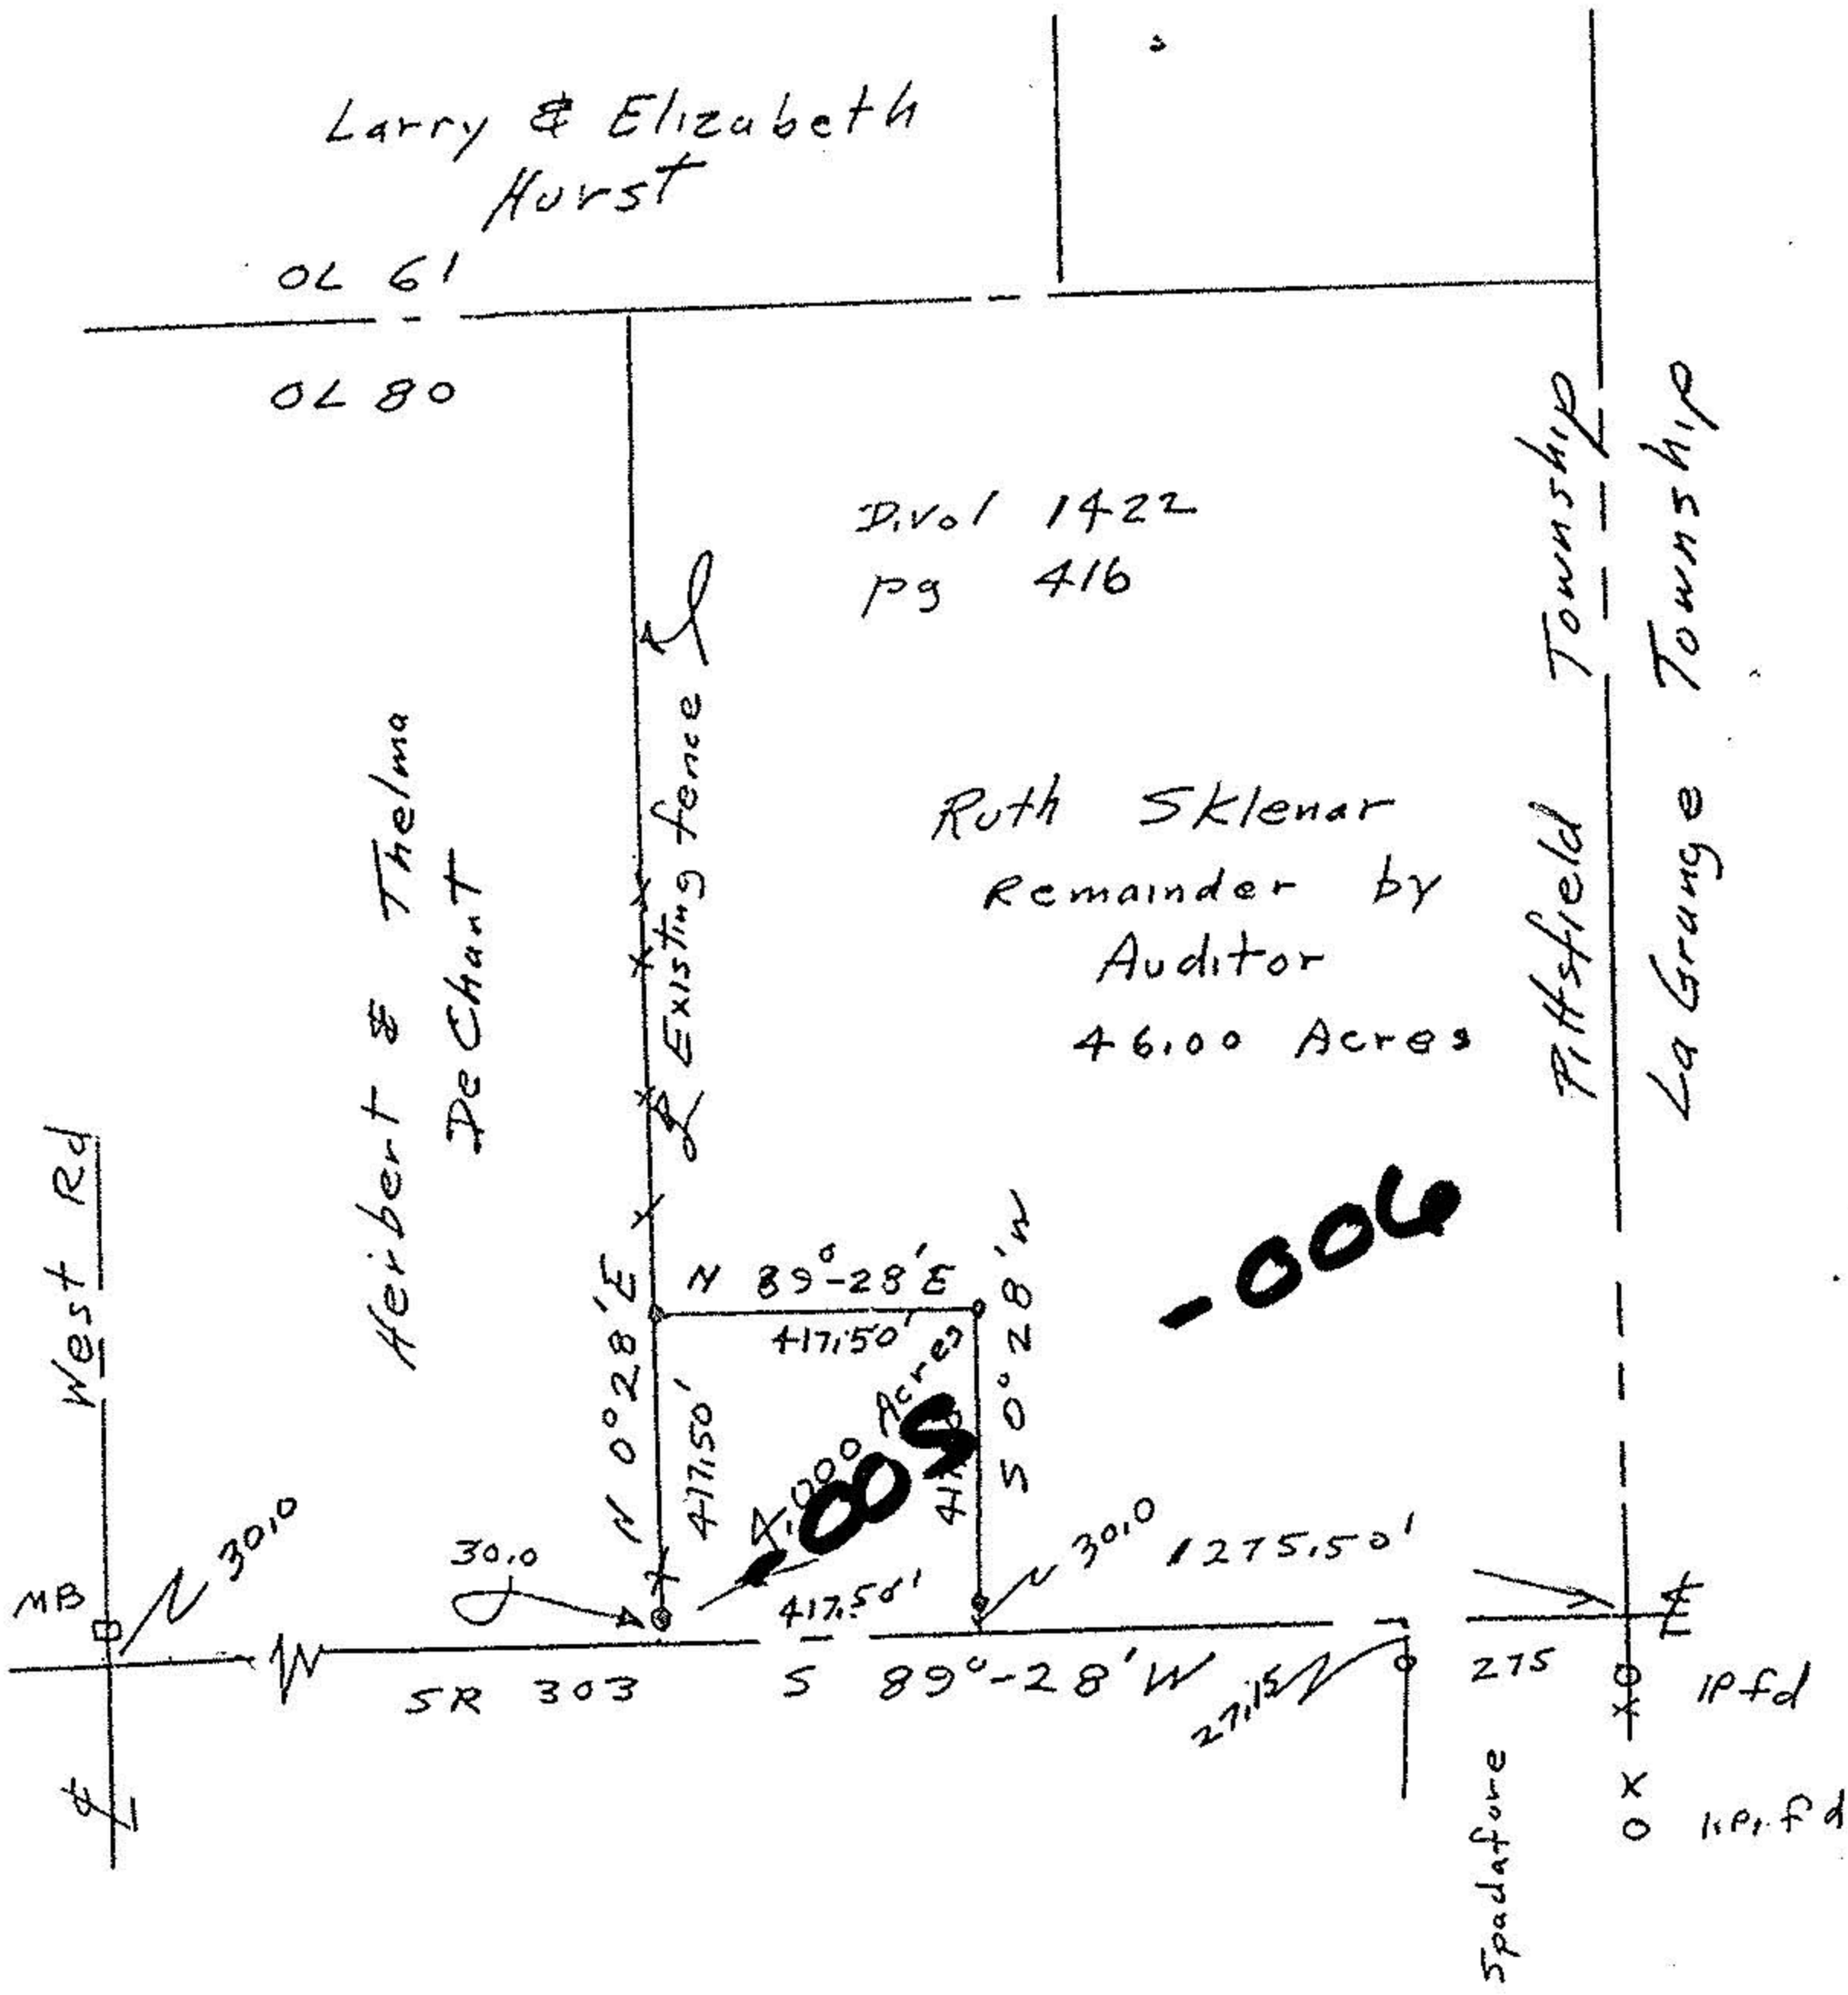

- MB w/1P
- Iron pipe set

John Pozzywak  
Reg Surveyor  
5292

Survey for Pete Sklenar  
four acre parcel split  
part of original Lot 80  
Pittsfield Township  
Lorain County Ohio  
Scale 1" = 400' April 17, 1991  
May 23, 1991