




LAUNDON • SIMON • CAHL & ASSOC., INC.  
 CONSULTING ENGINEERS & SURVEYORS  
 110 MIDDLE AVE. ELYRIA, O. 44035

SURVEY FOR:

J. D. L. MULL FARMS

Orig. Lot 88	City of	Date JULY '94 Scale 1"=200'
Orig. Sec	Village of	Dwn. by R.G.S. Chkd. by R.C.
Tract	County of LORAIN	Job No. 94-2591 F.B.
Township of PITTSFIELD	State of OHIO	Printed

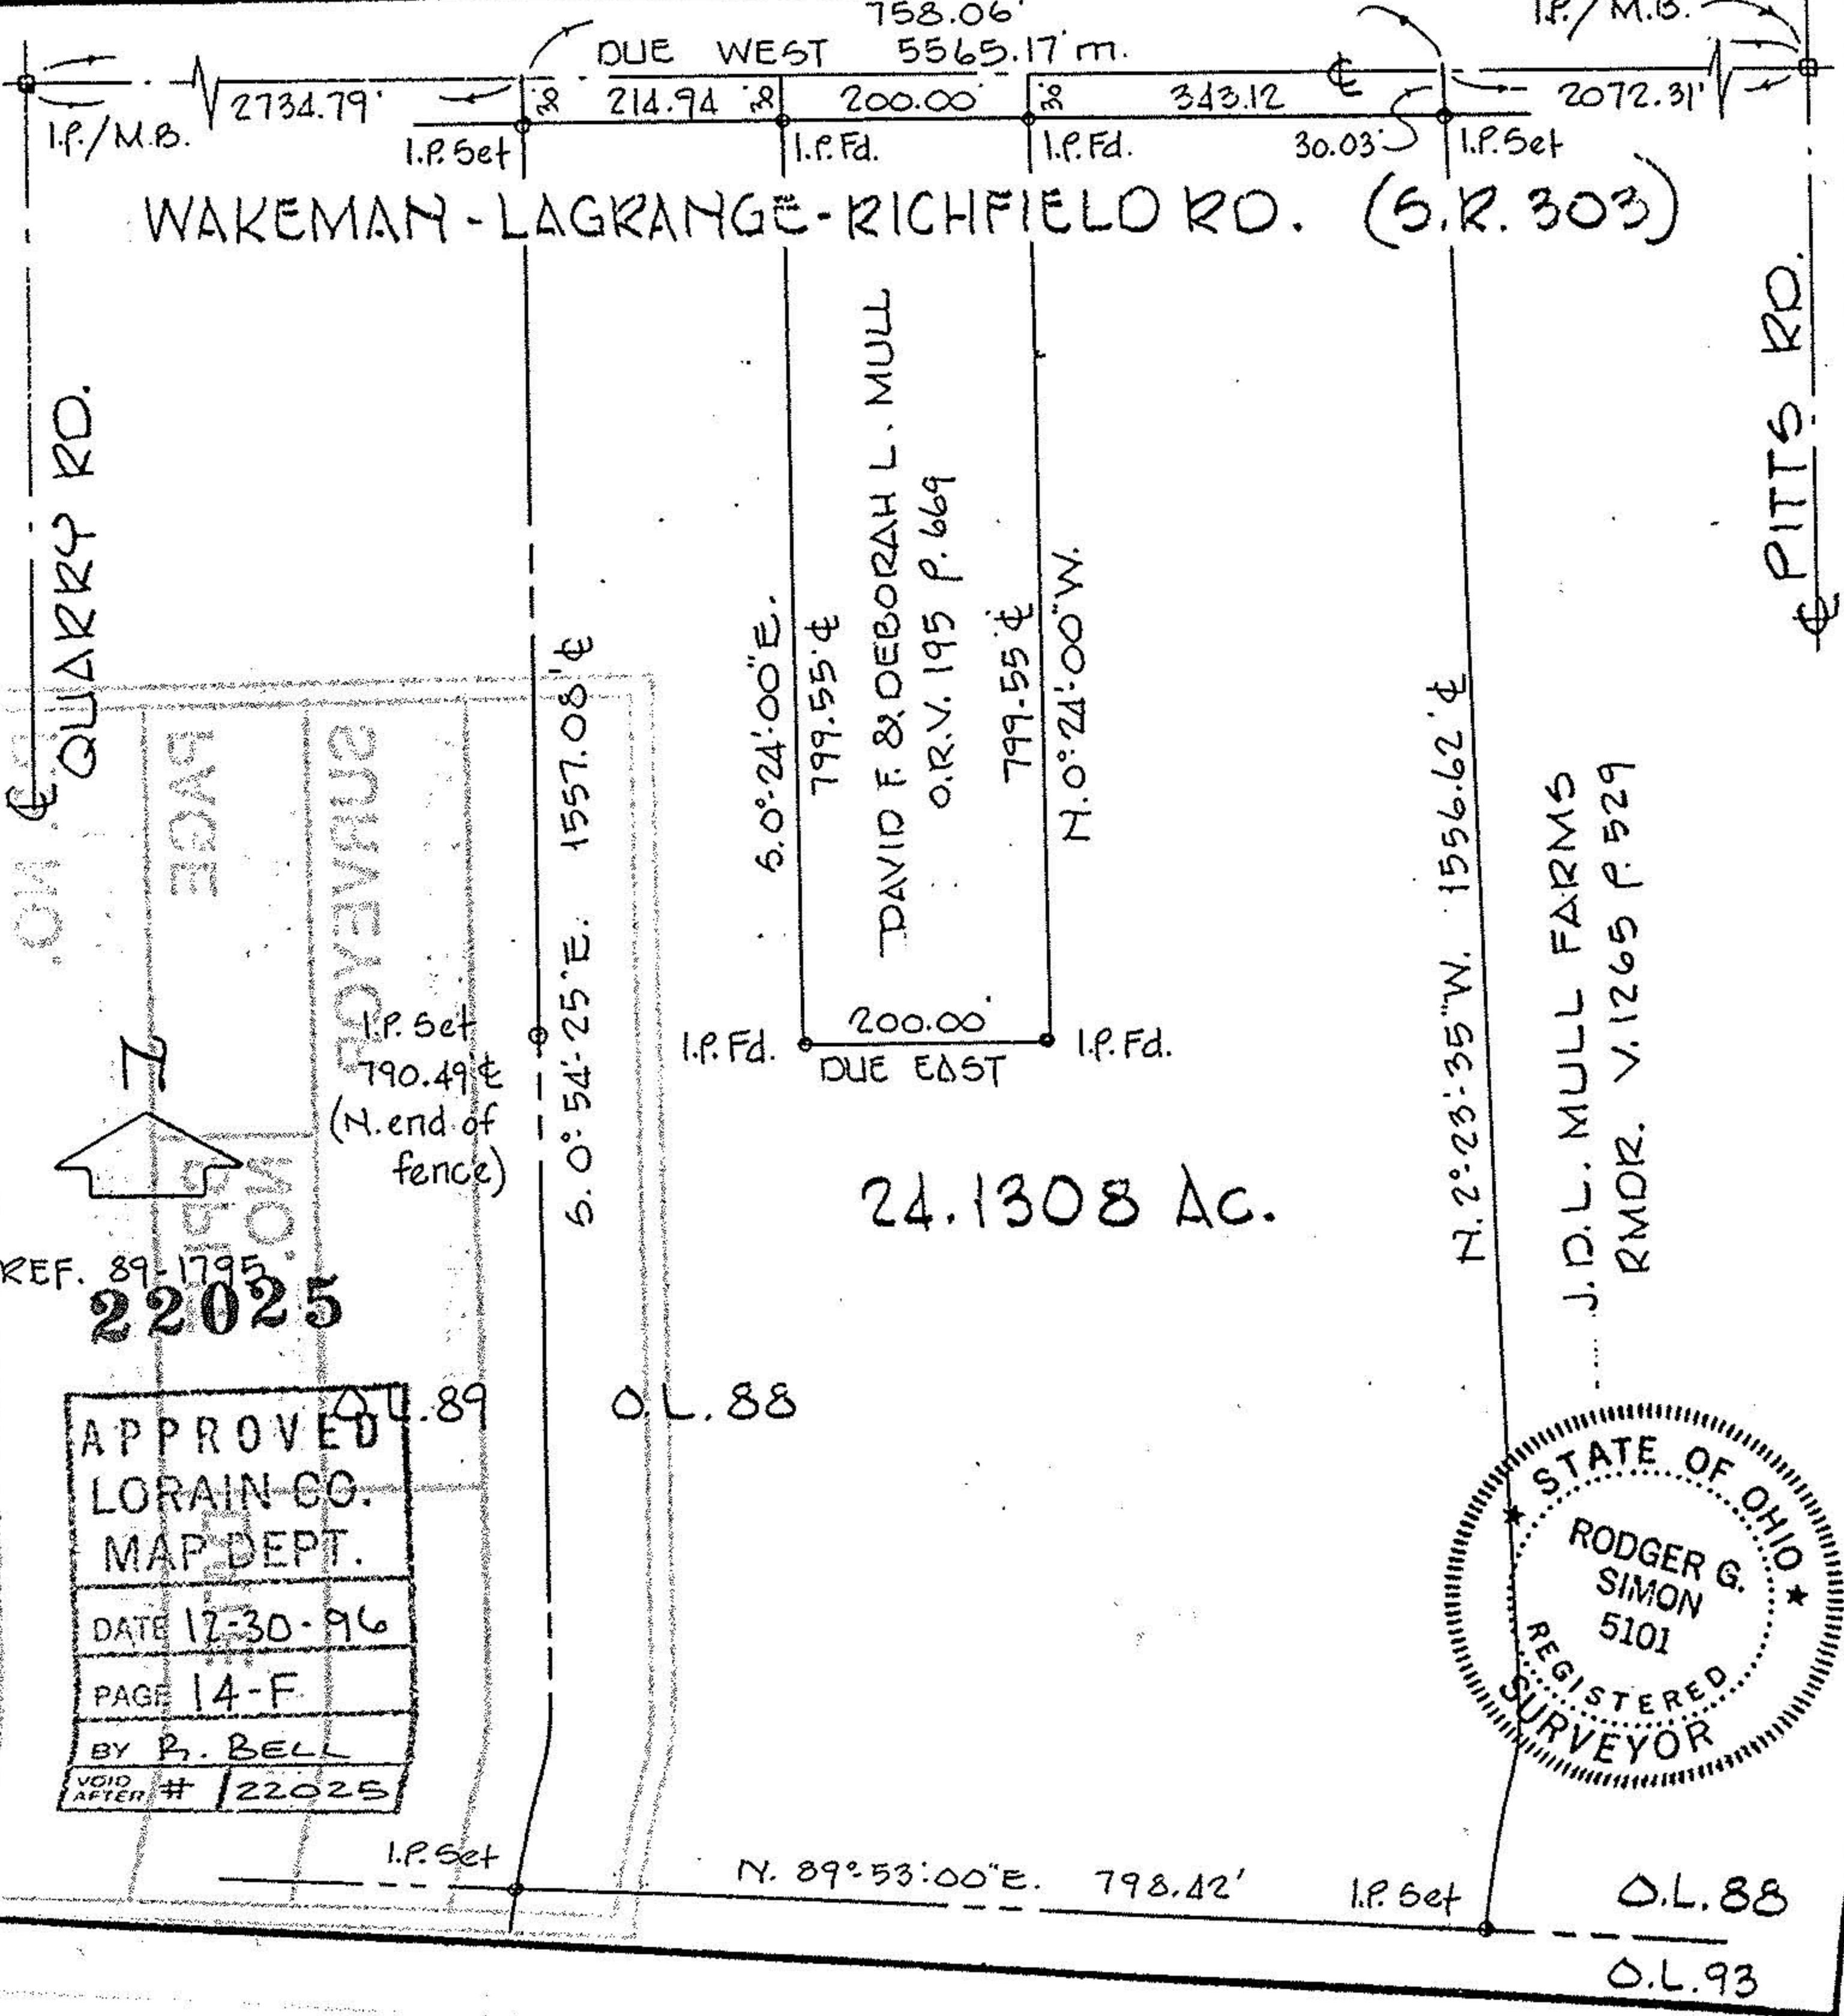

REF. 89-1795  
**22025**

APPROVED  
 LORAIN CO.  
 MAP DEPT.  
 DATE 12-30-96  
 PAGE 14-F  
 BY P. BELL  
 VOID AFTER # 22025

