

14-00-088-000
#18447
14-F




LAUNDON . SIMON . CAHL & ASSOC. INC.
CONSULTING ENGINEERS & SURVEYORS
219 COURT ST. ELYRIA, OHIO 44035

SURVEY FOR

J.D.L. MULL FARMS


Orig. Lot 88	City of	Date MAR. 9, '89 Scale 1"=200'
Orig. Sec	Village of	Dwn. by R.G.S. Chkd. by C.J.
Tract	County of LORAIN	Job No. 89-1795 F.B.
Township of PITTSFIELD	State of OHIO	Printed MAY 24

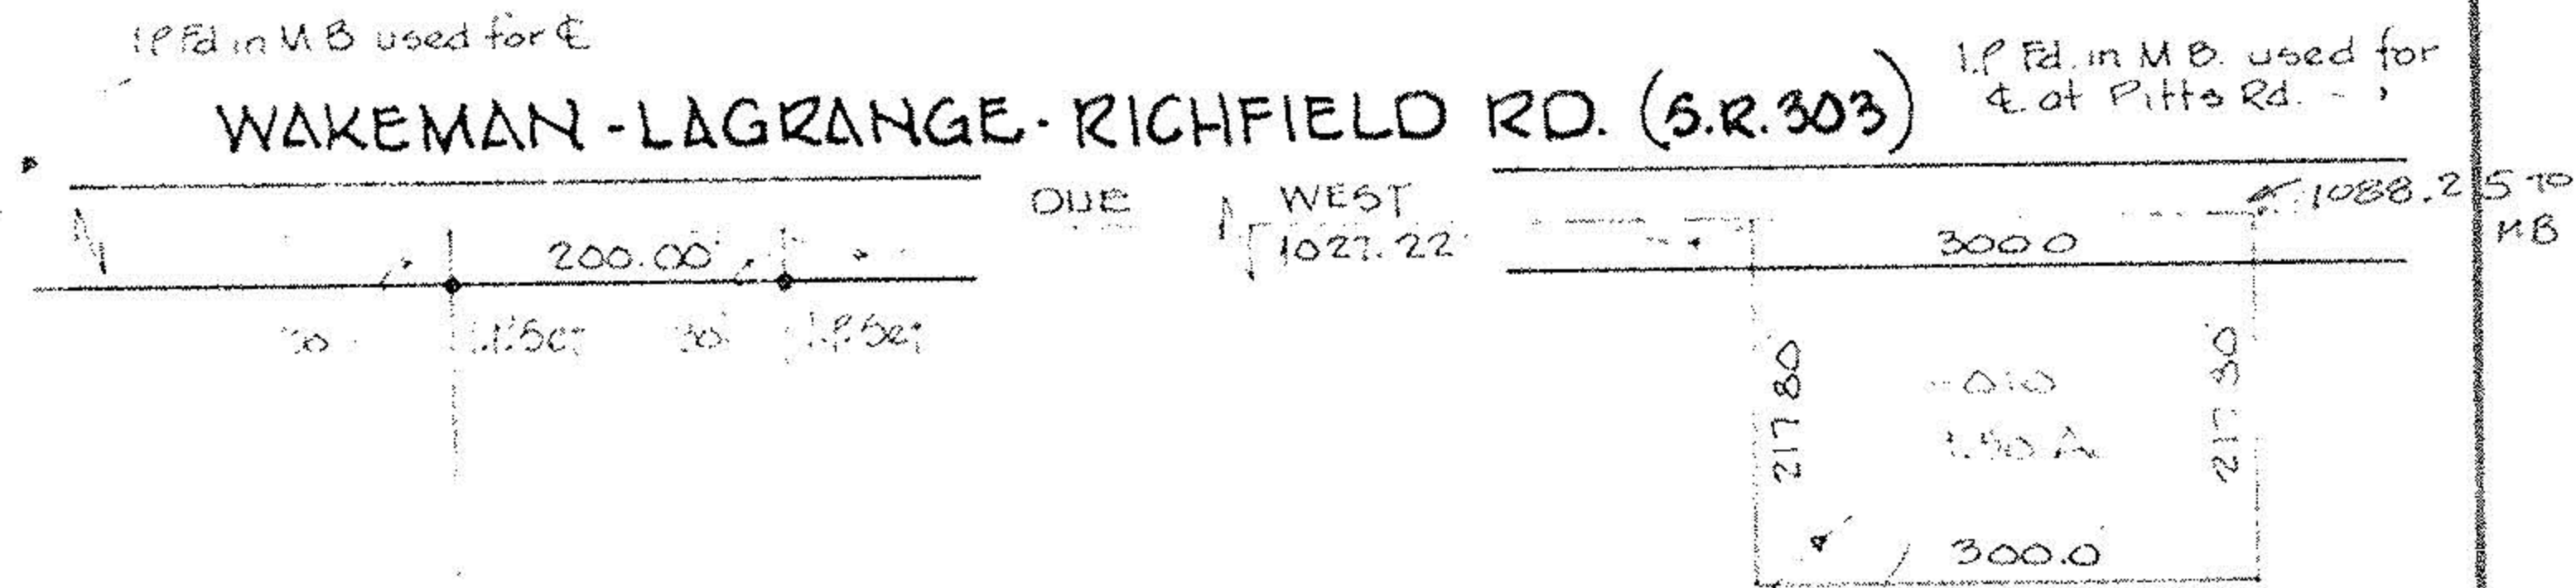

QUARRY RD.

3.6709 Ac.

S. 0° 24' E. 799.55'
N. 0° 24' W. 799.55'

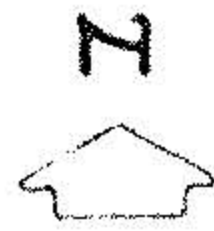

LLOYD A. & MARJORIE MULL
D.V. 1151 P. 806

#18447

APPROVED
LORAIN CO.
MAP DEPT.

DATE 5-26-89

PAGE F-A-F

BY Carol Francis

VOID AFTER # 18447



J.D.L. MULL FARMS
D.V. 1265 P. 529
Rmdr 73.09 Ac calc




LAUNDON . SIMON . CAHL & ASSOC. INC.
CONSULTING ENGINEERS & SURVEYORS
219 COURT ST. ELYRIA, OHIO 44035

SURVEY FOR

J.D.L. MULL FARMS

Orig. Lot 88	City of	Date MAR. 9, '89 Scale 1"=200'
Orig. Sec	Village of	Dwn. by R.G.S. Chkd. by C.J.
Tract	County of LORAIN	Job No. 89-1795 F.B.
Township of PITTSFIELD	State of OHIO	Printed

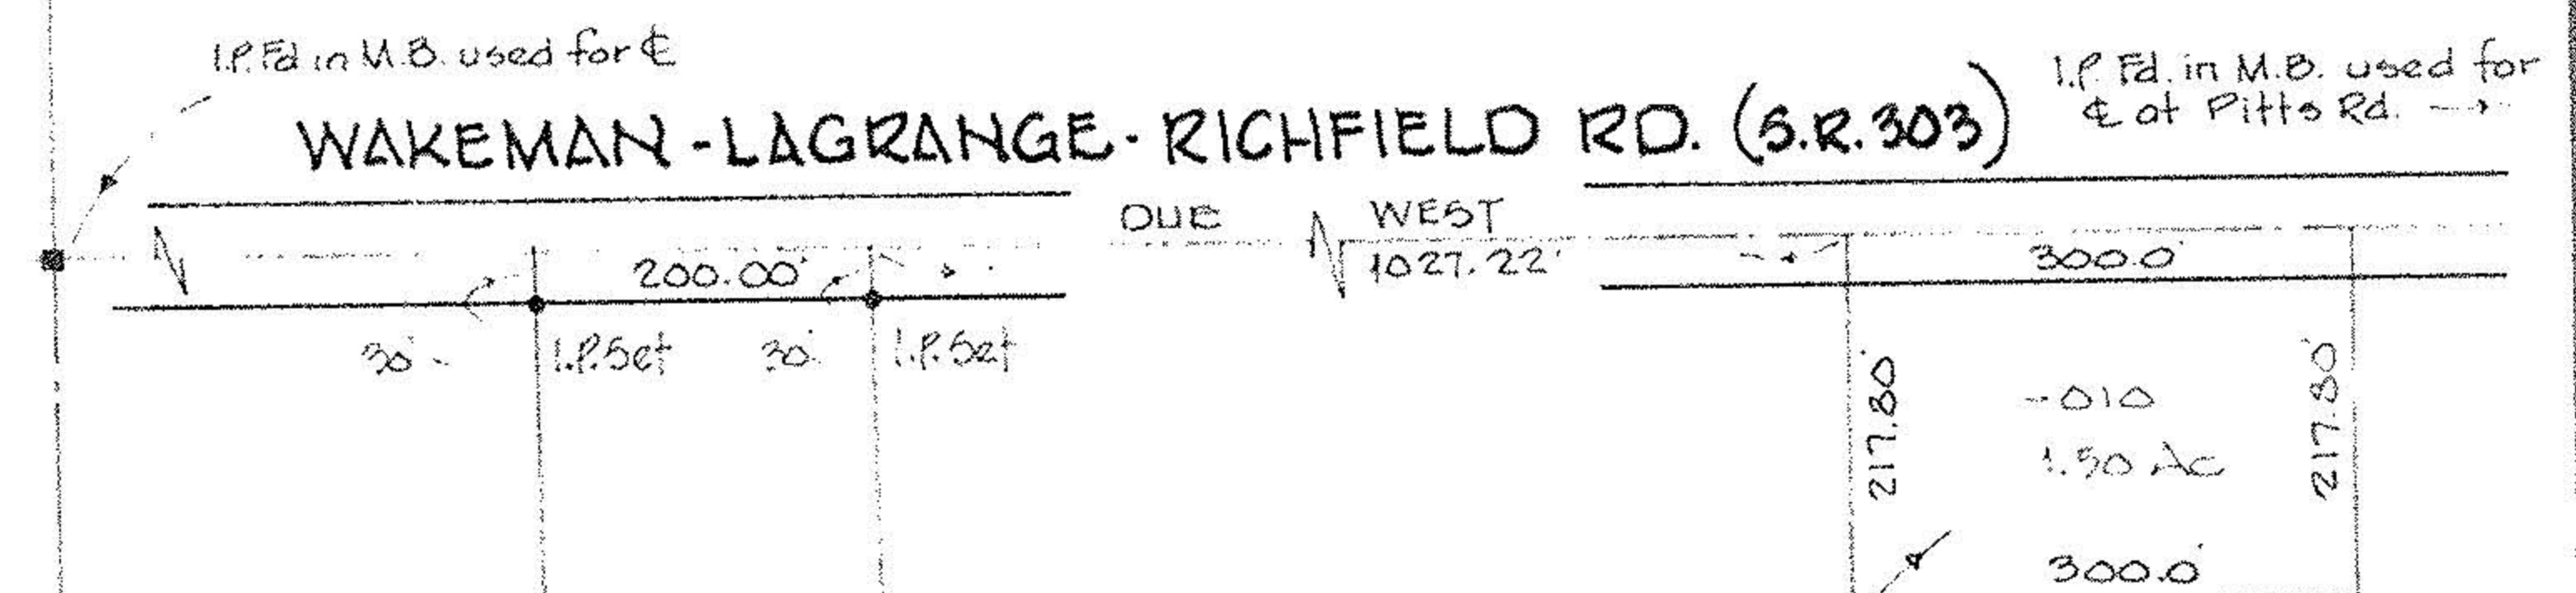

QUARRY RD.

3.6709 Ac.

S. 0° 24' E. 799.55'
N. 0° 24' W. 799.55'



LLOYD A. & MARJORIE MULL
D.V. 1151 P. 806

#18447

APPROVED
LORAIN CO.
MAP DEPT.

DATE 6-7-89

PAGE 14-F

BY Carolyn Francis

VOID AFTER # 18447

J.D.L. MULL FARMS
D.V. 1265 P. 529
Rmdr 73.09 Ac calc

14-00-088-000
#18447
14-F