


05-00-078-000

Ten. 21-01 = 38720 x 10' = 3.87

Sec. 12-25 = 1.07806 x 10' = 10.78

Sec. 21-01 = 1.07126 x 10' = 10.71

387.20
3.87
391.07
2.39
388.68

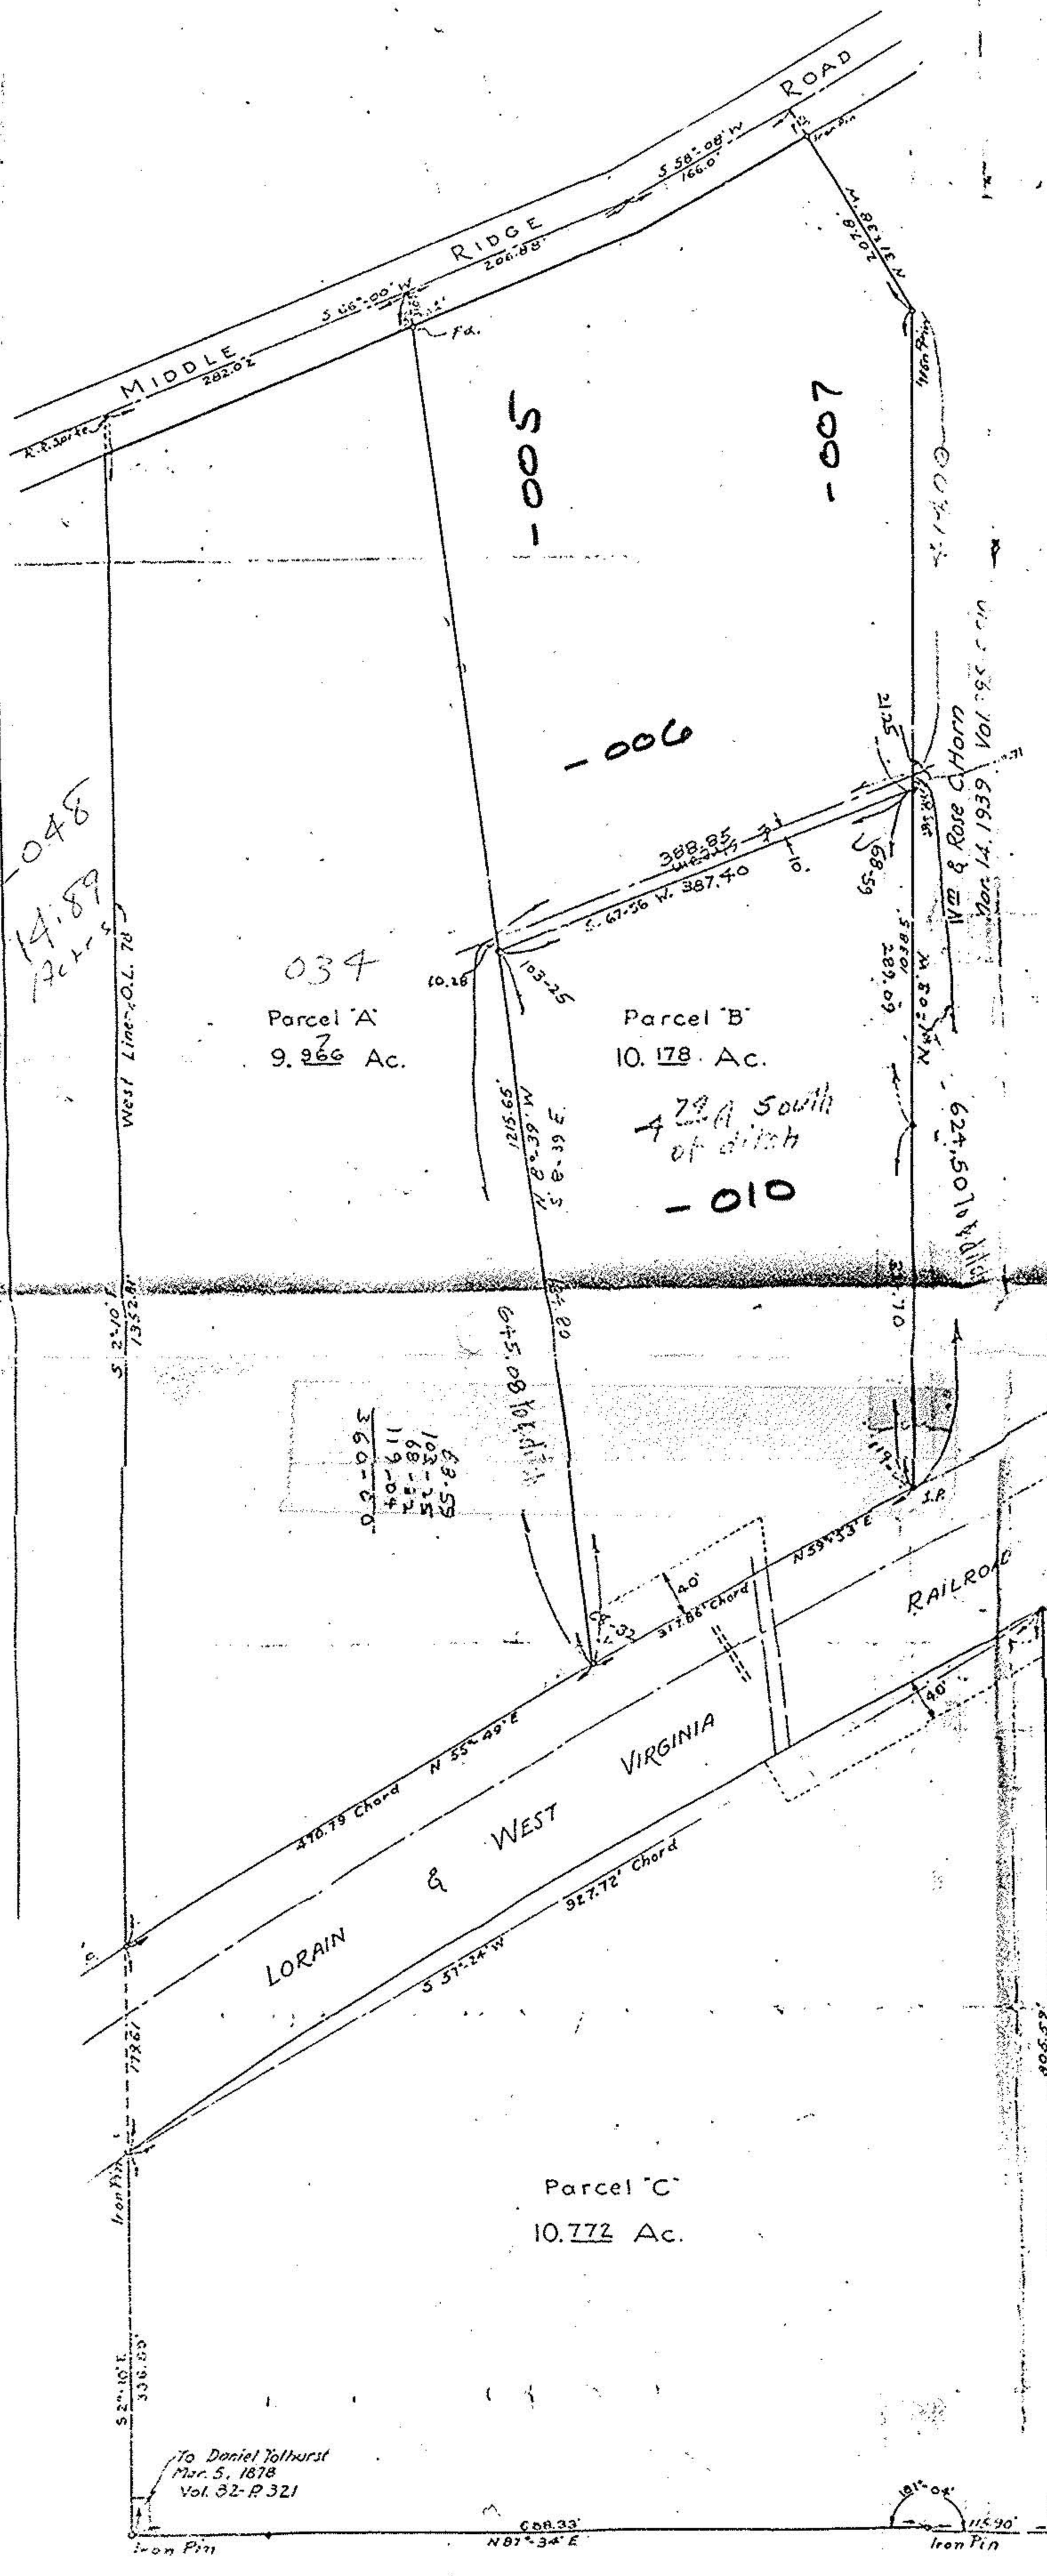

PLAT OF SURVEY AND SUBDIVISION OF LAND IN ORIGINAL AMHERST TOWNSHIP LOT No. 78 FOR MR. WM. H. BAKER.

SCALE 1"=100'

LORAIN, OHIO AUG. 29, 1946
J. B. NICHOLS REGISTERED SURVEYOR

Parcel 'A'
9.966 Ac.

Parcel 'B'
10.178 Ac.

Parcel 'C'
10.772 Ac.

Parcel 'D'
11.060 Ac.

29 A South of ditch

Charles & Sophia Majjassie
May 9, 1926 Vol. 219-P104

To Daniel Tolhurst
Mar. 5, 1878
Vol. 32-P.321

05-00-078-000

5-00-078-A