

21-H


#18026

21-17-013-000-021

21-17-013-000-021

023  
024  
025

New London Lafayette  
1204.85' Due West Rd

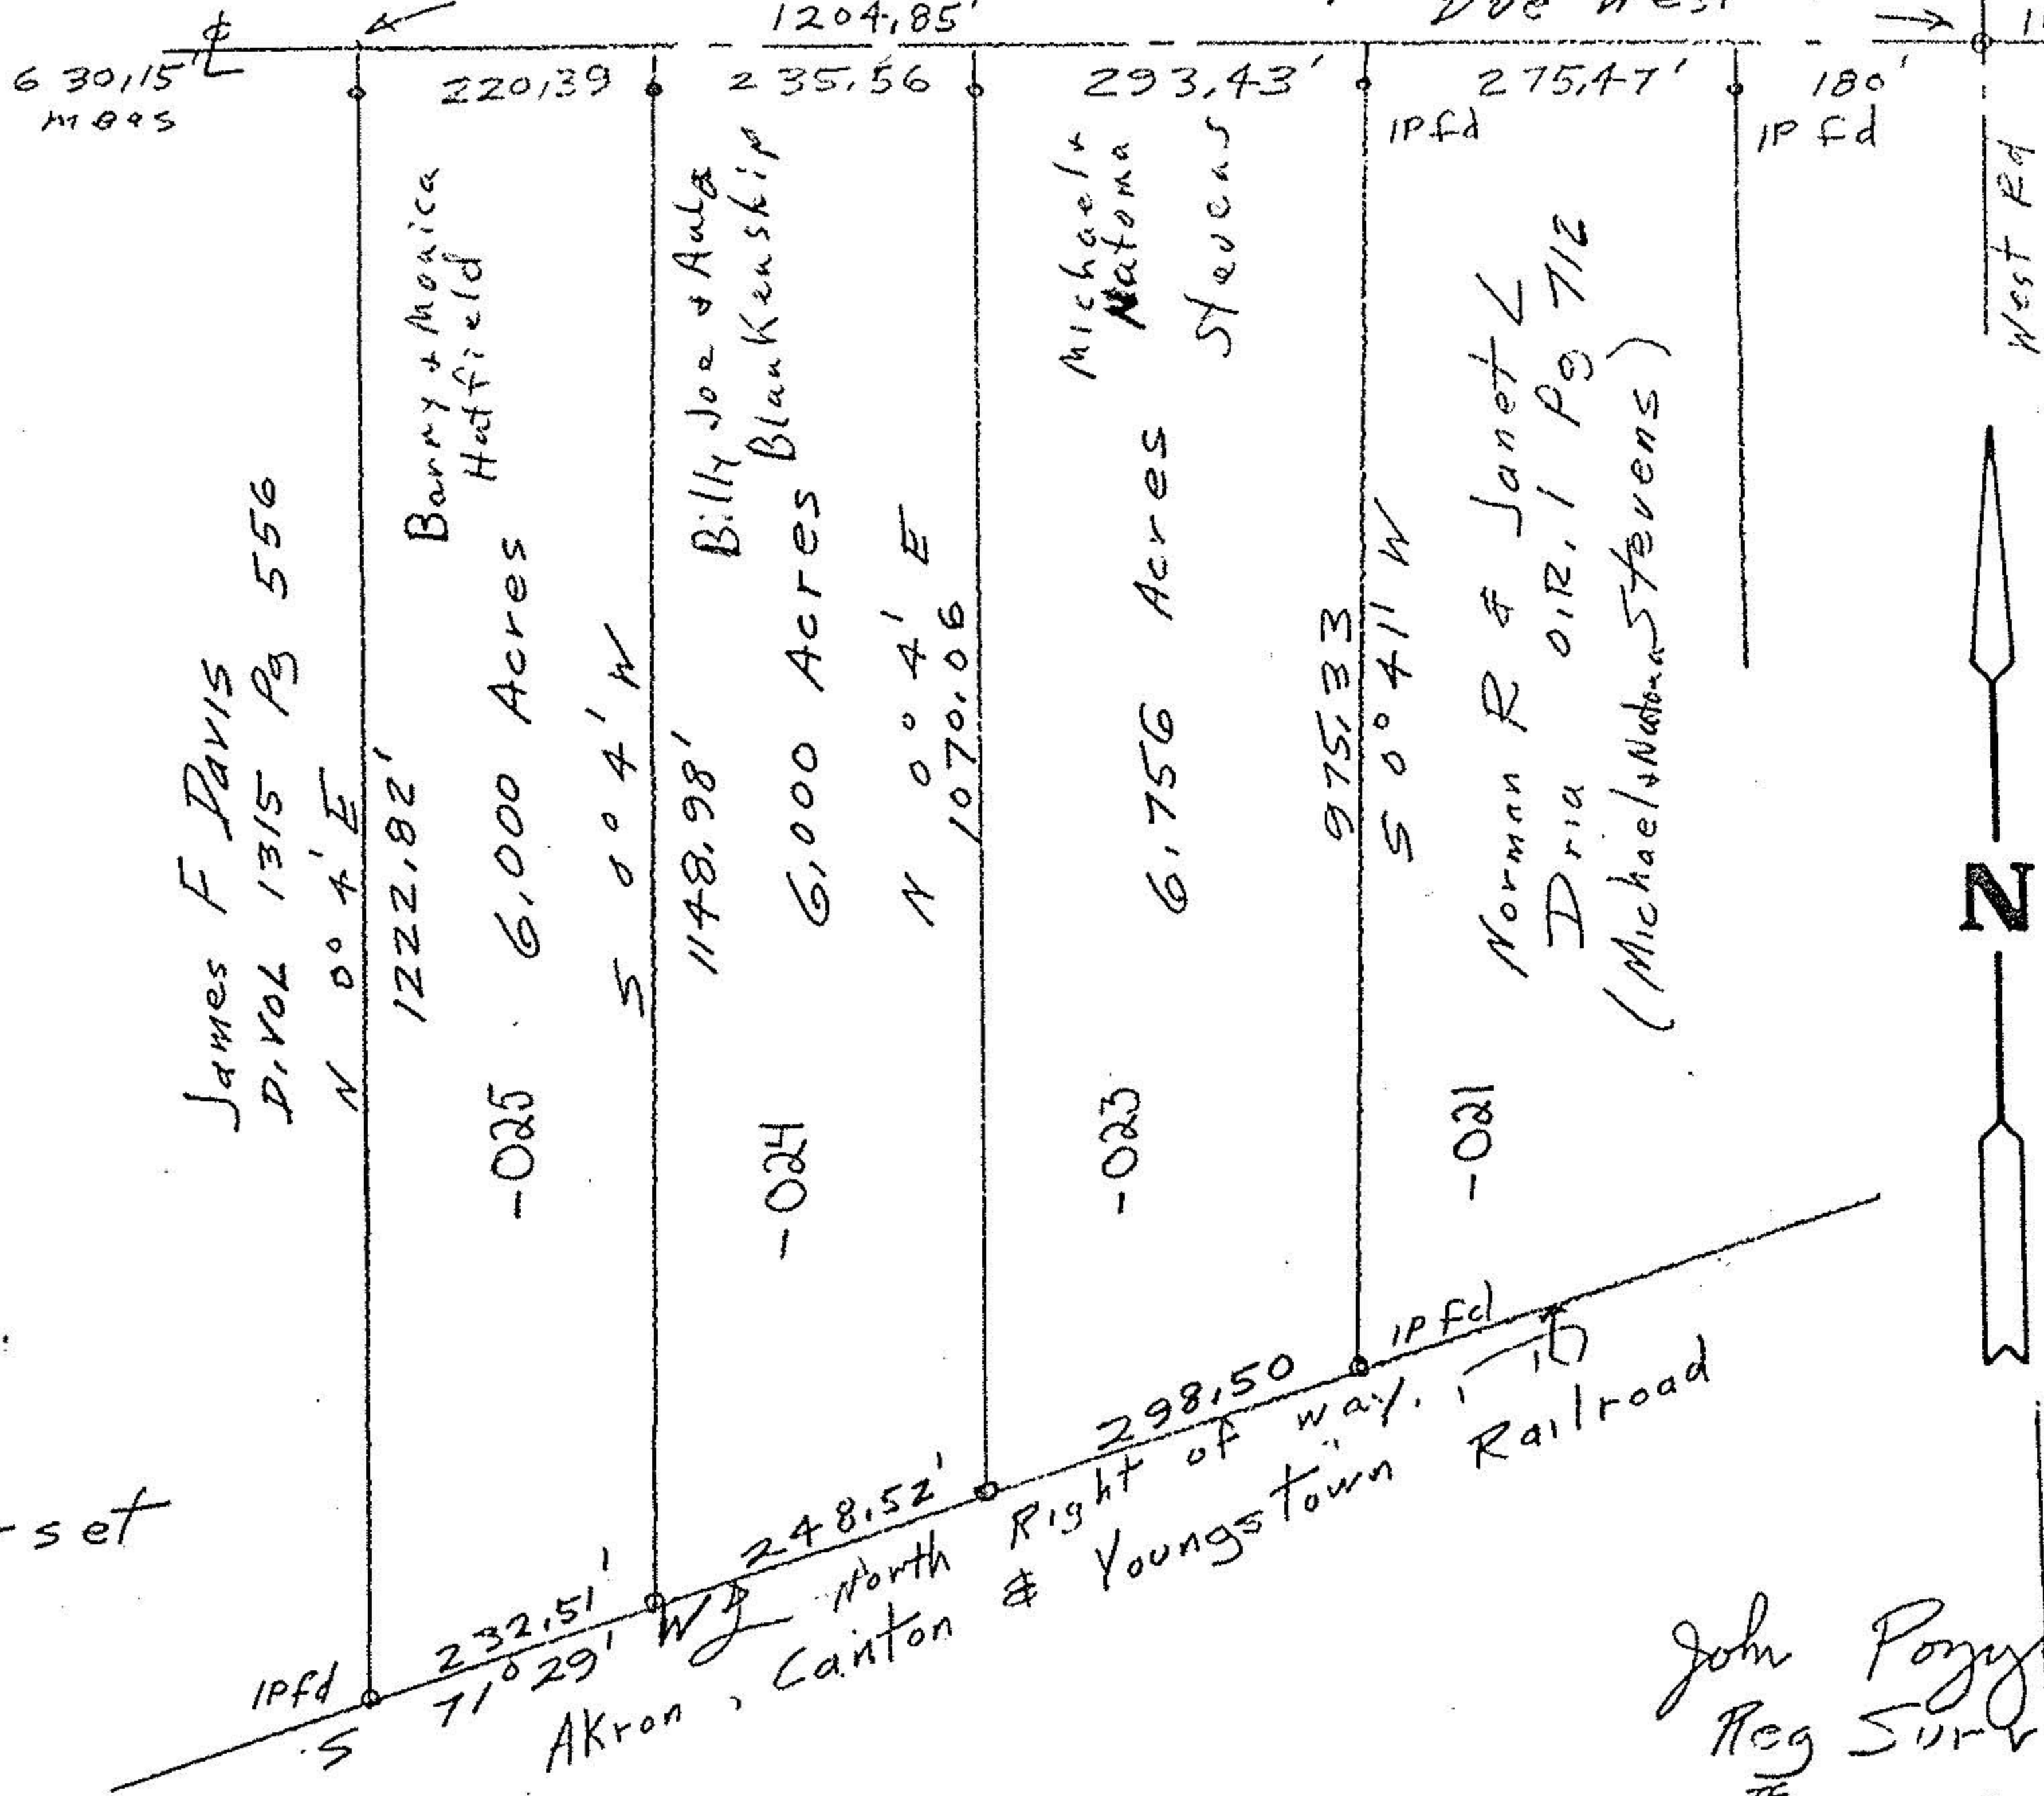

Surve  
Part  
Trac  
Hunt  
Lora  
Scale

121



#18026

APPROVED LORAIN CO. MAP DEPT.
DATE 7-20-88
PAGE 21-H
BYC. FRANCIS
VOID AFTER XX 18026

• 1P's for set

John Poyy  
Reg Surveyor  
# 5292