

KS ASSOCIATES, INC.
 424 Middle Ave. P.O. Box 89
 ELYRIA, OHIO 44036
 (216) 322-6317

SURVEY MAP

PART OF
 HUNTINGTON TOWNSHIP
 ORIGINAL LOT 7, TRACT 17
 COUNTY OF LORAIN - STATE OF OHIO

21-17-007-000


#183333

WEST ROAD
 DUE N. & S. ASSUMED

21-D

O.L. 6
 O.L. 7

COR. POST
 FD. & USED

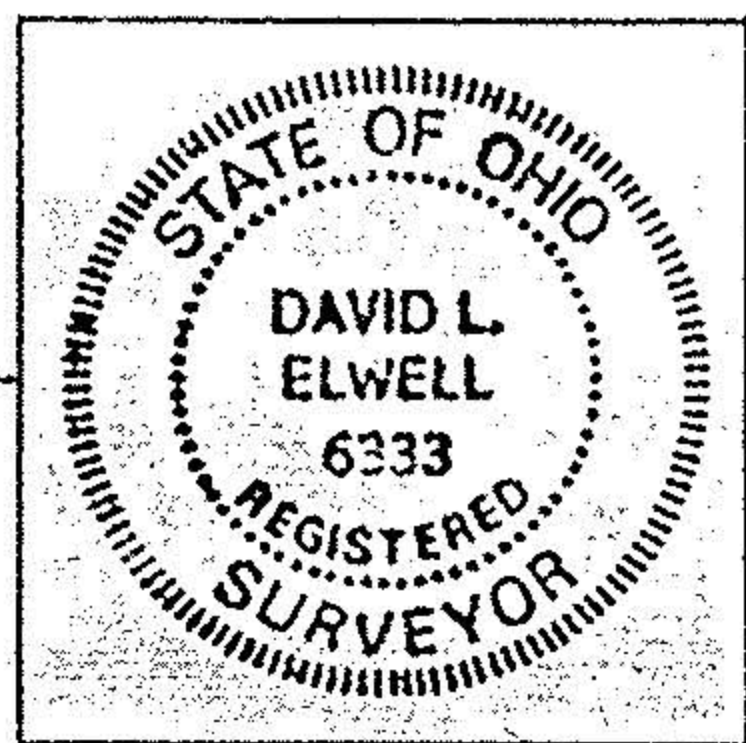

David L. Elwell
 REG. SURVEYOR
 JAN. 17, 1989

TRACT 17

DAVID MANNING
 1323/151


#183333
 #183333

APPROVED	
LORAIN CO.	
MAP DEPT.	
DATE	2-0-88-89
PAGE	21-D
BY	<i>[Signature]</i>
VOID AFTER	2/2/89

SCALE 1"=100'

CAROL A. &
 FRANK C. MCGRAW
 1295/638

-009
 21-17-007-000
 1.2751 AC.

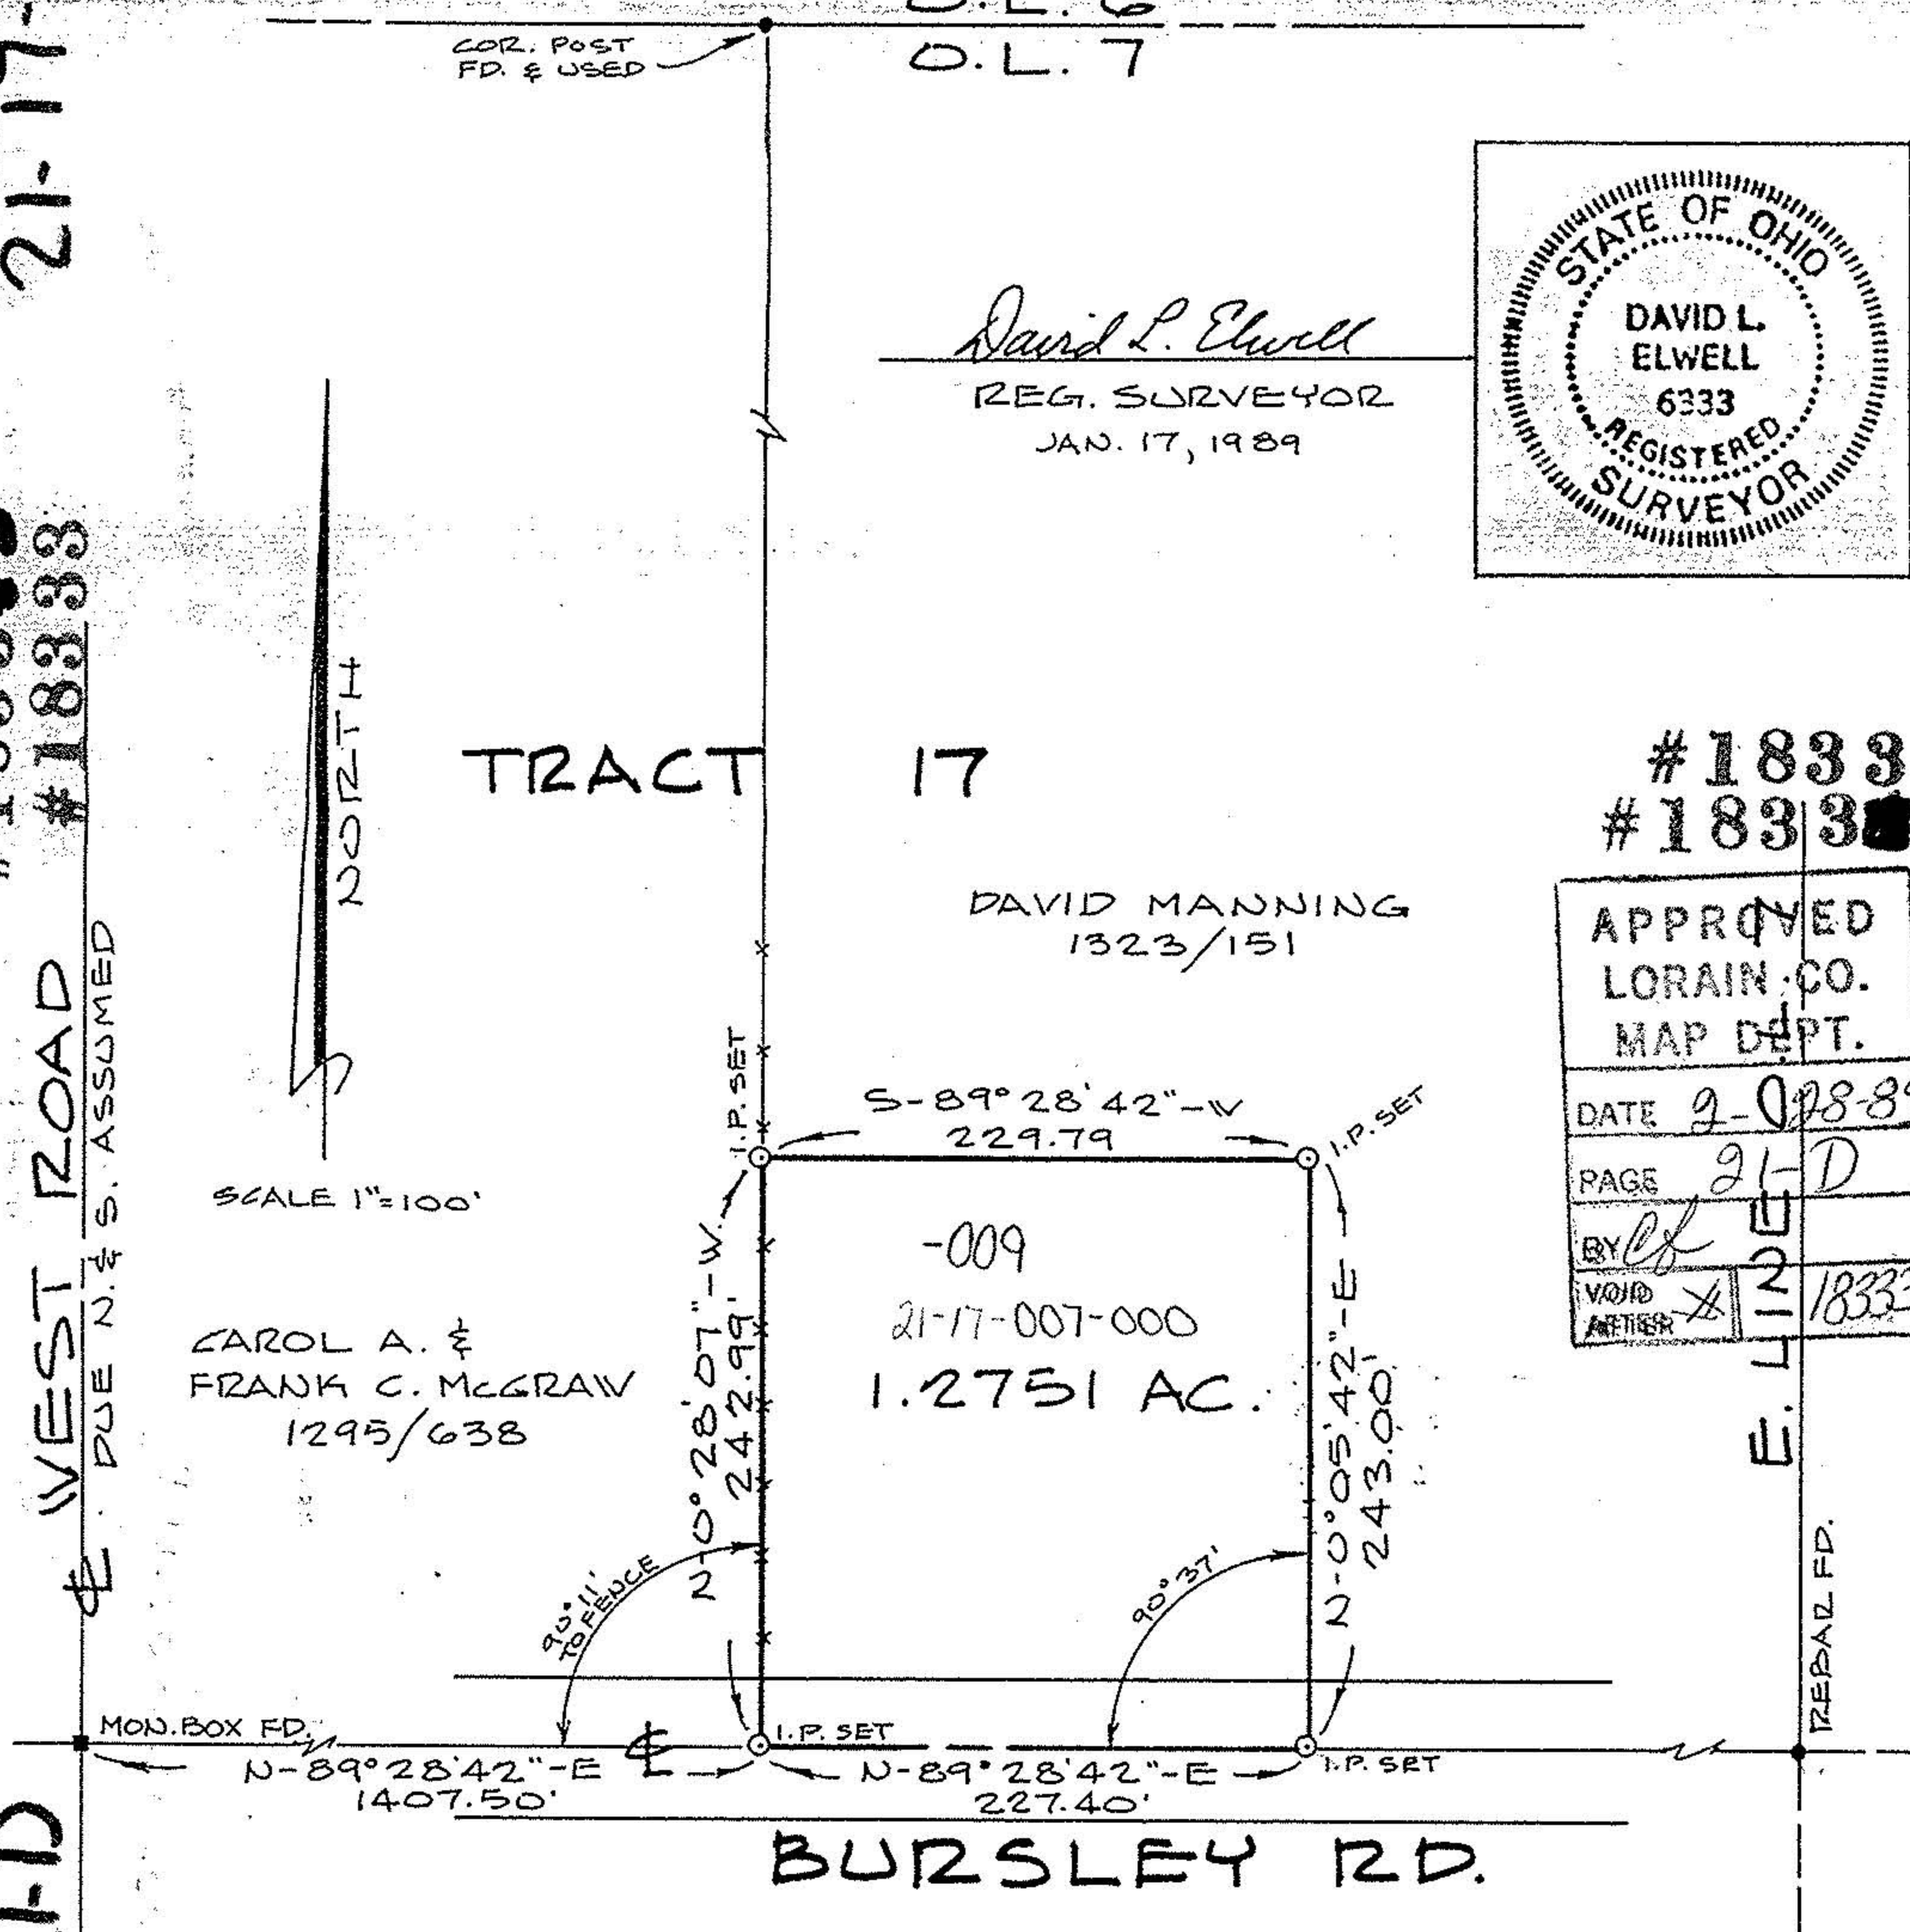

BURSLEY RD.

(110)

89-04