


21-D

#16493



Survey of Part of Tract 17 Lot 5 Huntington Twp. Lorain Co. Ohio
 Scale 1" = 200'
 By Arnold F. Koepf Reg. Surveyor No. 4306
 Nov. 11, 1985

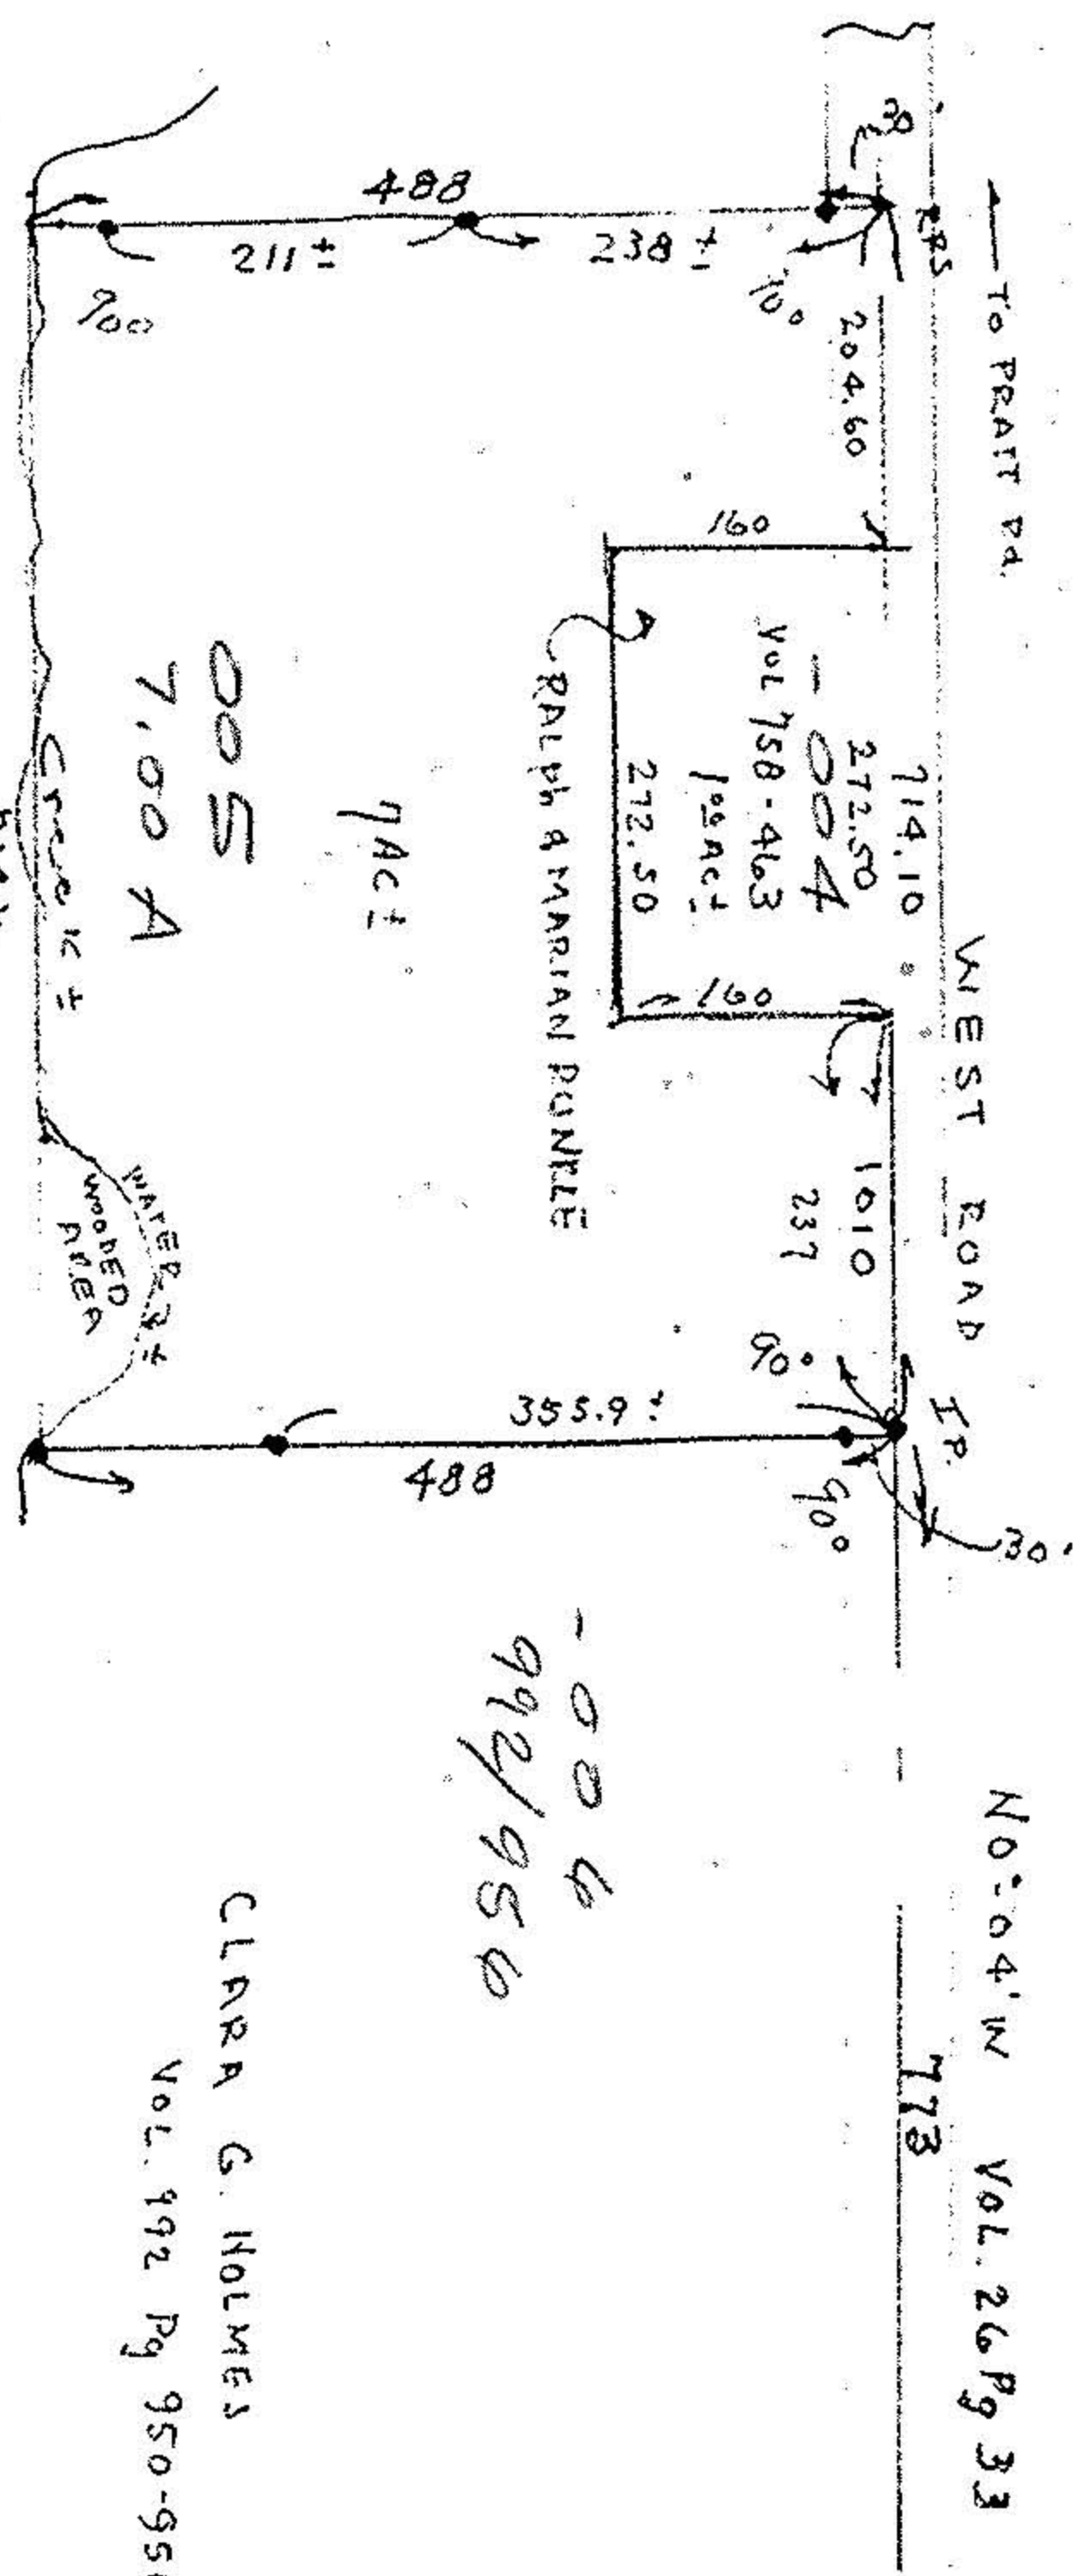

TR 17 Lot 5 TR 17 Lot 6
 Lot 5 TR 17 Lot 7 TR 17
 MONBAY

CLARA G. HOLMES
 Vol. 992 Pg 950-956

-004
 992/956

(101)

#16493

APPROVED	
LORAIN CO.	
MAP DEPT.	
DATE	12-11-85
PAGE	21-D
BY	C. FRANCIS
VOID AFTER	