
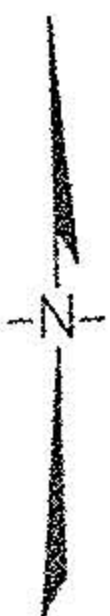


GRAPHIC SCALE 1"=200'

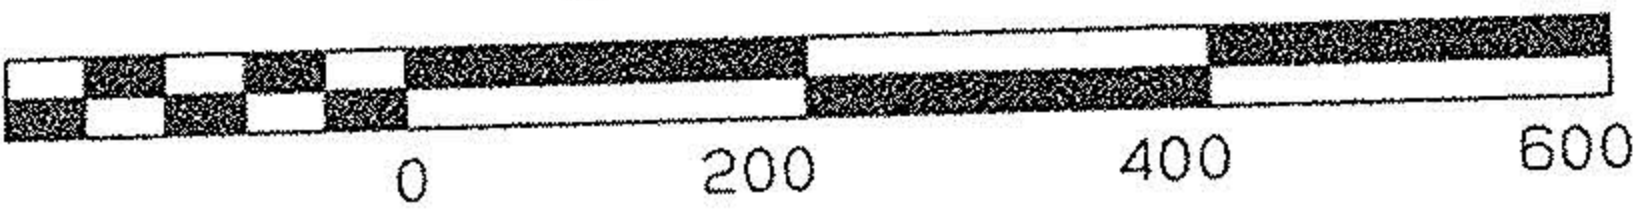


Survey For
SHEILA WARE
O.L. 26 Grafton Twp.
Lorain Co. Ohio
Carlson Surveys
440-926-0200

Bearings are to an assumed meridian and used to indicate angles only.
Basis of bearings is the bearing for the centerline of Avon Belden
Road as found in Document # 97-0499308.
This Plat of Survey represents the minimum standards for boundary
surveys in the State of Ohio as adopted 5-1-80 of the Administrative
Code chapter 4733-37.

-022
Kathy & Robert Hall
O.R. 203 P. 239

☒ = C/L Ref. Mon Fd.
IPF = Iron Pin Found
ips = iron pin set

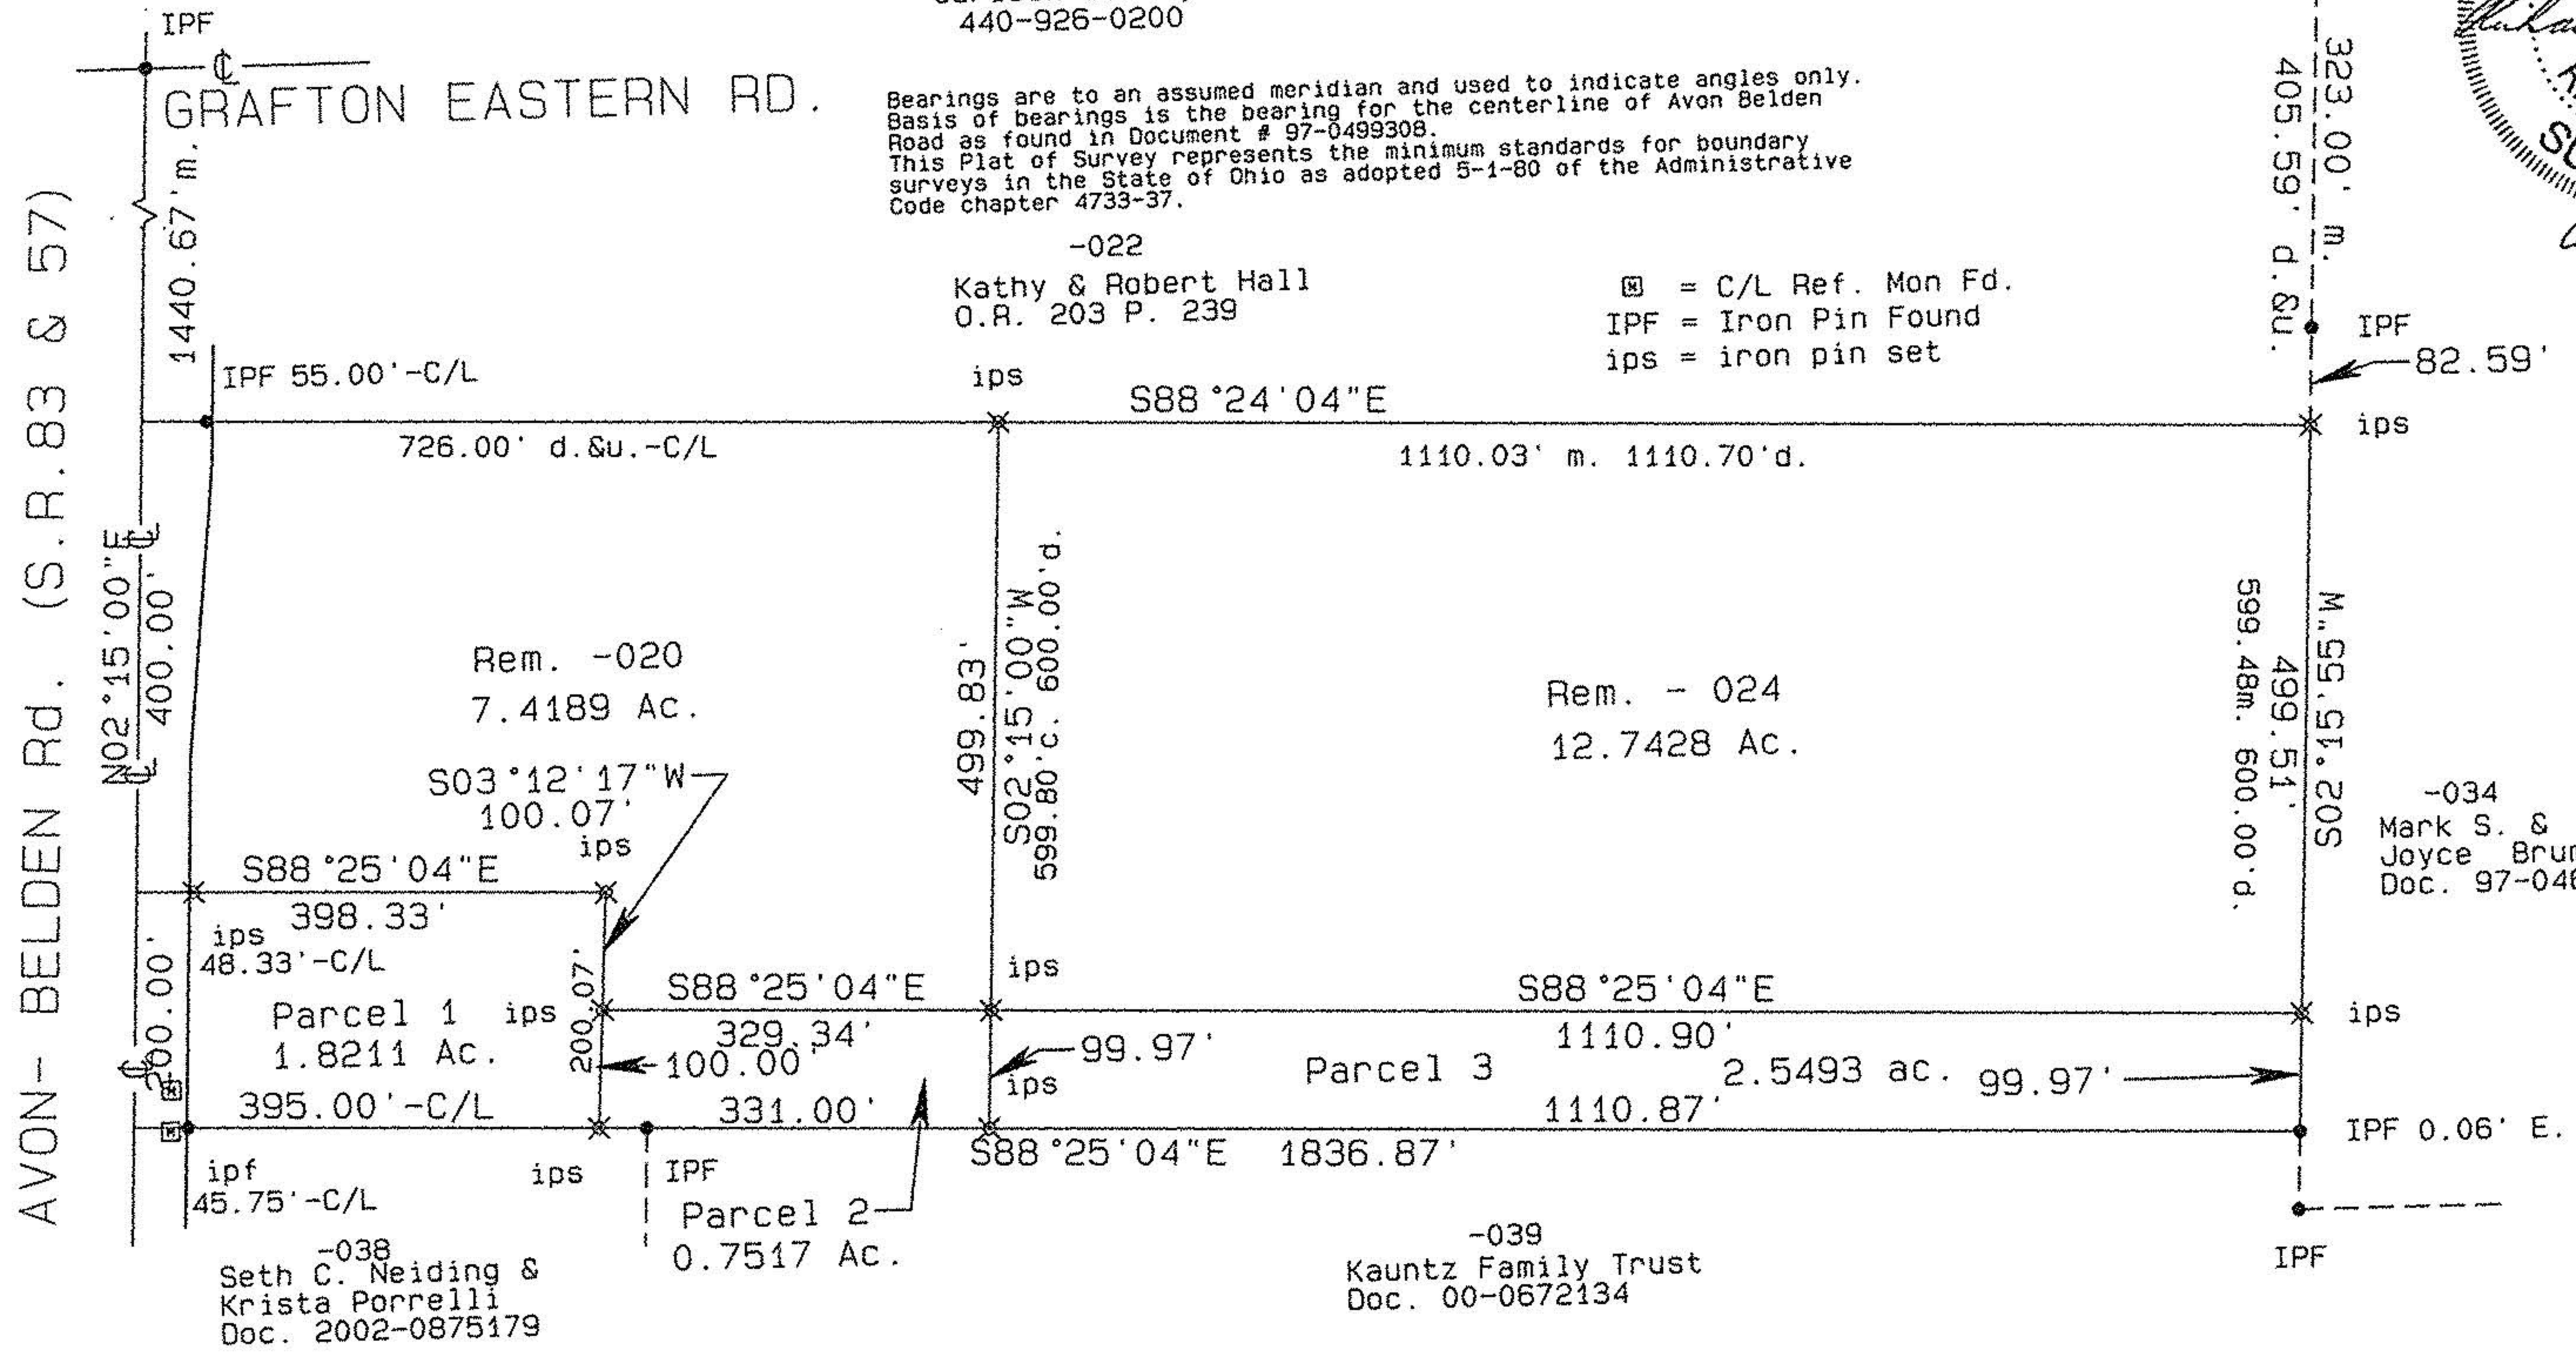

-034
Mark S. &
Joyce Brummer
Doc. 97-0469237

-039
Kauntz Family Trust
Doc. 00-0672134

-038
Seth C. Neiding &
Krista Porrelli
Doc. 2002-0875179