


TOM • Combination DEED

ONLY

A-5

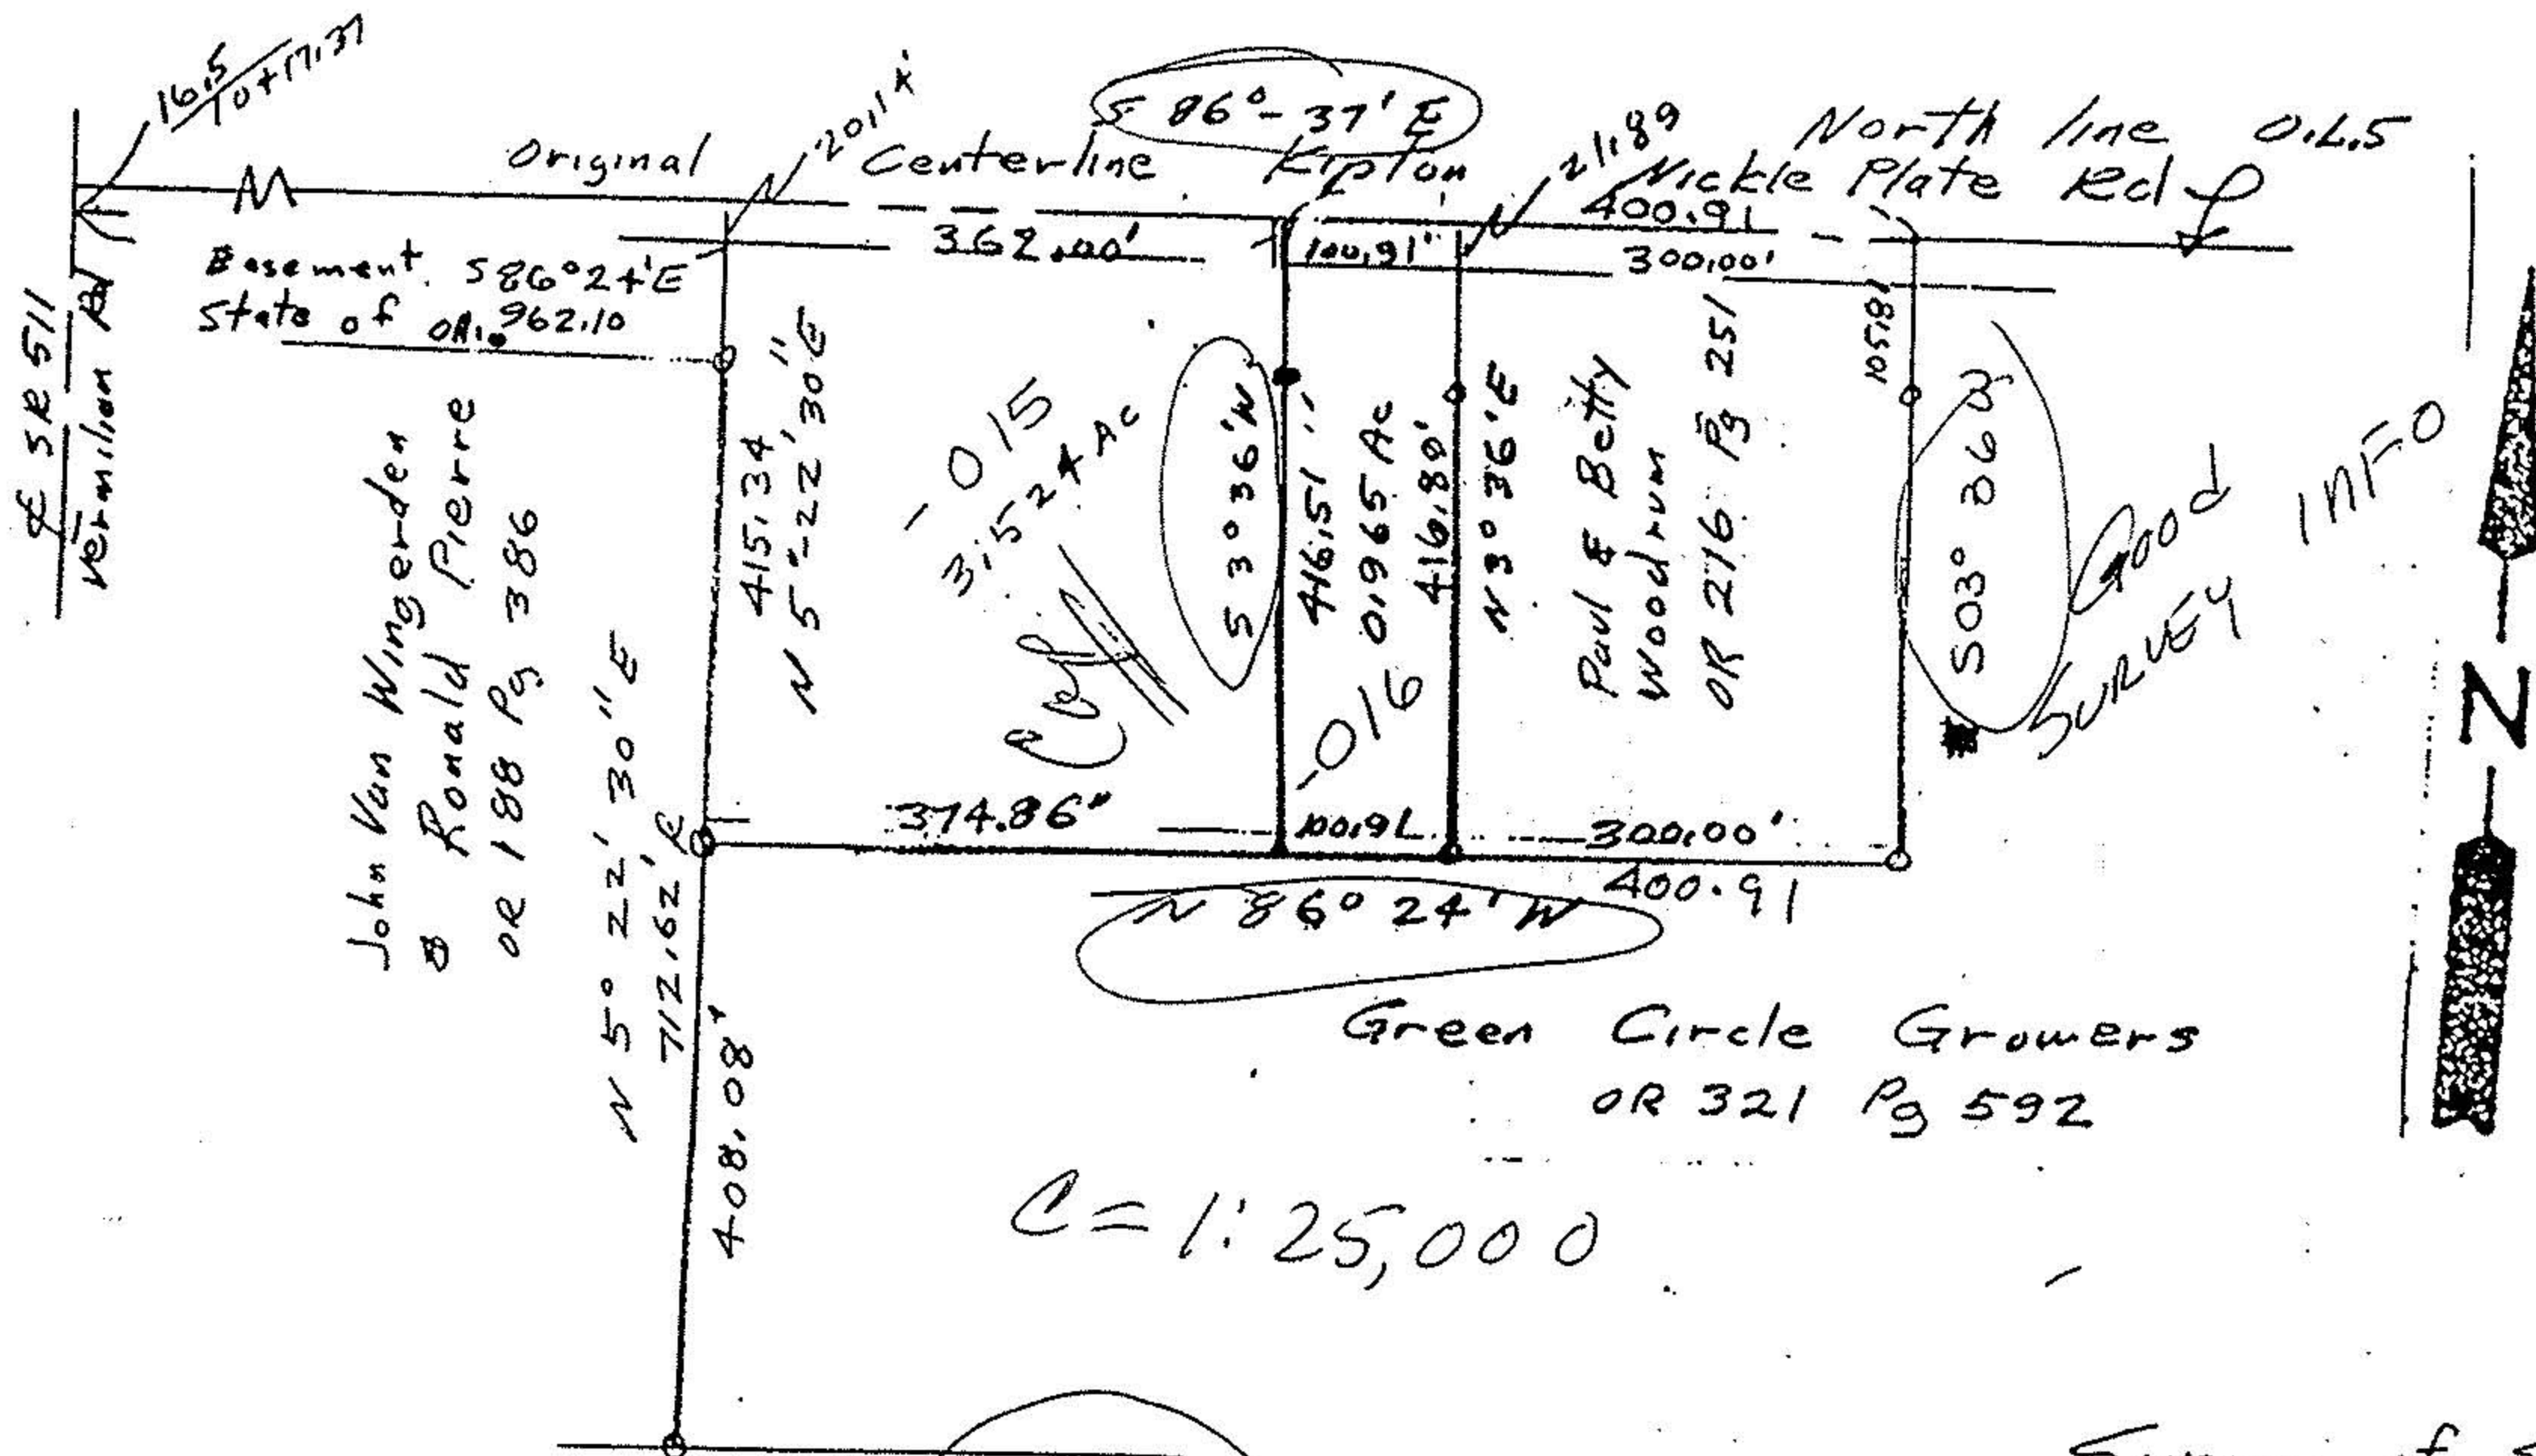

C = 1:25,000

2126 Acres
Remainder

21670

APPROVED LORAIN CO. MAP DEPT
DATE

Survey of Survey Splits
for Paul Woodrum
Original Lot 5 Tract 10
Camden Township
Lorain County Ohio
Scale 1" = 200' Dec 1995

D.V. 296 Pg 612
State of Ohio Easement

- o iron pipes set
- iron pins set

John Poznywal
Reg Surveyor

