


The Lehman-Johnson Co.
 D. Vol. 748 Pg. 401
 1.P.Fd.

30.02' I.P.Fd.
 87°48'
 334.65' Deed & Meas.
 304.63' Meas.
 172.0'

PLAT OF SURVEY FOR
 PAULINE MARCELLA YOHO
 ORIGINAL LOT 12 - TRACT NO. 10
 CAMDEN TOWNSHIP
 LORAIN COUNTY OHIO
 SCALE: 1" = 60' JULY 1973
 Gary E. Penfound Reg. Surveyor No. 4457

NOTE: ● indicates iron pin set
 unless otherwise designated.

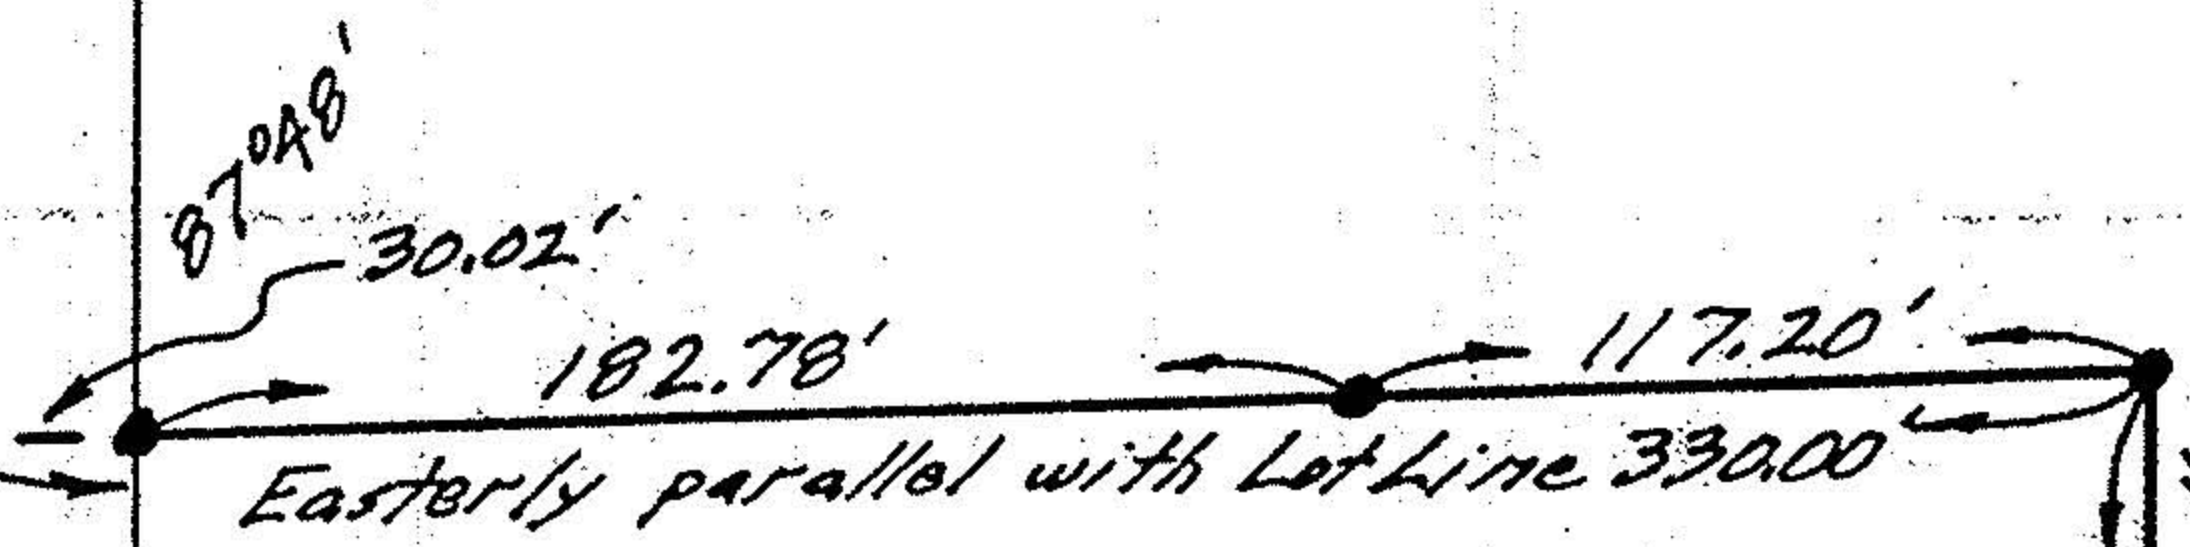

0.9993 ACRE
 Randall Clyde Yoho & Pauline
 Marcella Yoho D. Vol. 340 Pg. 192

