


GRAPHIC SCALE 1"=200'

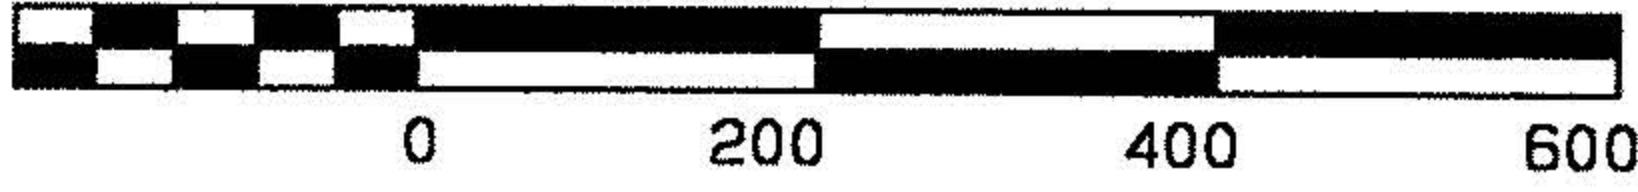

-025
Andy & George Demyan
V. 1031 P. 803

Survey For
Robert E. Gilchrist, Trustee
11.2678 Ac.


O.L. 89
Lorain Co.
Carlson Surveys

Grafton Twp.
Ohio
440-926-0200

May 2003

LEGEND

- x IPS = Iron Pin Set
- IPF = Iron Pin Found
- ▲ ARS = Railroad Spike

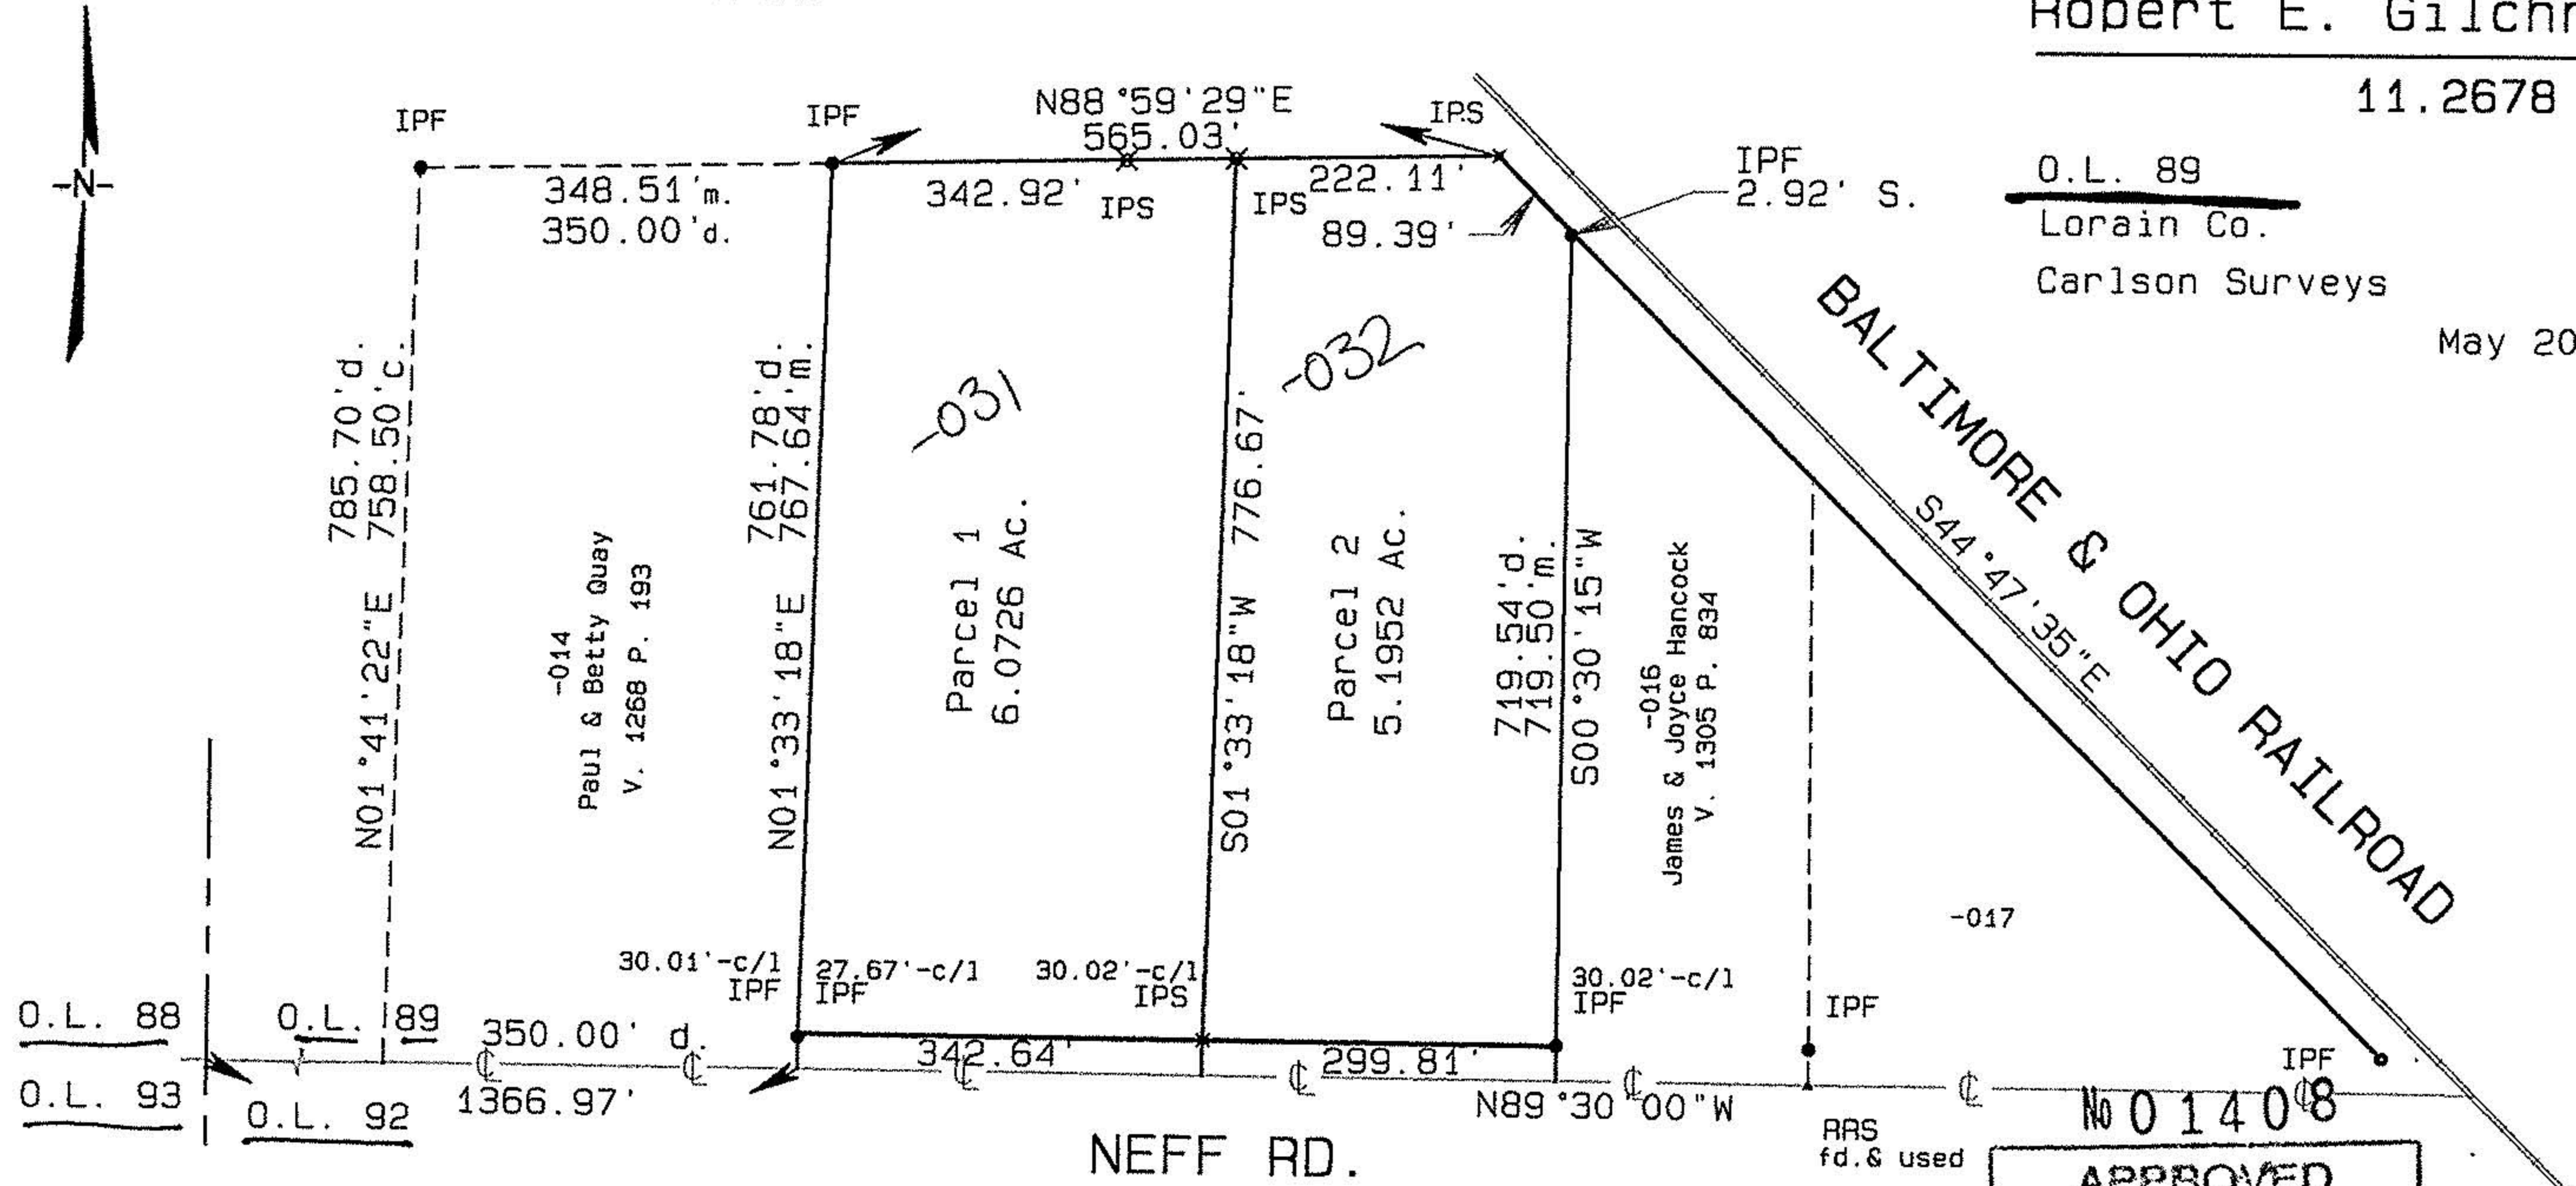

Basis of bearings is the centeline bearing for Neff Road as found in O.R.V. 137 P. 127. Bearings are to an assumed meridian and used to indicate angles only. This plat of survey represents the minimum standards for boundary surveys in the state of Ohio as adopted 5-1-80 of the Administrative Code chapter 4733-37.

No 01408

APPROVED LORAIN CO. MAP DEPT
DATE 7/14/04
PAGE 16-H
BY

