
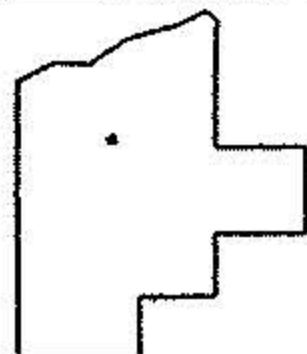
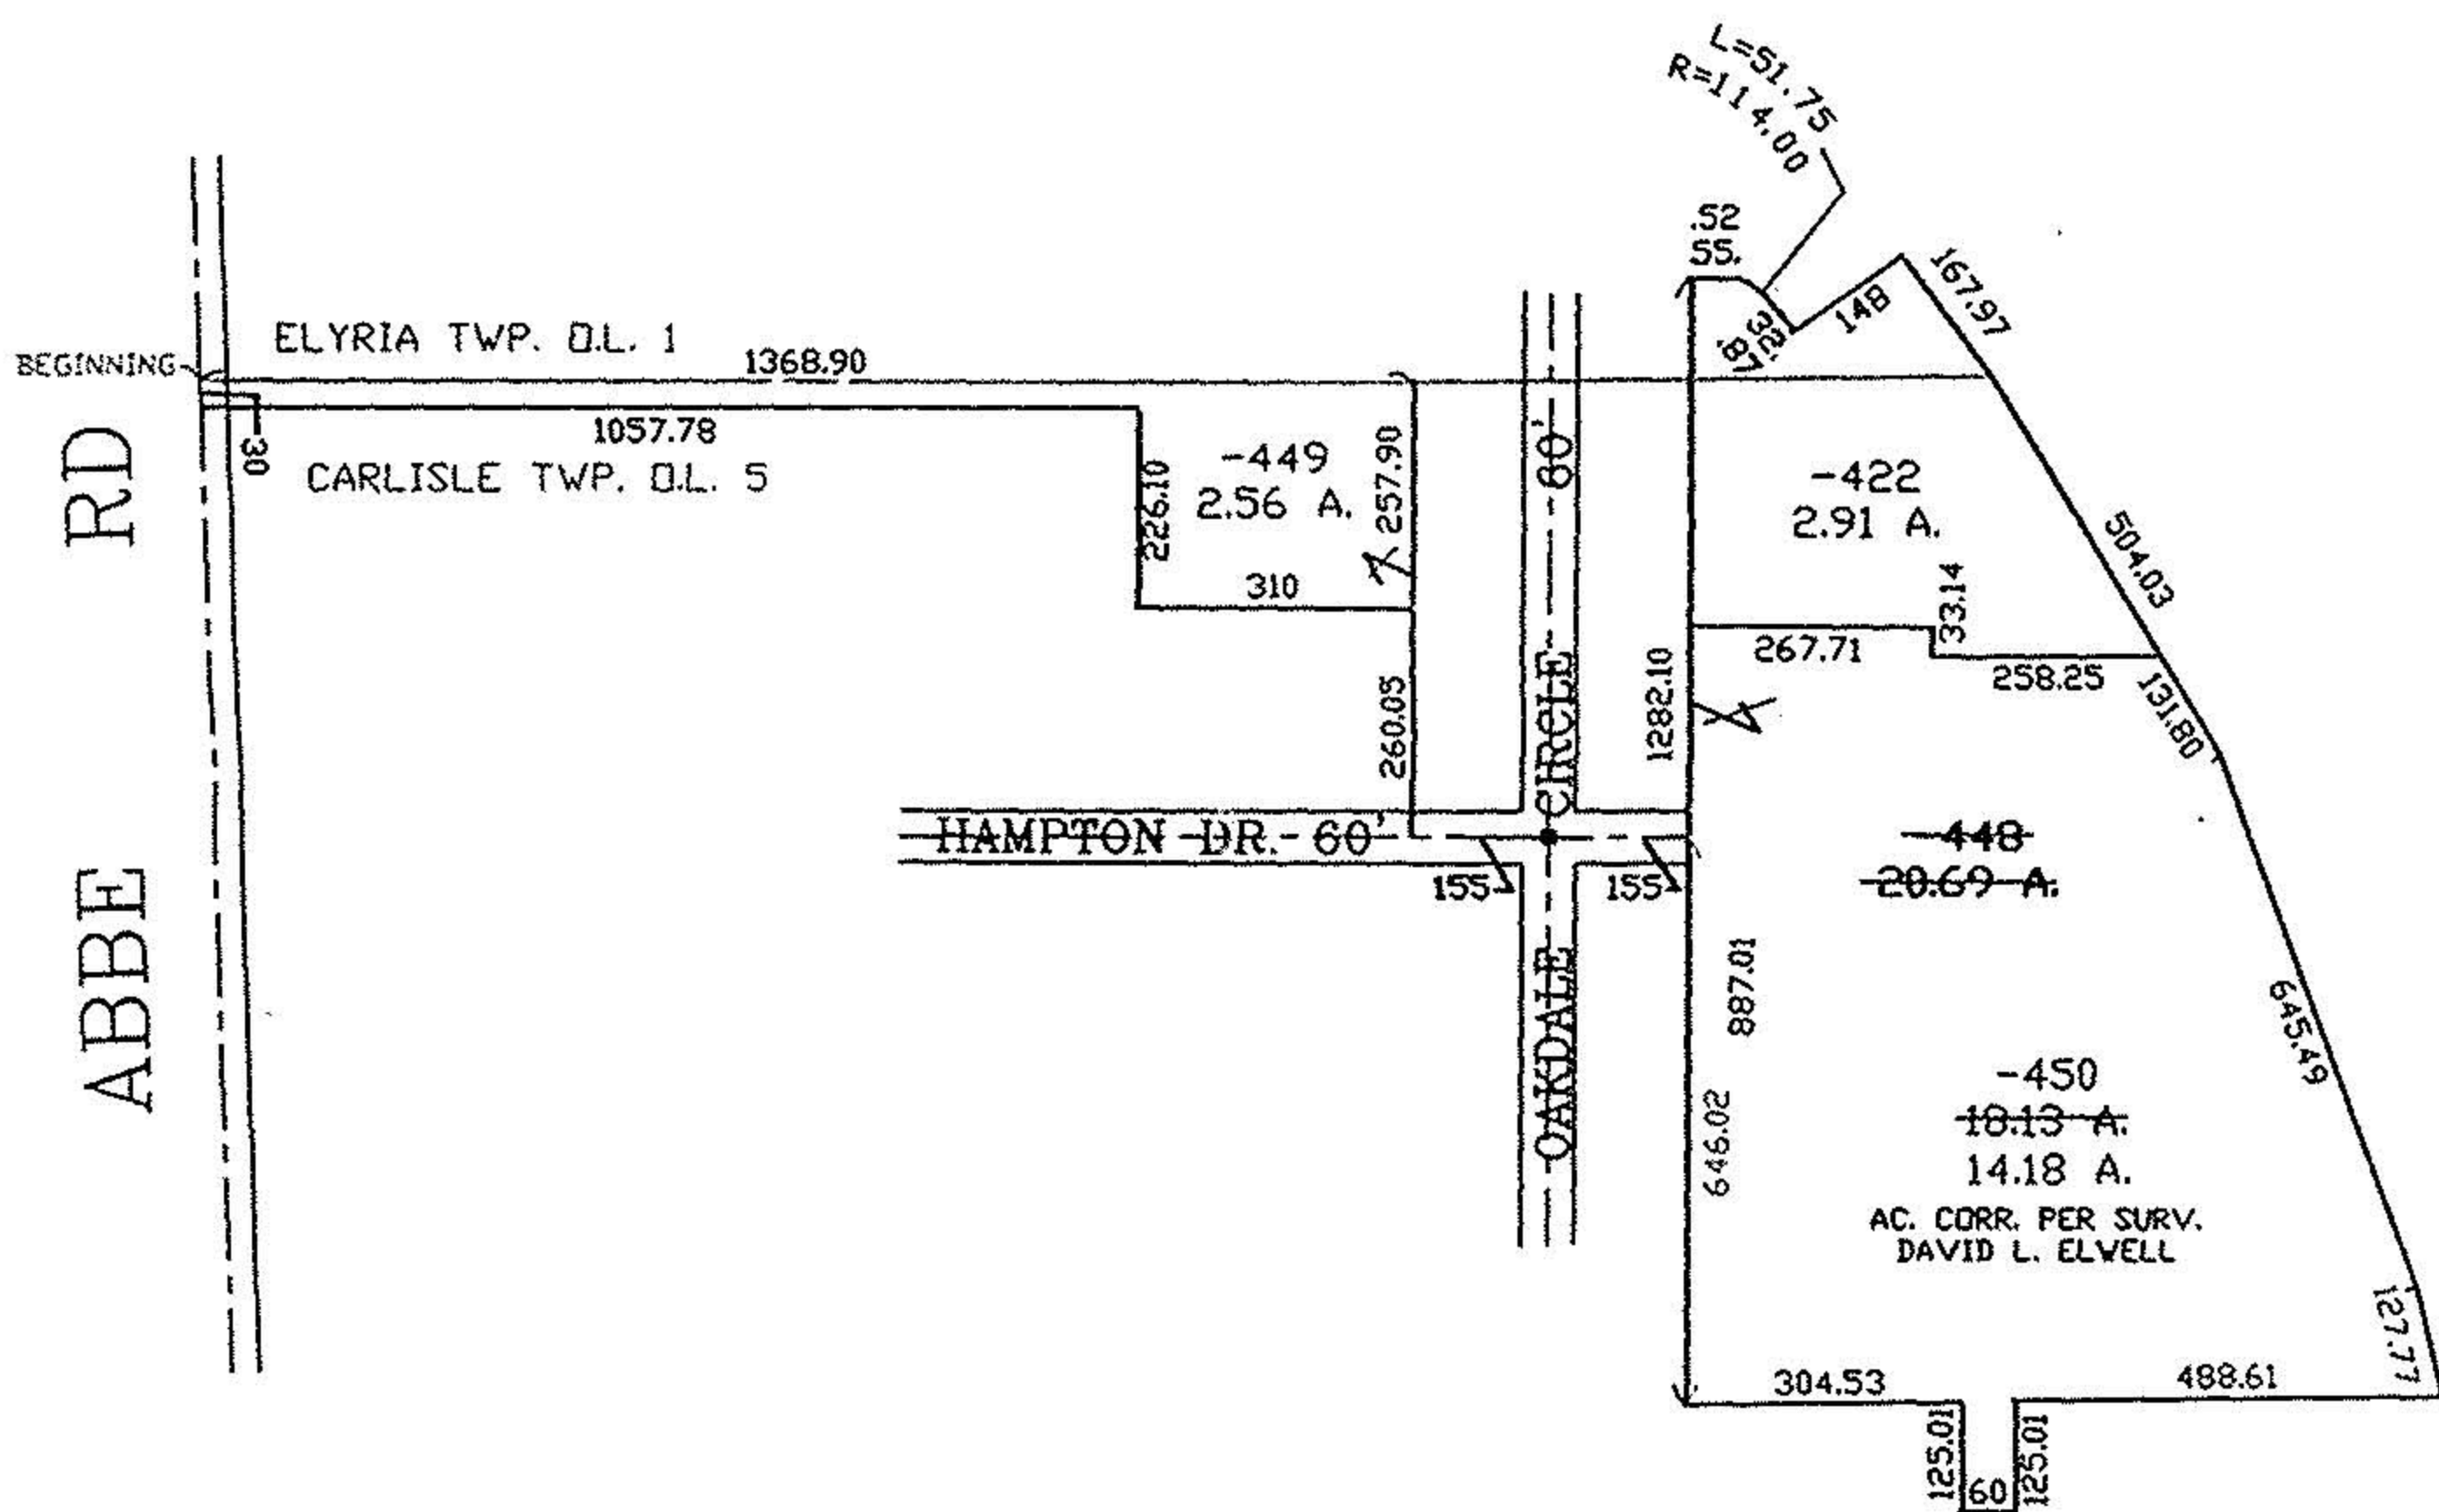


PARENT PARCEL: 10-00-005-102-448

CHILD PARCEL: NORTH LINE OF CARLISLE TWP. & CL OF ABBE RD.

STARTING POINT: CL OF ABBE RD. & NORTH LINE OF CARLISLE TWP. O.L. 5

NO. 00863

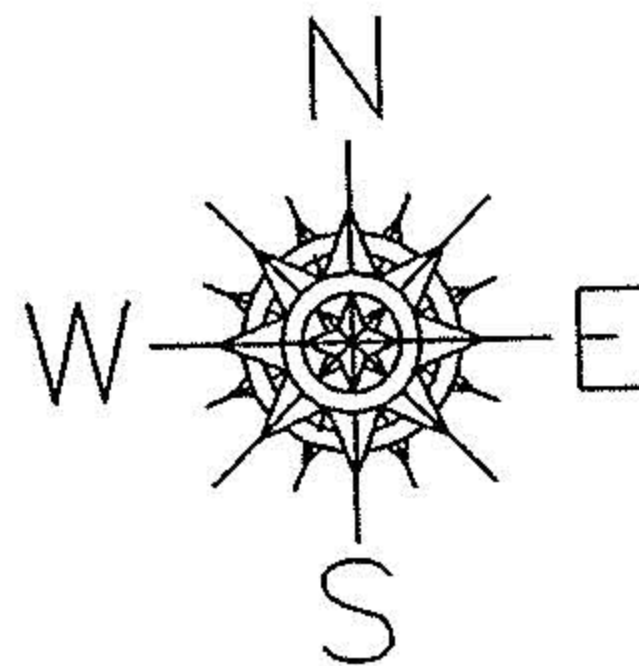

**SPLITS/DEEDS PROCESSED**  
 LORAIN COUNTY TAX MAP DEPARTMENT  
 226 MIDDLE AVE. ELYRIA, OHIO

SURVEYED BY: DAVID L. ELWELL  
 CLOSURE: 0.01 : 10.000  
 MAP PAGE(S): 10-00-005-C & D  
 APPROVED BY: TJS DATE: 9/24/01  
 SCALE: 1" = 400 PRIOR INSTRUMENT: 980529146