




LAUNDON • SIMON • CATE & ASSOC., INC.  
 CONSULTING ENGINEERS & SURVEYORS  
 504 MIDDLE AVENUE ELYRIA, OHIO 44035

RICHARD RENO

% TRANSOHIO SAVINGS

Orig. Lot 85	City of OBERLIN	Date 3-22-85 Scale 1"=6
Orig. Sec	Village of	Dwn. by R.G.S. Chkd. by J.C.
Tract	County of LOZAIN	Job No. 85-1357 F.B. 216/70
Township of RUSSIA	State of OHIO	Printed

SOUTH PROFESSOR ST. 60'

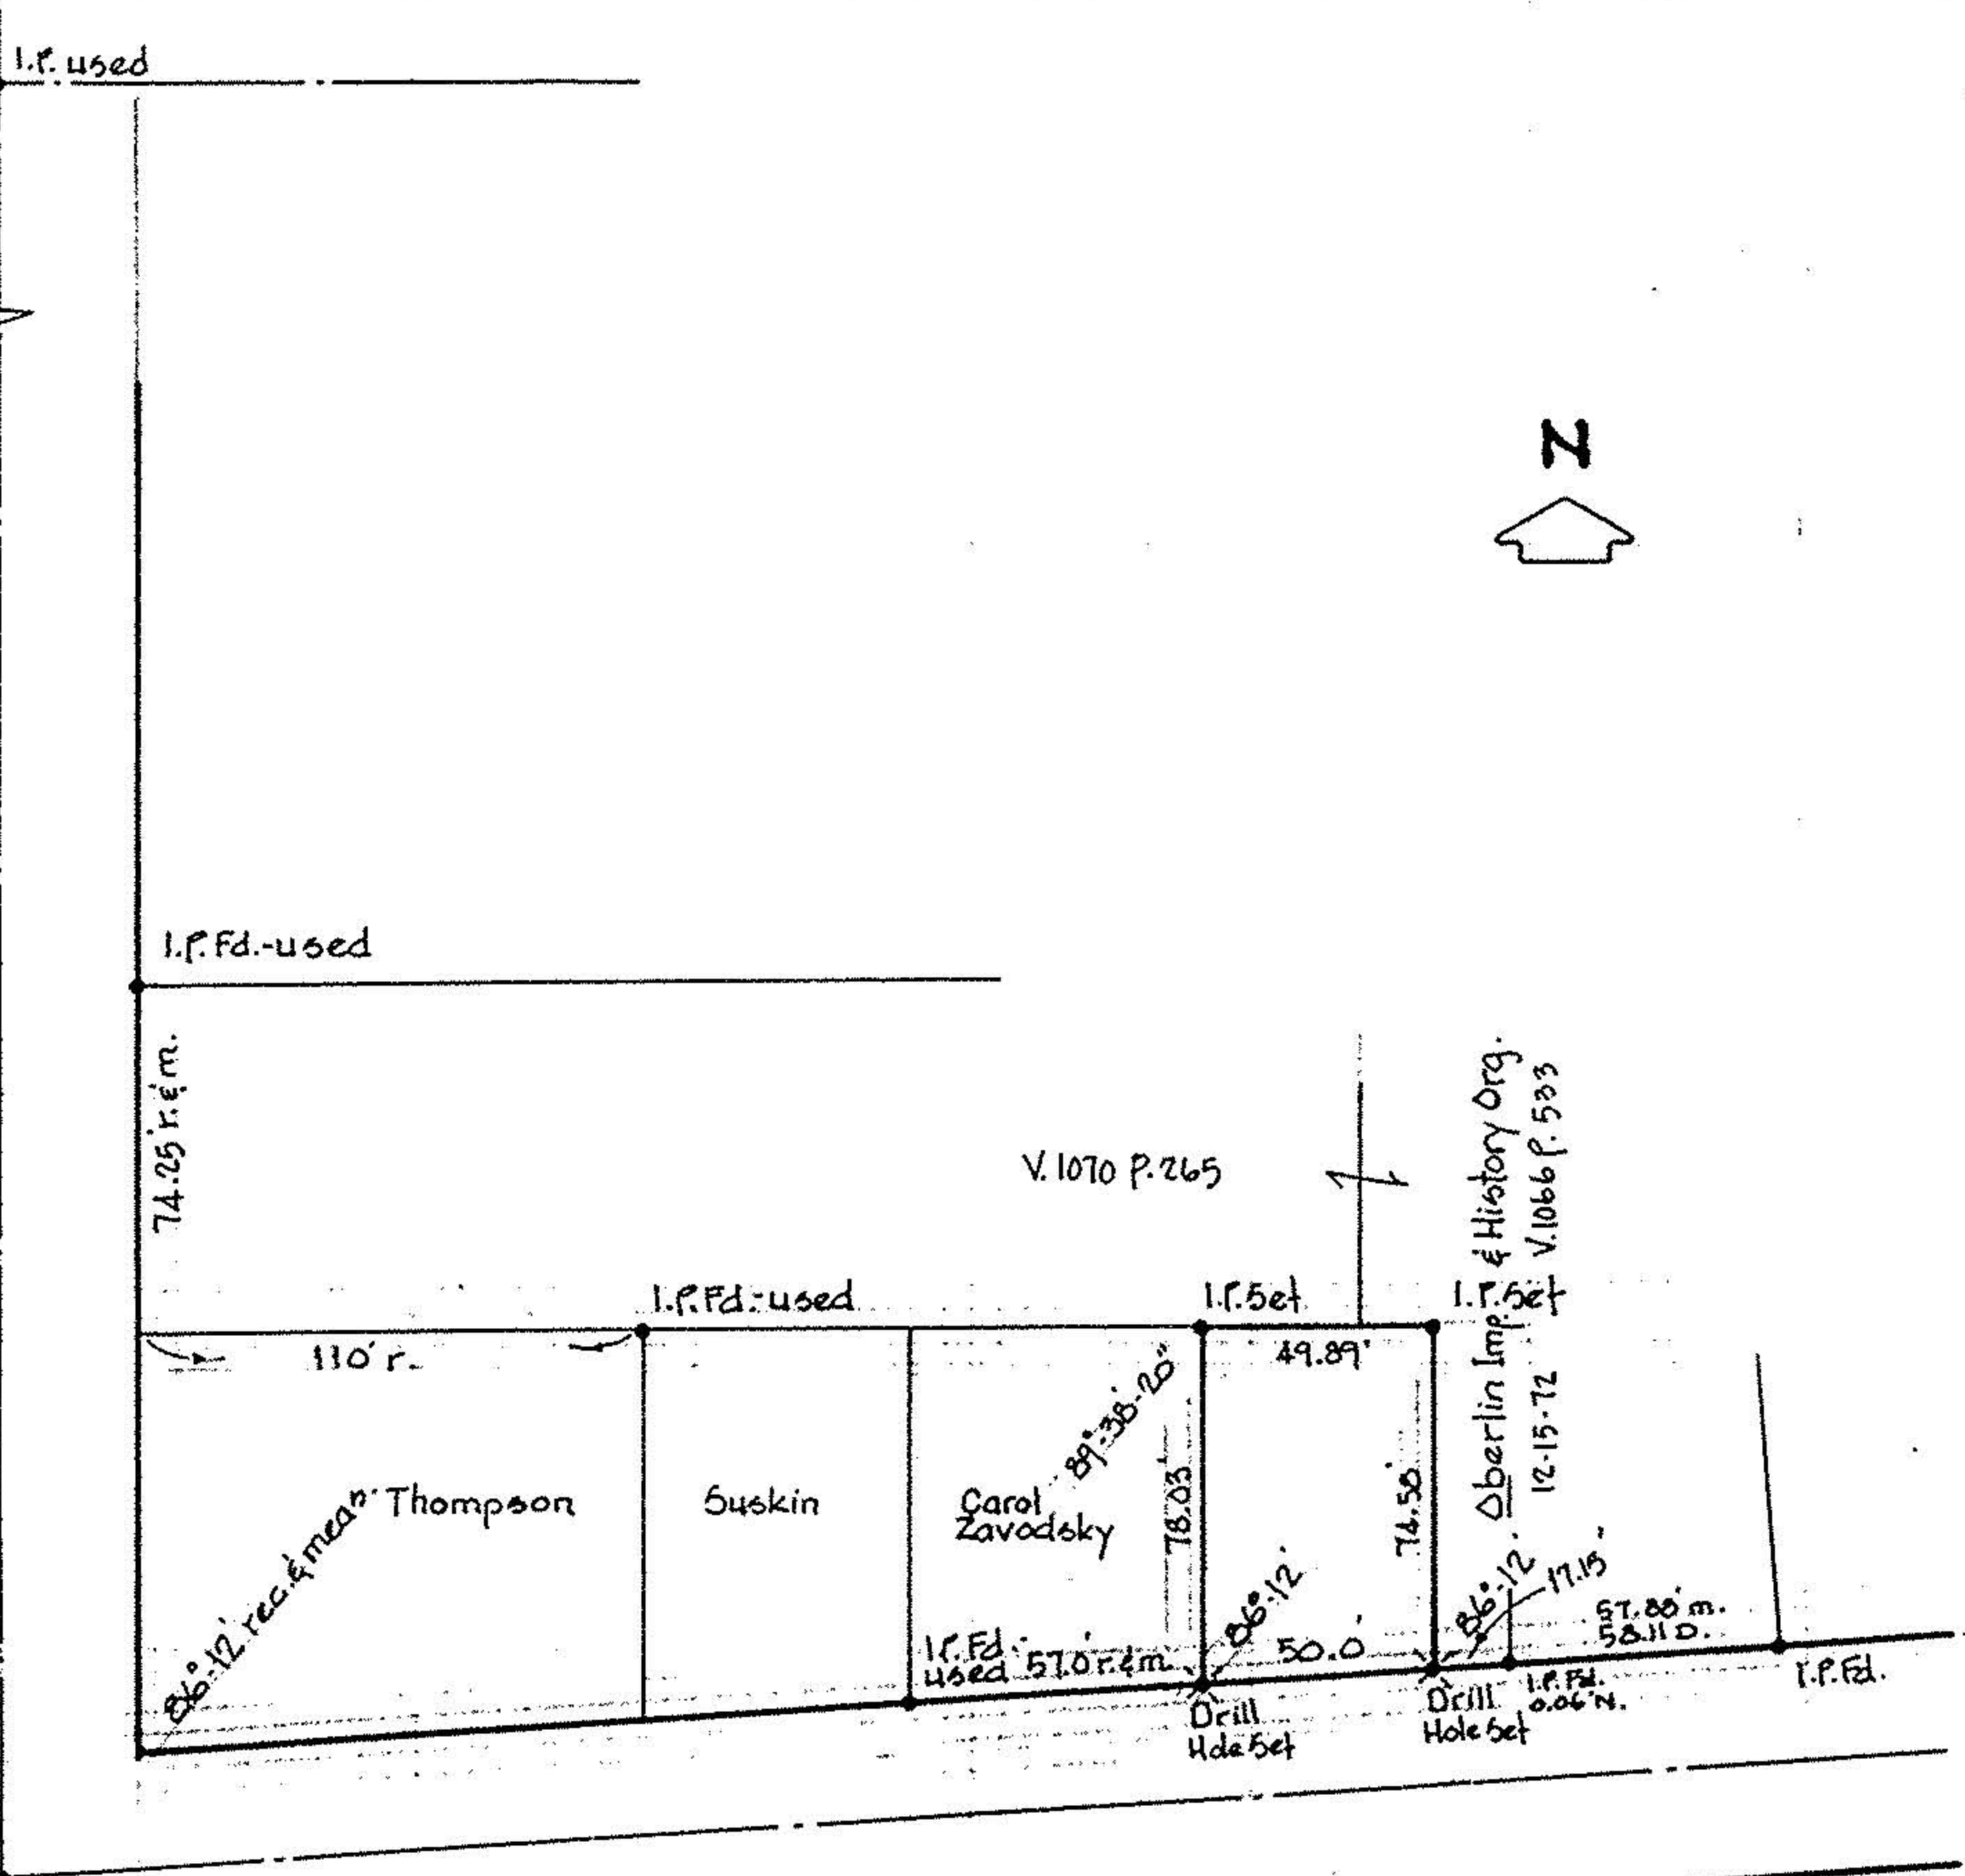

P.R. Spk. used

WEST VINE ST. 49.50'