

# MAP OF SURVEY AND LOT SPLIT

PREPARED FOR

**GARY L. AND A.J. JORDAN**

SITUATED IN THE TOWNSHIP OF HUNTINGTON, COUNTY OF LORAIN, STATE OF OHIO AND BE KNOWN AS BEING PART OF ORIGINAL HUNTINGTON TOWNSHIP TRACT 3. ALSO BEING PART OF THOSE LANDS DEEDED TO GARY L. AND A.J. JORDAN IN DEED INSTRUMENT NUMBER #20020870236 OF LORAIN COUNTY DEED RECORDS.

3/4" IRON PIPE  
FD. & USED

S 00°15'23" W 874.51' REC.

GARY L. & A.J. JORDAN  
P.P.#21-03-000-000-034  
DEED INSTR.#20020870236  
(REAPPOINTED 7/8/03)

I.P.S.

N 00°06'11" E 898.41' CALC.

DANNIE & MARY CANNON  
P.P.#21-03-000-000-067  
O.R. VOL.523 PG.581

S 89°59'37" E 650.06' REC.

S 89°59'37" E 650.82' REC.

S 89°59'37" E 651.58' REC.

N 89°59'37" W 652.35' REC.

N 89°59'37" W 653.11' REC.

BARN

PARCEL ONE  
6.8808 ACRES

CRIB

105

000

SHED

HOUSE

3/4" IRON PIPE  
FD. BENT 1.72' WEST

S 89°59'37" E 432.05' CALC.

S 89°17'00" E 432.08' CALC.

3/4" IRON PIPE  
FD. & USED

S 00°06'11" W 891.06' CALC.

N 00°08'11" E 350.00' CALC.

M.N.S.

M.N.F. & USED


ASHLAND - OBERLIN ROAD (STATE ROUTE 58)

60'

5/8" IRON PIN  
FD. (CAPPED)


## SURVEYOR'S STATEMENT

DISTANCE ARE EXPRESSED IN FEET AND DECIMAL PARTS THEREOF. BEARINGS ARE TO AN ASSUMED MERIDIAN AND ARE USED TO INDICATE ANGLES ONLY. PERMANENT MONUMENTS WERE FOUND OR SET AS INDICATED HEREON. I.P.S. INDICATES A 5/8" IRON PIN WITH IDENTIFICATION CAP SET. M.N.S. INDICATES A MAGNETIC NAIL SET. ALL OF WHICH I DECLARE TO BE CORRECT TO THE BEST OF MY ABILITIES AND BELIEF.

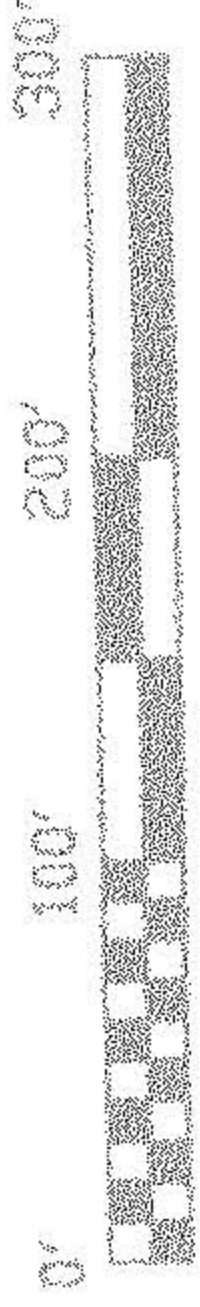

SCALE: 1" = 100'

#01678	
APPROVED LORAIN CO. MAINT DEPT	
DATE 6-10-04	
PAGE 21-F	
BY J.H.A. Field	
#04-01678	

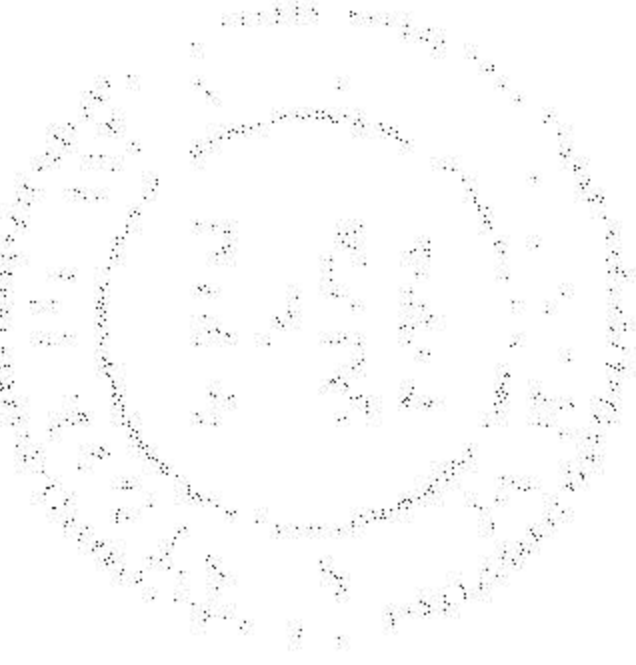

*Thomas M. Sneyek*  
THOMAS M. SNEZEK, R.L.S. #7051

4.15.04  
DATE