



(216) 642-8555
Fax (216) 642-1182
5415 Schaaf Rd.
Suite #204
Independence, OH 44131
http://www.campbellsurvey.com

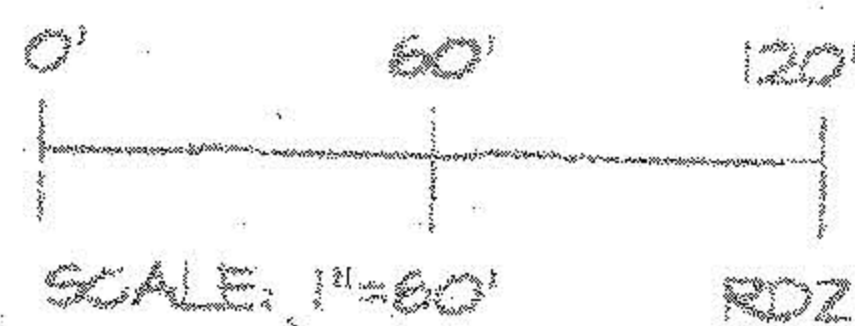

CAMPBELL &
ASSOCIATES, INC.
Surveying • Engineering

MORTGAGE LOCATION SURVEY

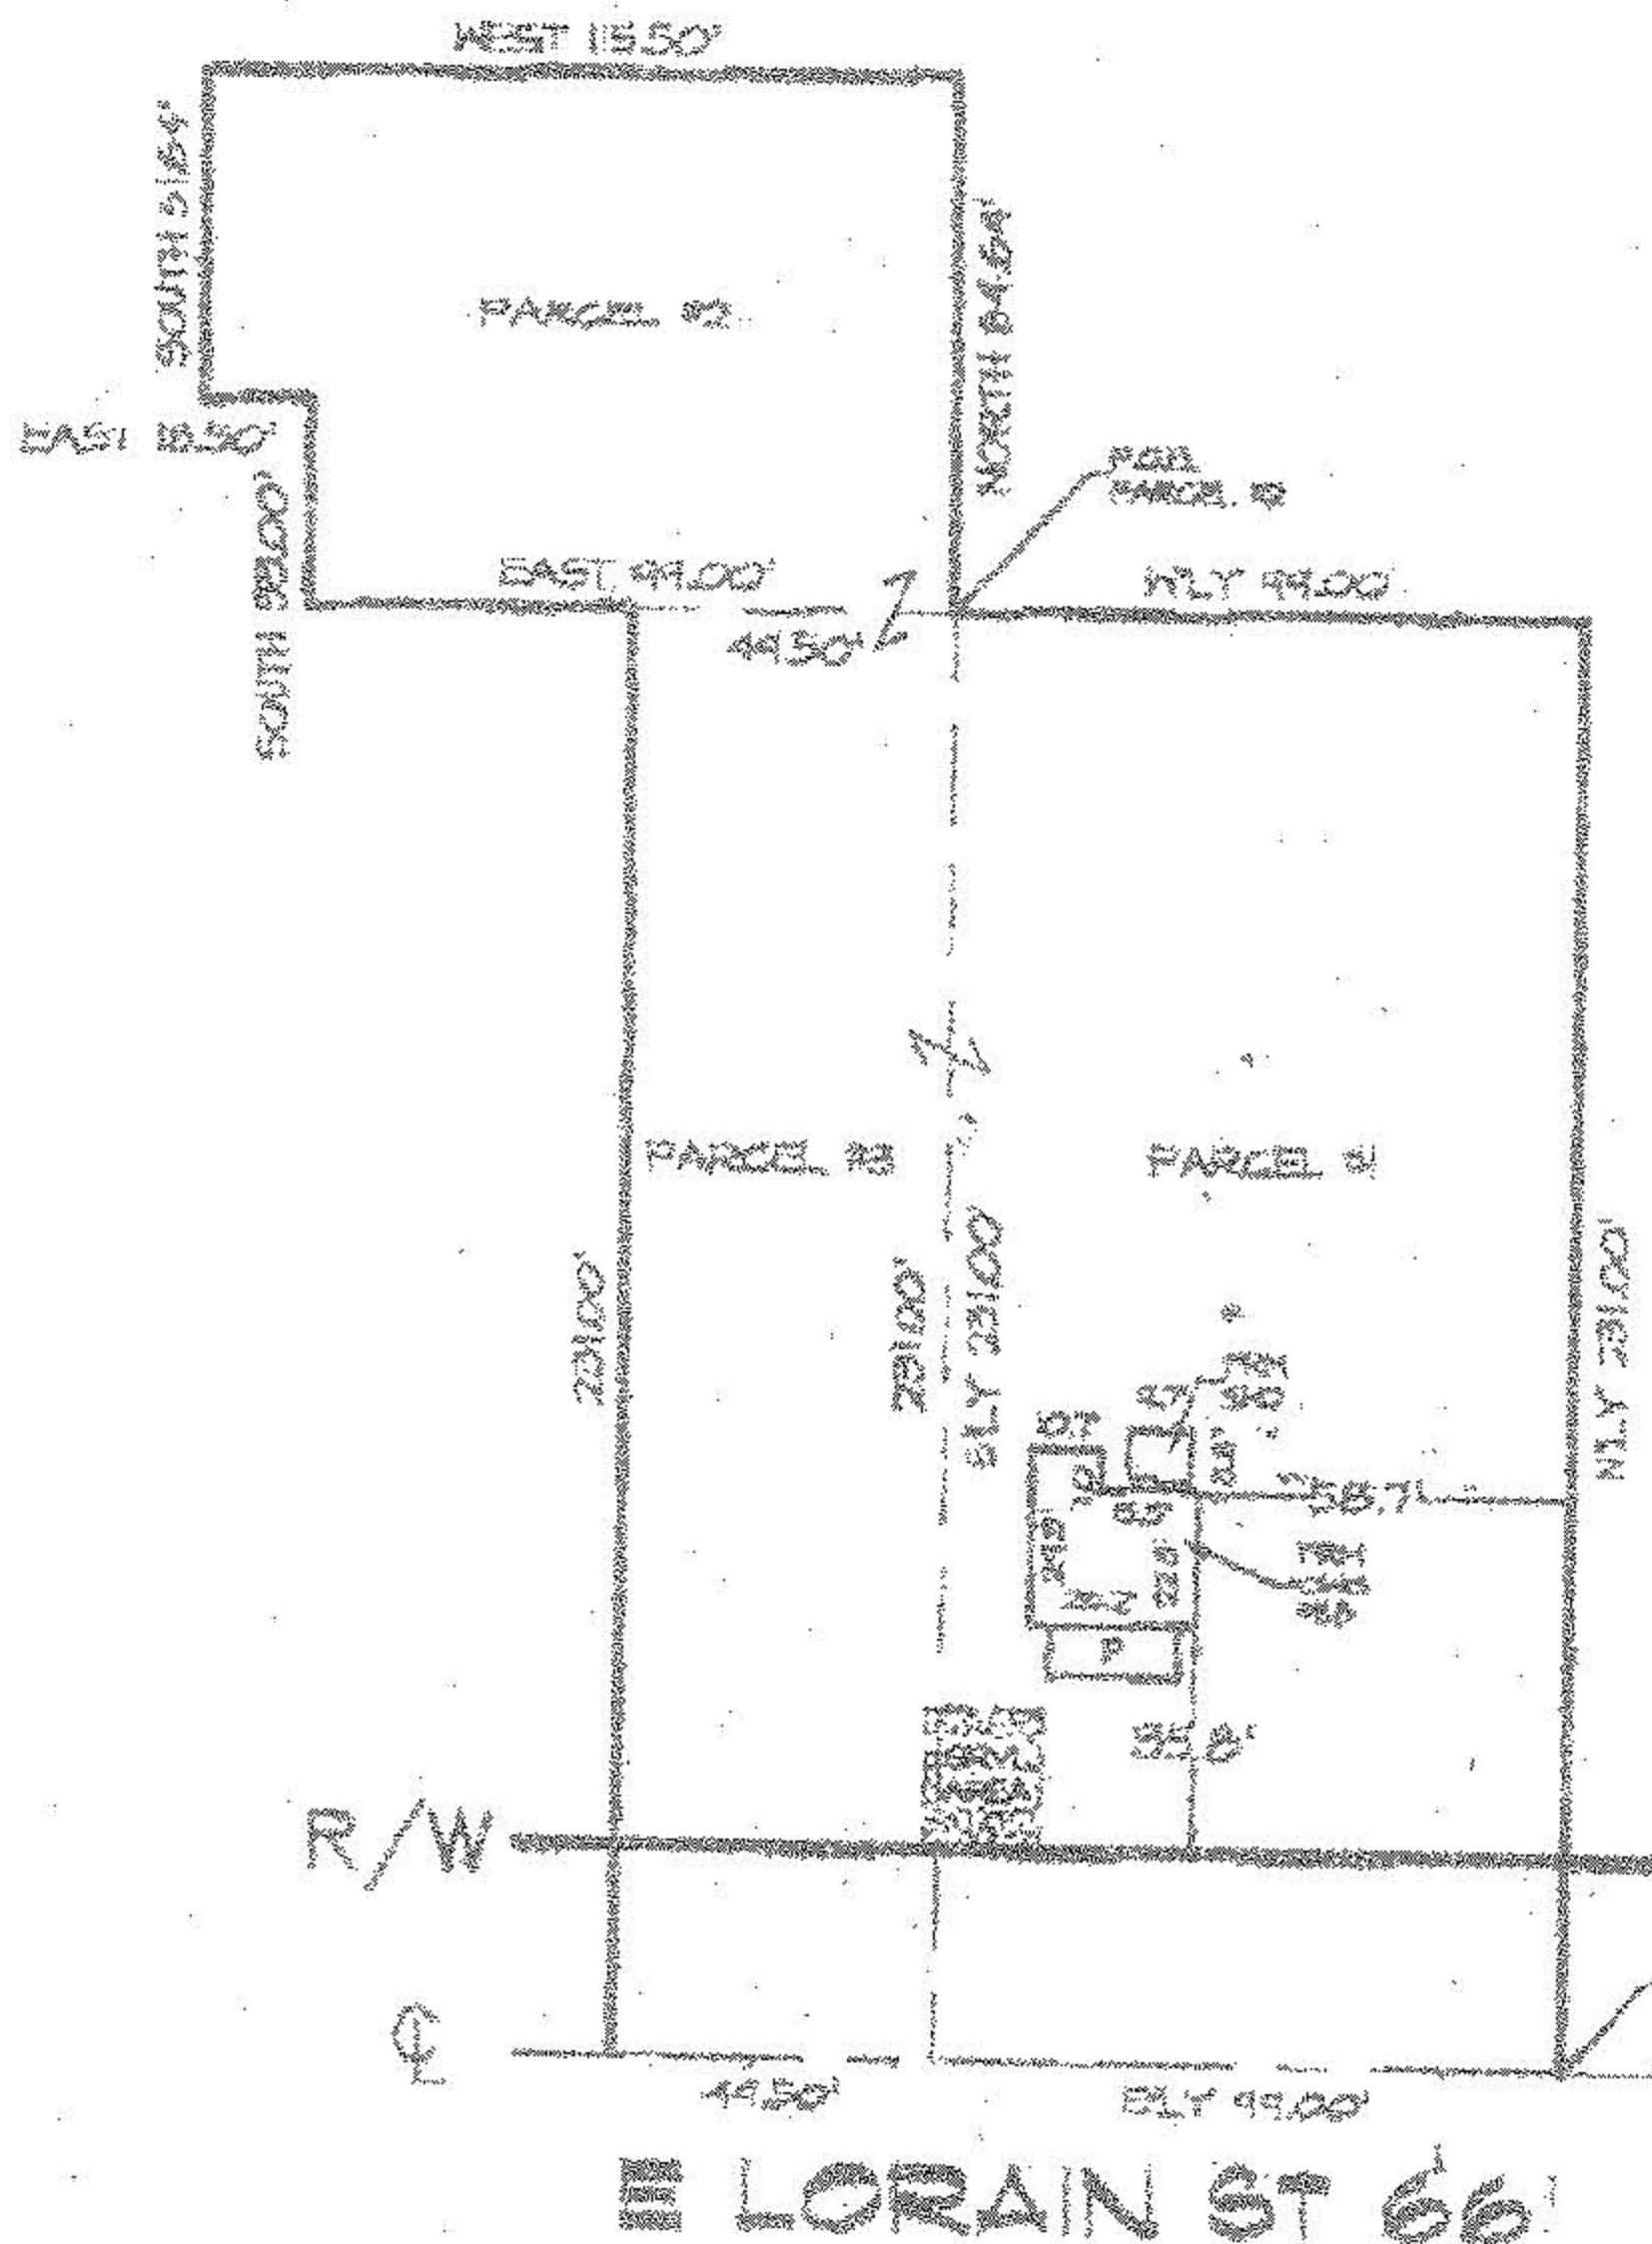

Address 118 East Lorain Street

Original Lot No. 117

State of Ohio, County of Lorain

Client Order No. 92070054

City of Oberlin

Date July 21, 1999

New Owner Joseph M. And Jeanne E. Miles

Present Owner Ronald Hamner

C & A Order No.
CL107389

This is to certify to Indy Mac and/or Title Co Title Agency Limited that a visual inspection of the property and buildings shown (if any) has been made and there are no apparent encroachments or visible easements unless otherwise shown. This service was not performed for the purpose of establishing boundary lines, and is not to be used for that purpose.

This Mortgage Location Survey has been prepared in accordance with Chapter 4733-38, Ohio Administrative Code, and is not a boundary survey pursuant to Chapter 4733-37, Ohio Administrative Code

Daniel J. Cook
Daniel J. Cook - Reg. Surveyor No. 7179