

RECEIVED

02-03-006-104-067

TM. Pg. 2-03-006-A

OCT 3 2002

AS-BUILT SURVEY OF

5939 SOUTH PARK DRIVE


LORAIN, OHIO FOR SCOTT LACHMAN

KENNETH P. CARNEY LORAIN COUNTY ENGINEER

Set 11 in by DOW Bohannon w/ no further instructions. 11-14-02

I HEREBY DECLARE THAT THE BUILDINGS SITUATED ON THE DESCRIBED REAL ESTATE ARE LOCATED ON AND WITHIN THE BOUNDARIES OF SAID PREMISES UNLESS SHOWN OTHERWISE. THIS AS-BUILT SURVEY IS MADE IN ACCORDANCE WITH OHIO ADMINISTRATIVE CODE. DIMENSIONS SHOWN ON THIS PLAN ARE EXPRESSED IN FEET AND DECIMAL PARTS THEREOF. BEARINGS ARE SHOWN TO AN ASSUMED MERIDIAN AND ARE INTENDED TO INDICATE ANGLES ONLY; ALL OF WHICH I CERTIFY TO BE CORRECT TO THE BEST OF MY KNOWLEDGE.

EDWARD B. DUDLEY P.S. No. 6747 OCTOBER 2, 2002 DATE

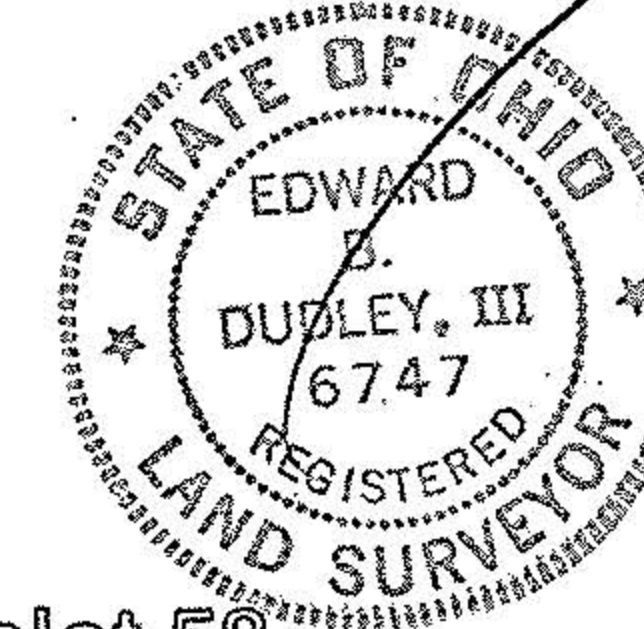

Sublot 58

Vacant Lot

Oakhill Farms Subdivision Volume 50, Page 39 Lorain County Map Records

Sublot 56

Vacant Lot

"AS-BUILT" CONTOUR: 10-2-2002

PROPOSED CONTOUR PER SITE PLAN

"AS-BUILT" ELEVATION: 10-2-2002

PROPOSED ELEVATION PER SITE PLAN

LEGEND

Legend table with symbols for various features: Storm Manhole, Catch Basin, Storm Sewer Easement, etc.

CURVE TABLE with columns: CURVE, BEARING, LENGTH, CHORD, DELTA, RADIUS. Includes curves C1, C2, and C3.

SOUTH PARK DRIVE 60'

Scale: 1"=40'

8 WORKING DAYS BEFORE YOU DIG CALL TOLL FREE 800-362-2764 OHIO UTILITIES PROTECTION SERVICE

RIVERSTONE LAND SURVEYING - ENGINEERING - DESIGN

2530 SUPERIOR AVENUE - SUITE 703 CLEVELAND - OHIO - 44114 PHONE: (216) 241-7070 FAX: (216) 241-7071 WWW.RIVERSTONE.COM