


CLARK ROAD 40'

12-06-4
 12-00-004-000
 LAVENE BRADY
 VOL. 319 PG. 174
 L.C.D.R.

12-00-004-000-005
 12-00-004-B
 8-00-000-00-211
 926L

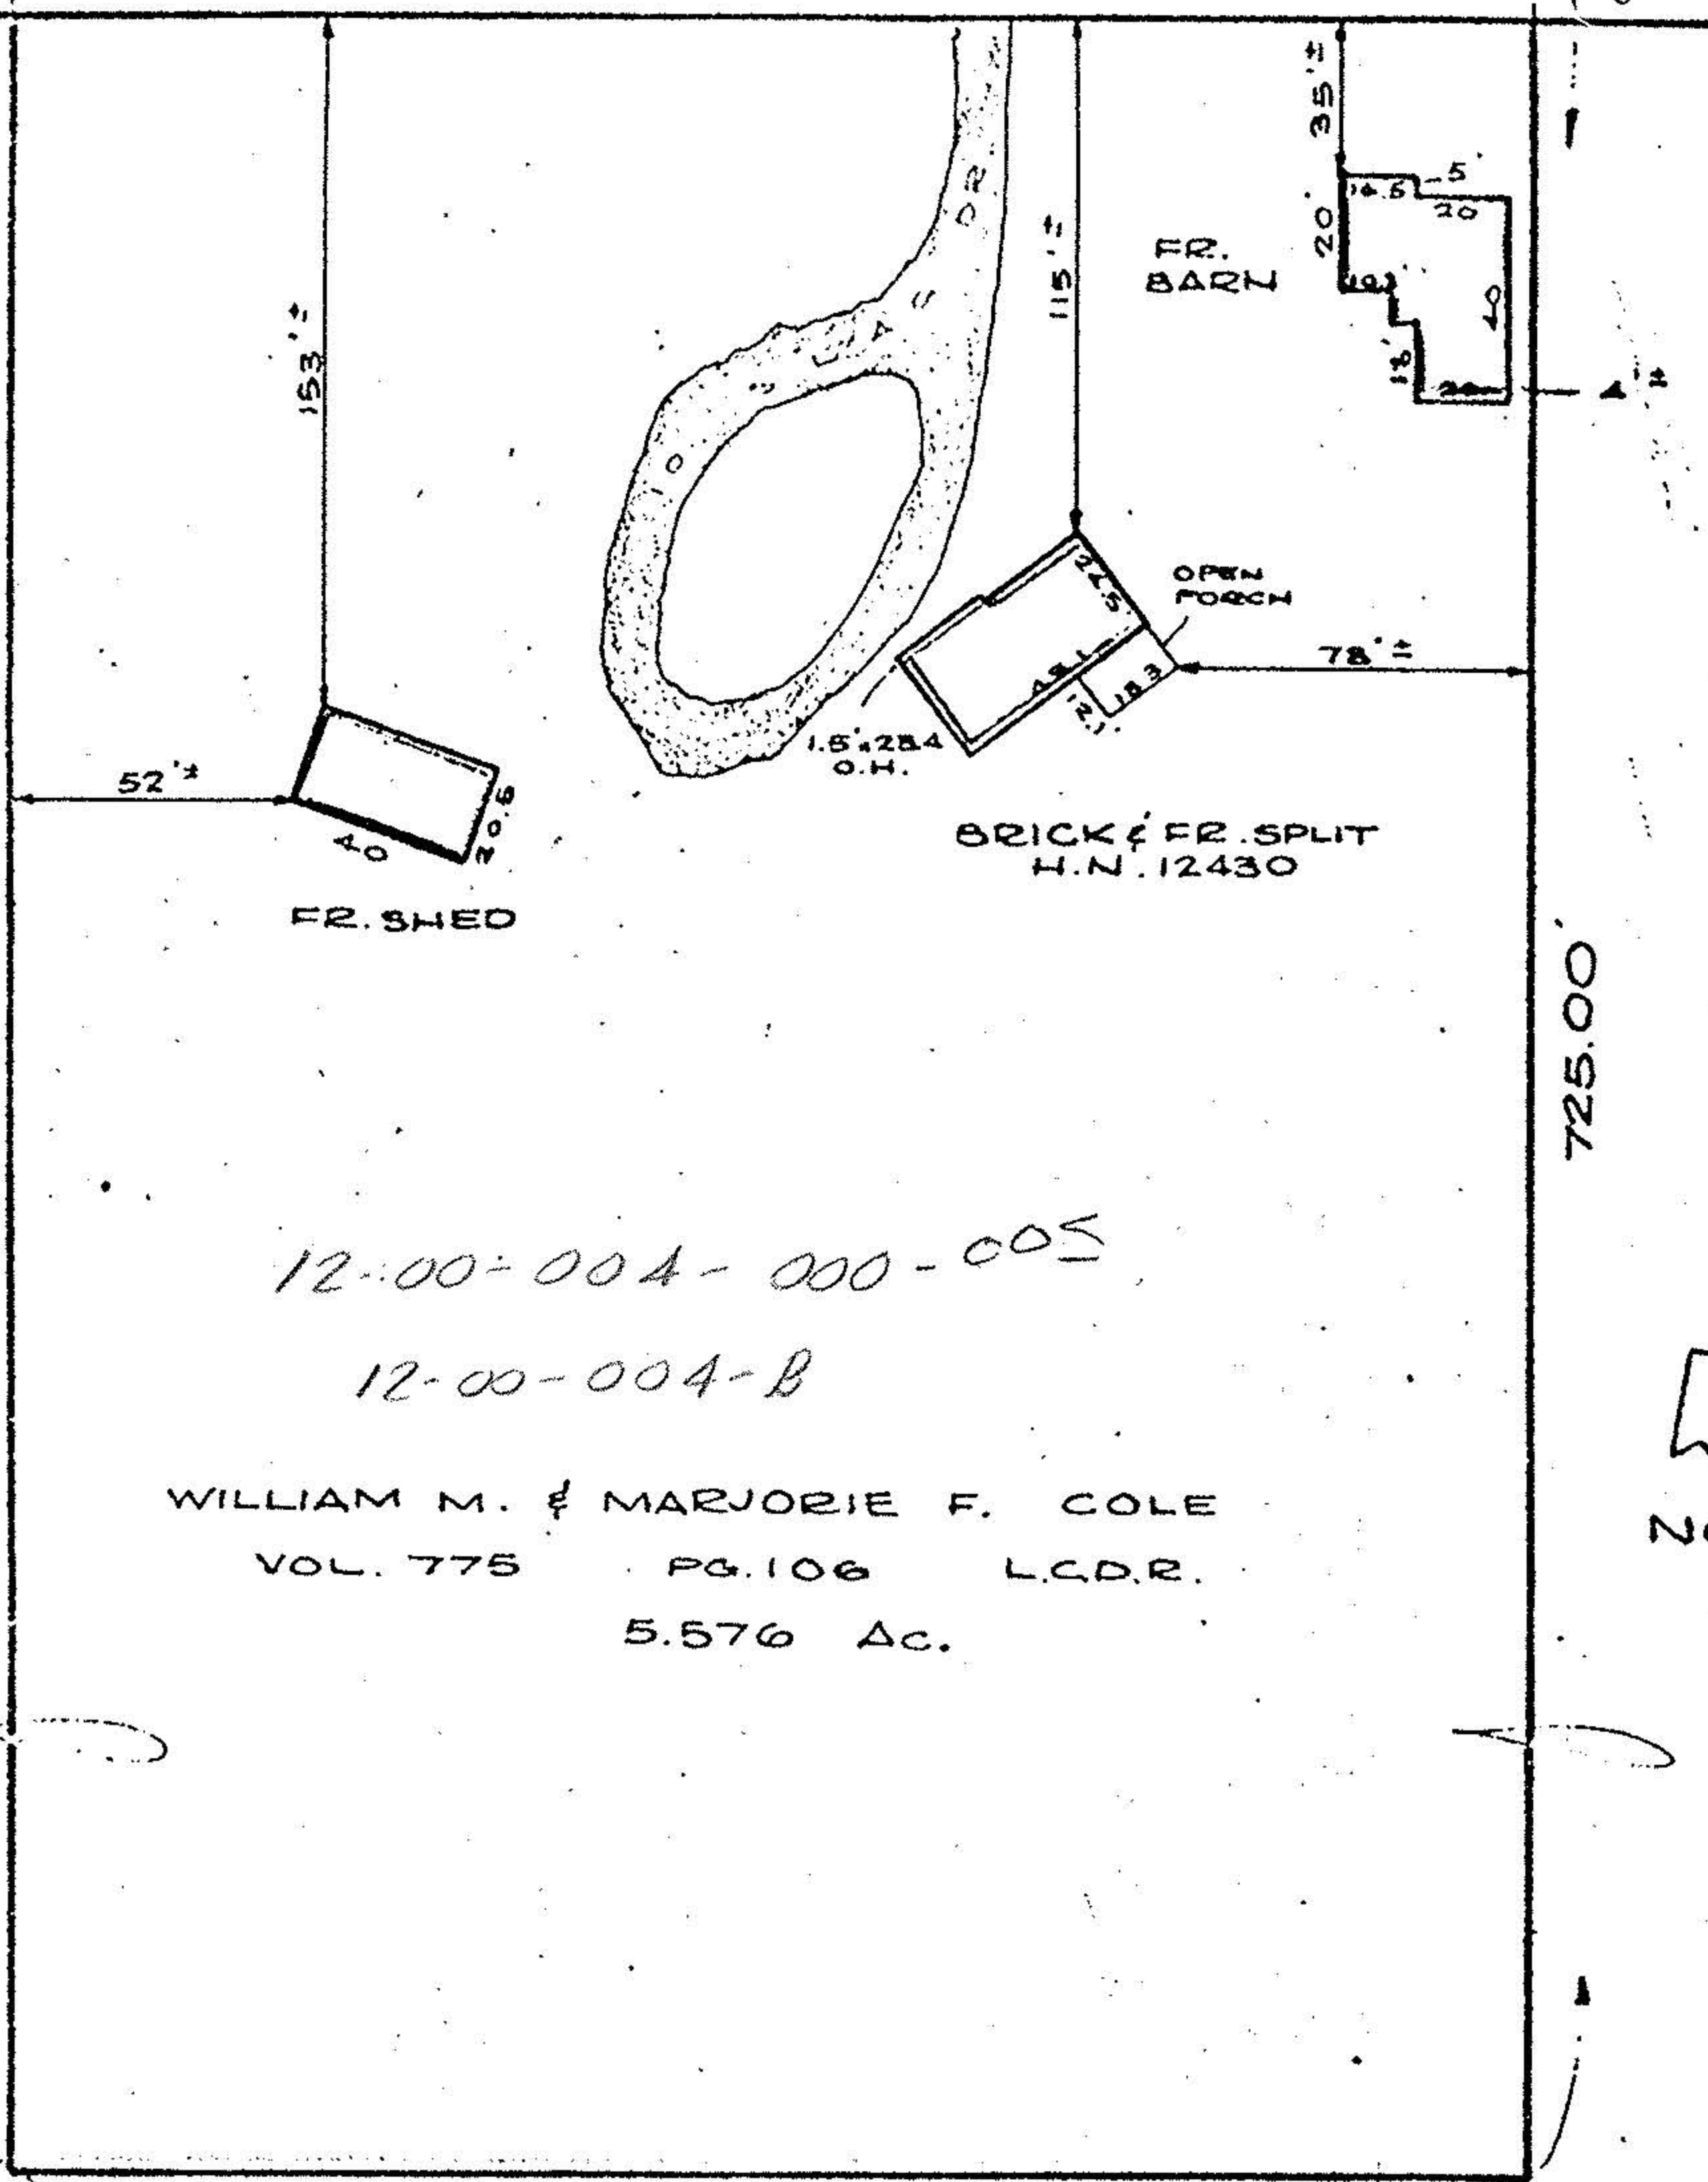

WILLIAM M. & MARJORIE F. COLE
 VOL. 775 PG. 106 L.C.D.R.
 5.576 Ac.



NEFF & ASSOCIATES Consulting Engineers and Surveyors CLEVELAND - ELYRIA, OHIO

This MORTGAGEE'S INSPECTION was prepared for IDENTIFICATION PURPOSES for the MORTGAGEE in connection with a new mortgage, and is not intended or represented to be a land or property line survey. No corners were set. Do not use for establishing fence or building line.

SCALE	1" = 60'
DATE	4-16-74
JOB No.	27080
TITLE No.	E-4869