
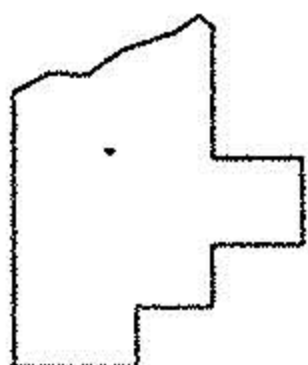
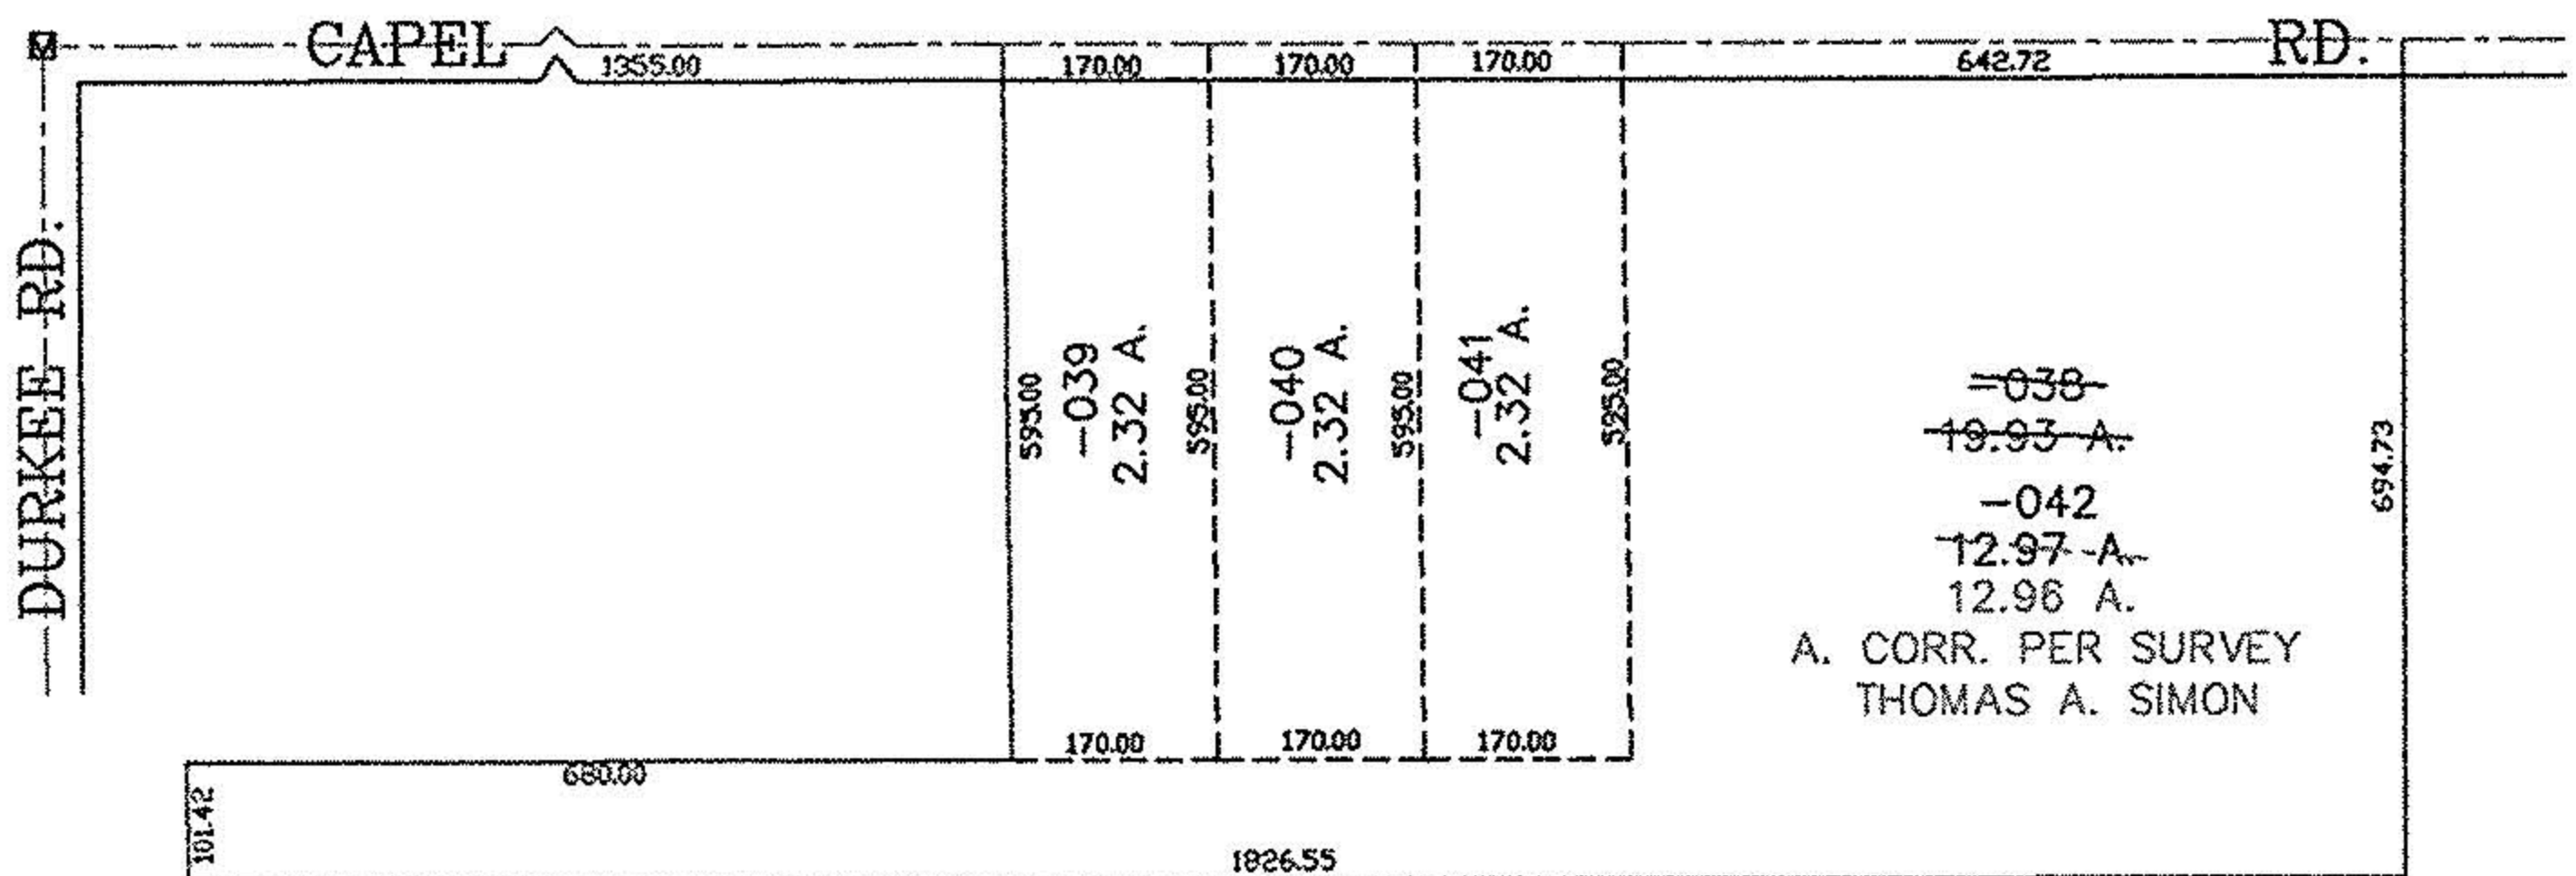


PARENT PARCEL: 11-00-078-000-038

CHILD PARCEL: 11-00-078-000-039 THRU -042

STARTING POINT: CENTERLINE OF DURKEE RD. & CAPEL RD.

NO. 01686

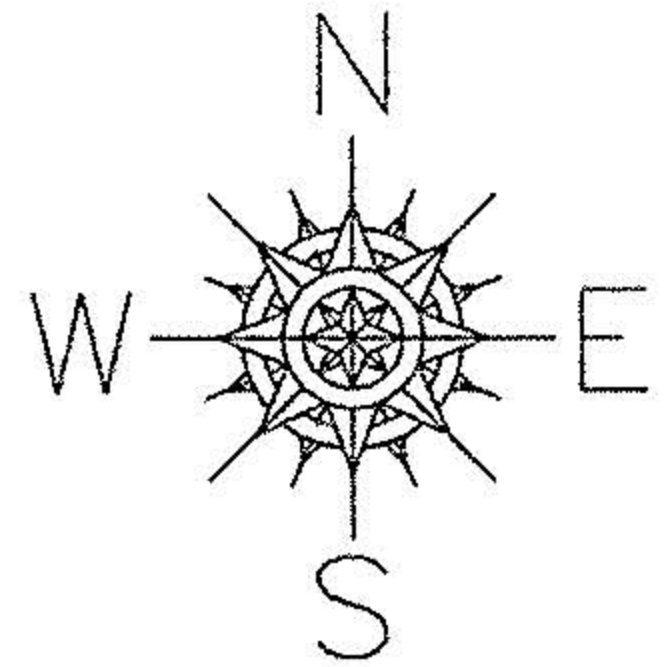

SPLITS/DEEDS PROCESSED
 LORAIN COUNTY TAX MAP DEPARTMENT
 226 MIDDLE AVE. ELYRIA, OHIO

SURVEYED BY: THOMAS A. SIMON
 CLOSURE: 0.00 : 10.000
 MAP PAGE(S): 11-00-078-B
 APPROVED BY: JAH DATE: 6-23-04
 SCALE: 1" = 300 PRIOR INSTRUMENT: 20040006545