

State of Ohio
Registered Professional
Engineer and Surveyor

THOMAS W. LAUNDON

CIVIL ENGINEER AND SURVEYOR

ELYRIA - OHIO

Municipal Engineering
Survey - City, Farm,
Lot Subdivisions



S 6:03:10' W
1689.34

19.149 Acres

1682.46 meas.
Charles L. & Julia Burk
by U.S. 440 5-27-26

I.P. set

495.0

S 88:22:10' W

7.995 Acres

I.P. fd. 0.86 W

S 88:22:10' W

495.07


I.P. fd. 0.45 E

Survey for The Land Title Guarantee & Trust Co.
Lands of W.R. & Mary Jane Anderson, 7.995 Ac. parcel
Lands of Gordon Bartler to be conveyed to
W.R. & Mary Jane Anderson, 19.149 Ac. parcel.
Part of Orig. Lot. 16 Columbia Twp. Lorain Co. Ohio.

Scale 1"=300'

Jan. 13, 1946

T.W. Laundon Registered Surveyor

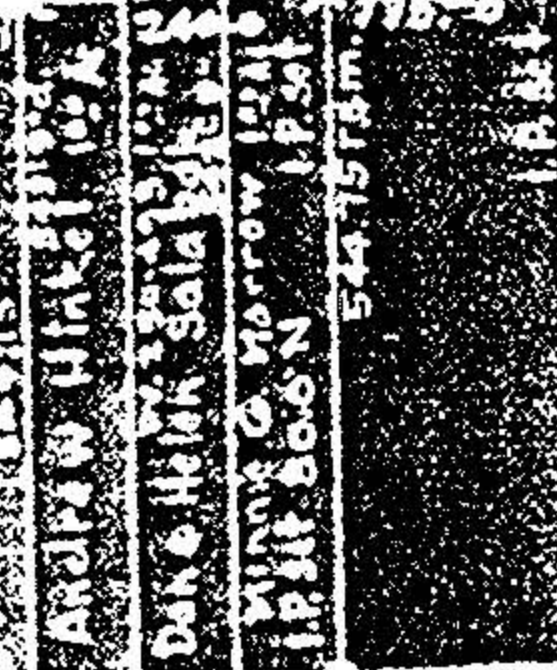

Louis Brudowitz
fence occupation used
first old post N. of rd.

Twinsburg-Elyria Road