



ROYAL CREST GOLF CLUB INC.
DEED VOL. 964, P. 643
20.37 AC. ORIG., 20.026 AC. REM.

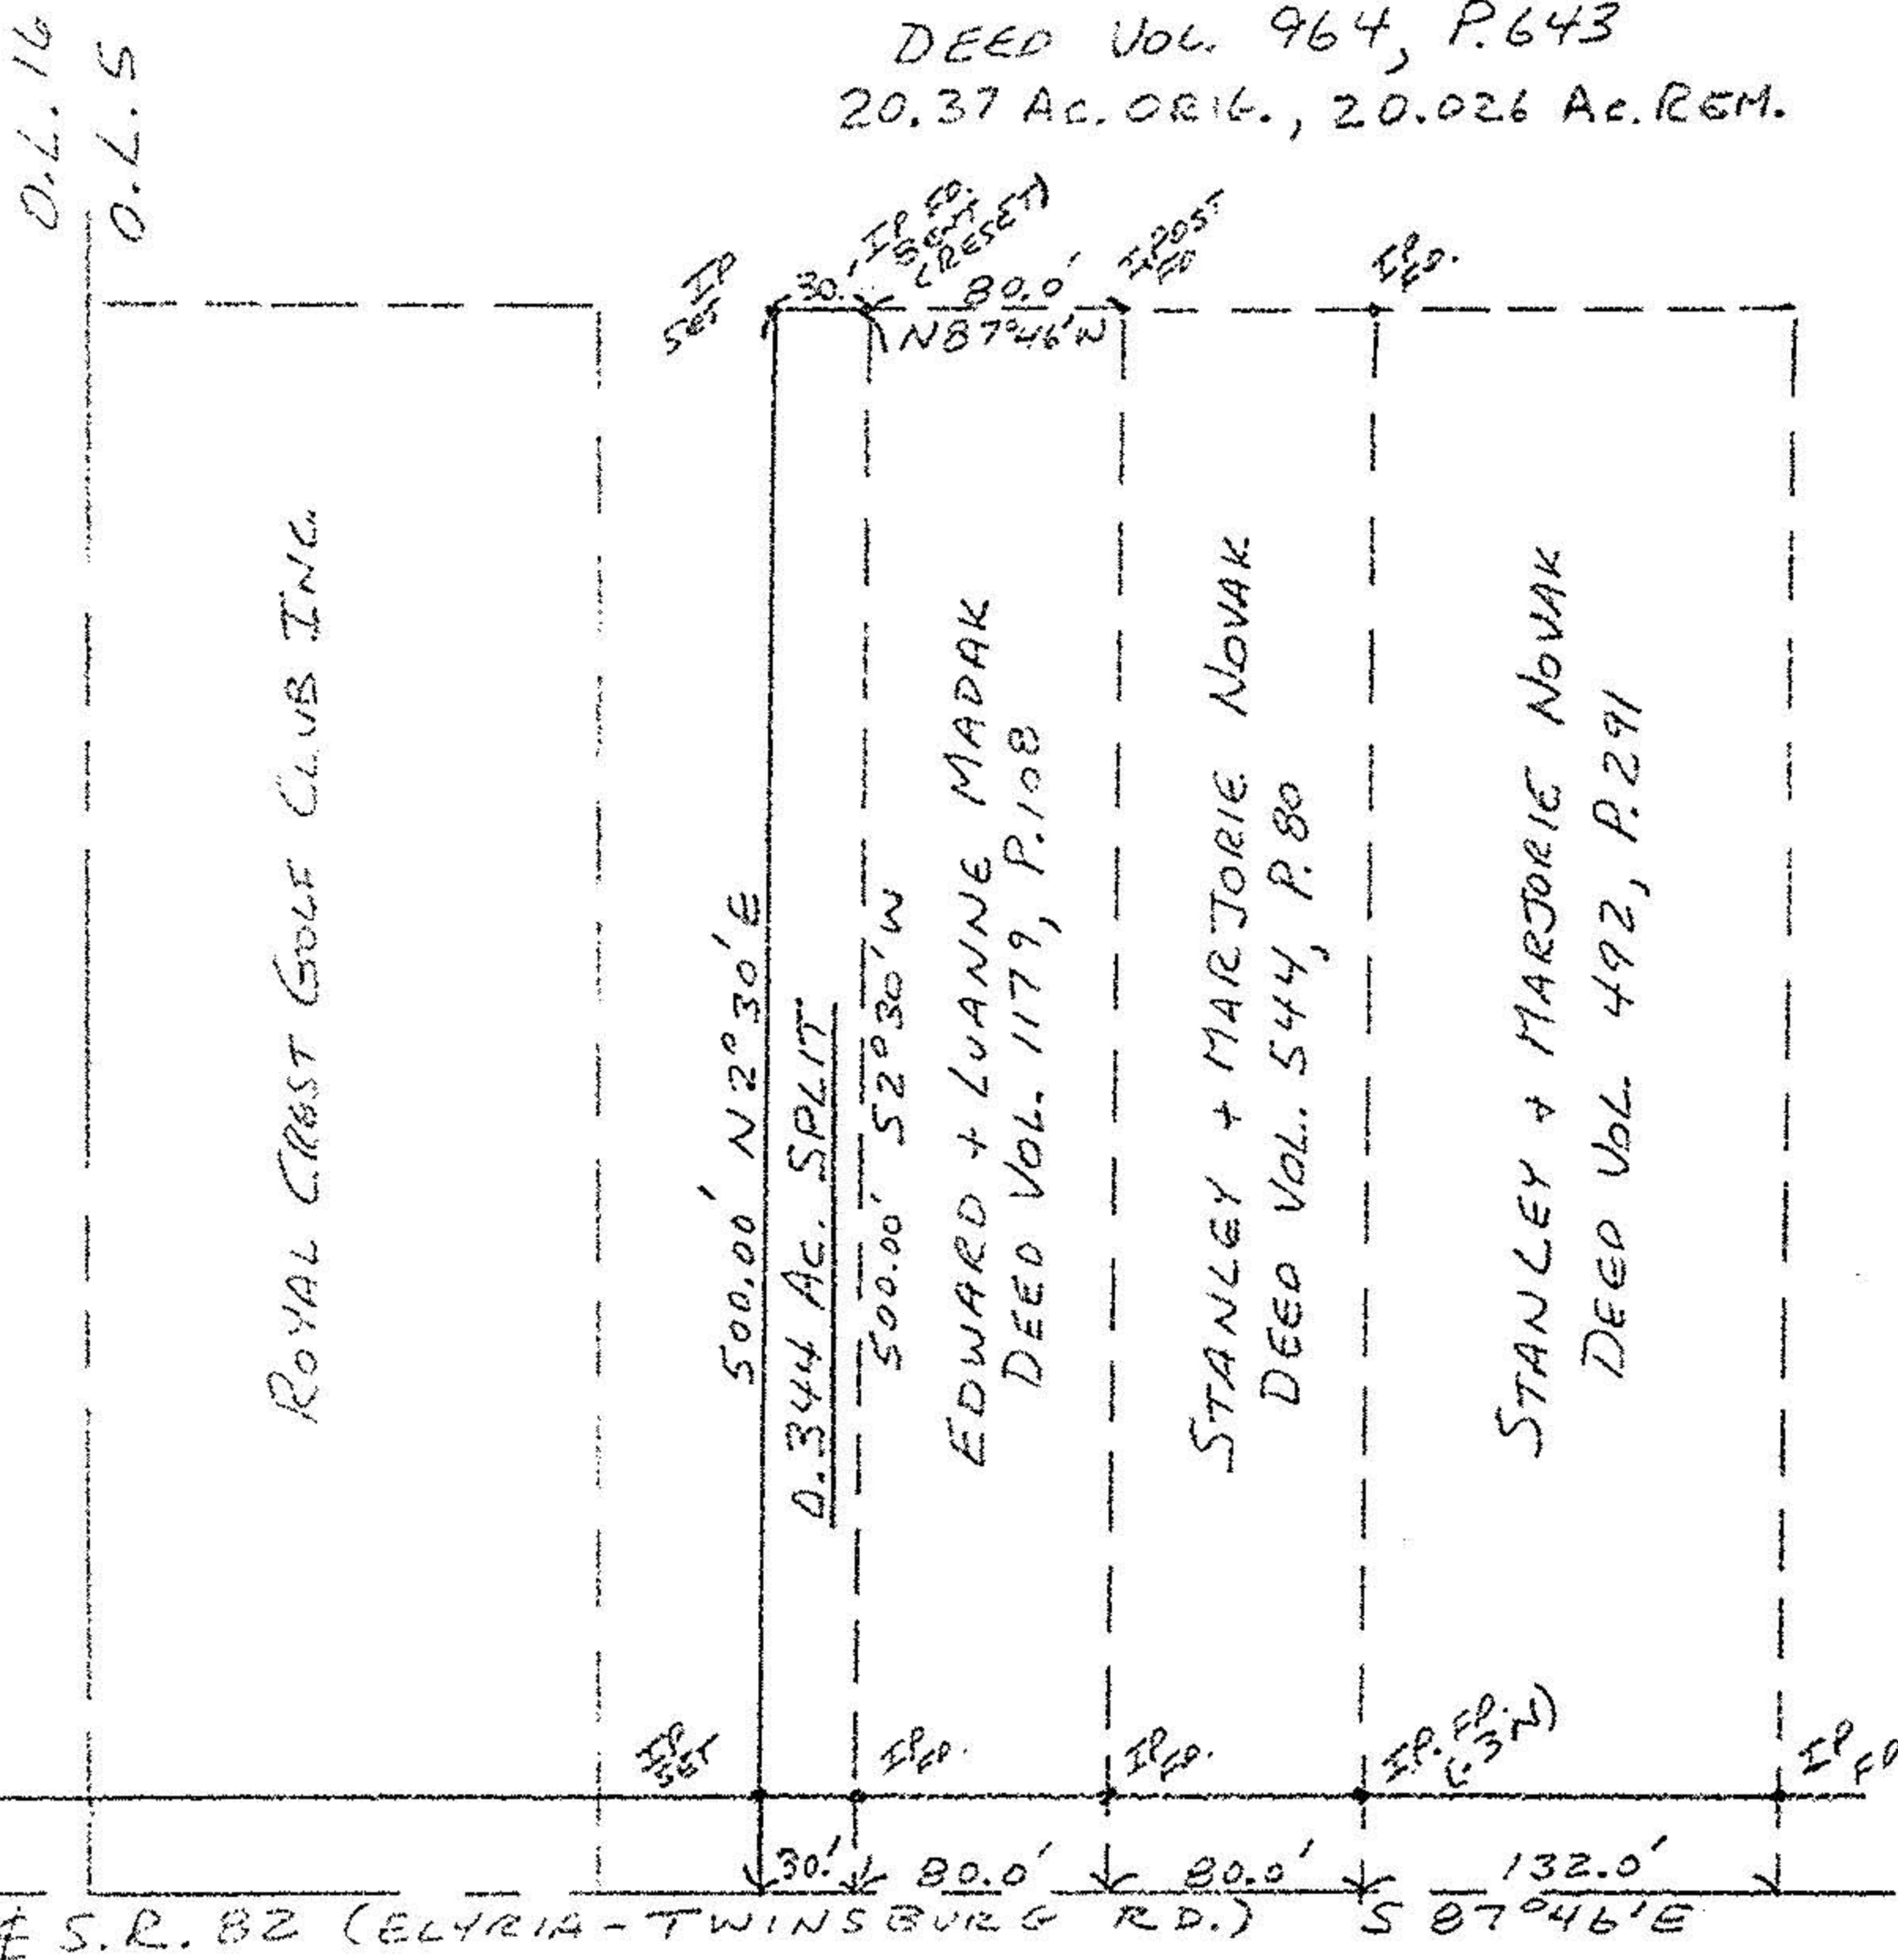

NORTH
SCALE 1"=100'

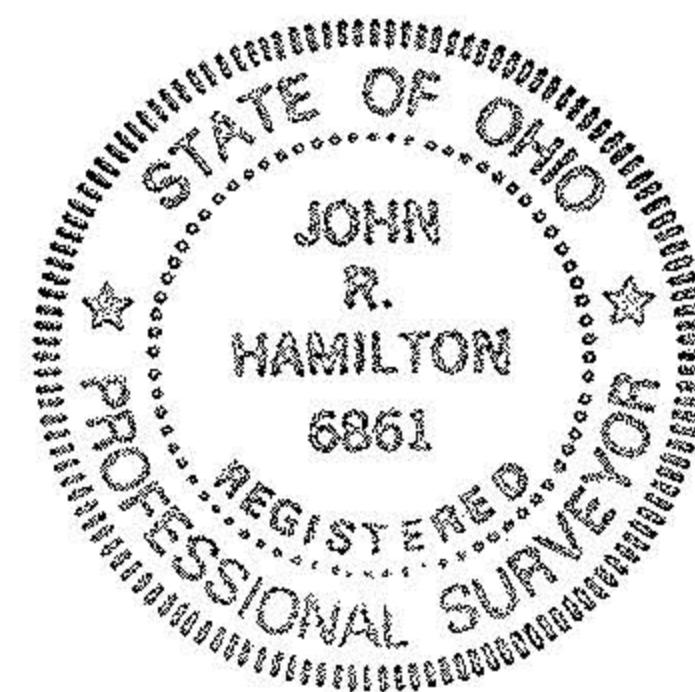

#17977

APPROVED
LORAIN CO.
MAP DEPT.
DATE 6-7-88
PAGE 12-00-005A
BY PAUL FRANCIS
VOID AFTER <input checked="" type="checkbox"/> 17977

MAP OF SURVEY OF 0.344 AC.
SPLIT FOR EDWARD MADAK
D.L. 5 - COLUMBIA TWP.
JOHN R. HAMILTON - REG. SURV. #6861
MAY, 1988
SCALE 1"=100'