

DANE A. HAPONEK

Engineers & Surveyors

34100 Center Ridge Road • NORTH RIDGEVILLE, OHIO 44039 (216) 327-4776 • Lorain 288-4400

7-00-018-D

SURVEY
OF PART OF
ORIGINAL RIDGEVILLE
TWP. LOT 18
CITY OF N. RIDGEVILLE

CLEVELAND ROAD HOMESITES
PV. 10 PG. 27-28

PREPARED FOR:
CECIL & OPAL
LOWTHER
5569 CORNELL AVE
N. RIDGEVILLE, O

CLEVELAND ROAD HOMESITES
PV. 10 PGS 27-28

11 P.F.D.
50° 24' 15" E 125.01 U.

SIL 5
SIL 6

86.69 R/L
84.91 OBS

CECIL & OPAL
D. 1730 P.F.D. W
D. 1730 P.F.D. W

125.01
DUE NORTH

11 P. SET

0.5165 AC.

CENTER GATE MILLS SUBD # 2
PV. 32 PGS 46-48
S/L 122

N 89° 27' 04" E

180.

180.

11 P. FD. 0.20 N
AND 0.35 W
0.55 N
0.65 W 125.01

62.19

11 P. FD BENT
11 P. SET

BIRCH ST 40'

DUE NORTH

BIRCH ST 60'


OPAL ST

FACE
EAST

73-144

19773

07-00-018-101

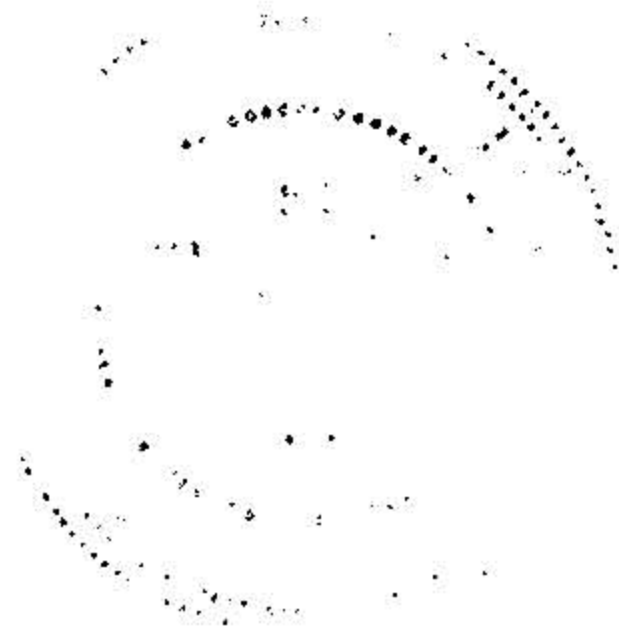

DATE: DEC 1991
SCALE: 1"=50'

DATE: DEC 1991	19773
SCALE: 1"=50'	APPROVED
	LORAIN CO.
	MAP DEPT.
	DATE 2-12-92
PAGE 7-00-018-D	
BY CAROLYN FRANCIS	
VOID AFTER # 19773	

NOTE:

IRON PIPES IN MON.
BOXES ARE BENT
& DISTURBED