


DANE A. HAPONEK • Registered Surveyor

34100 Center Ridge Road • NORTH RIDGEVILLE, OHIO 44039 • (440) 327-4776 • Lorain 288-4400

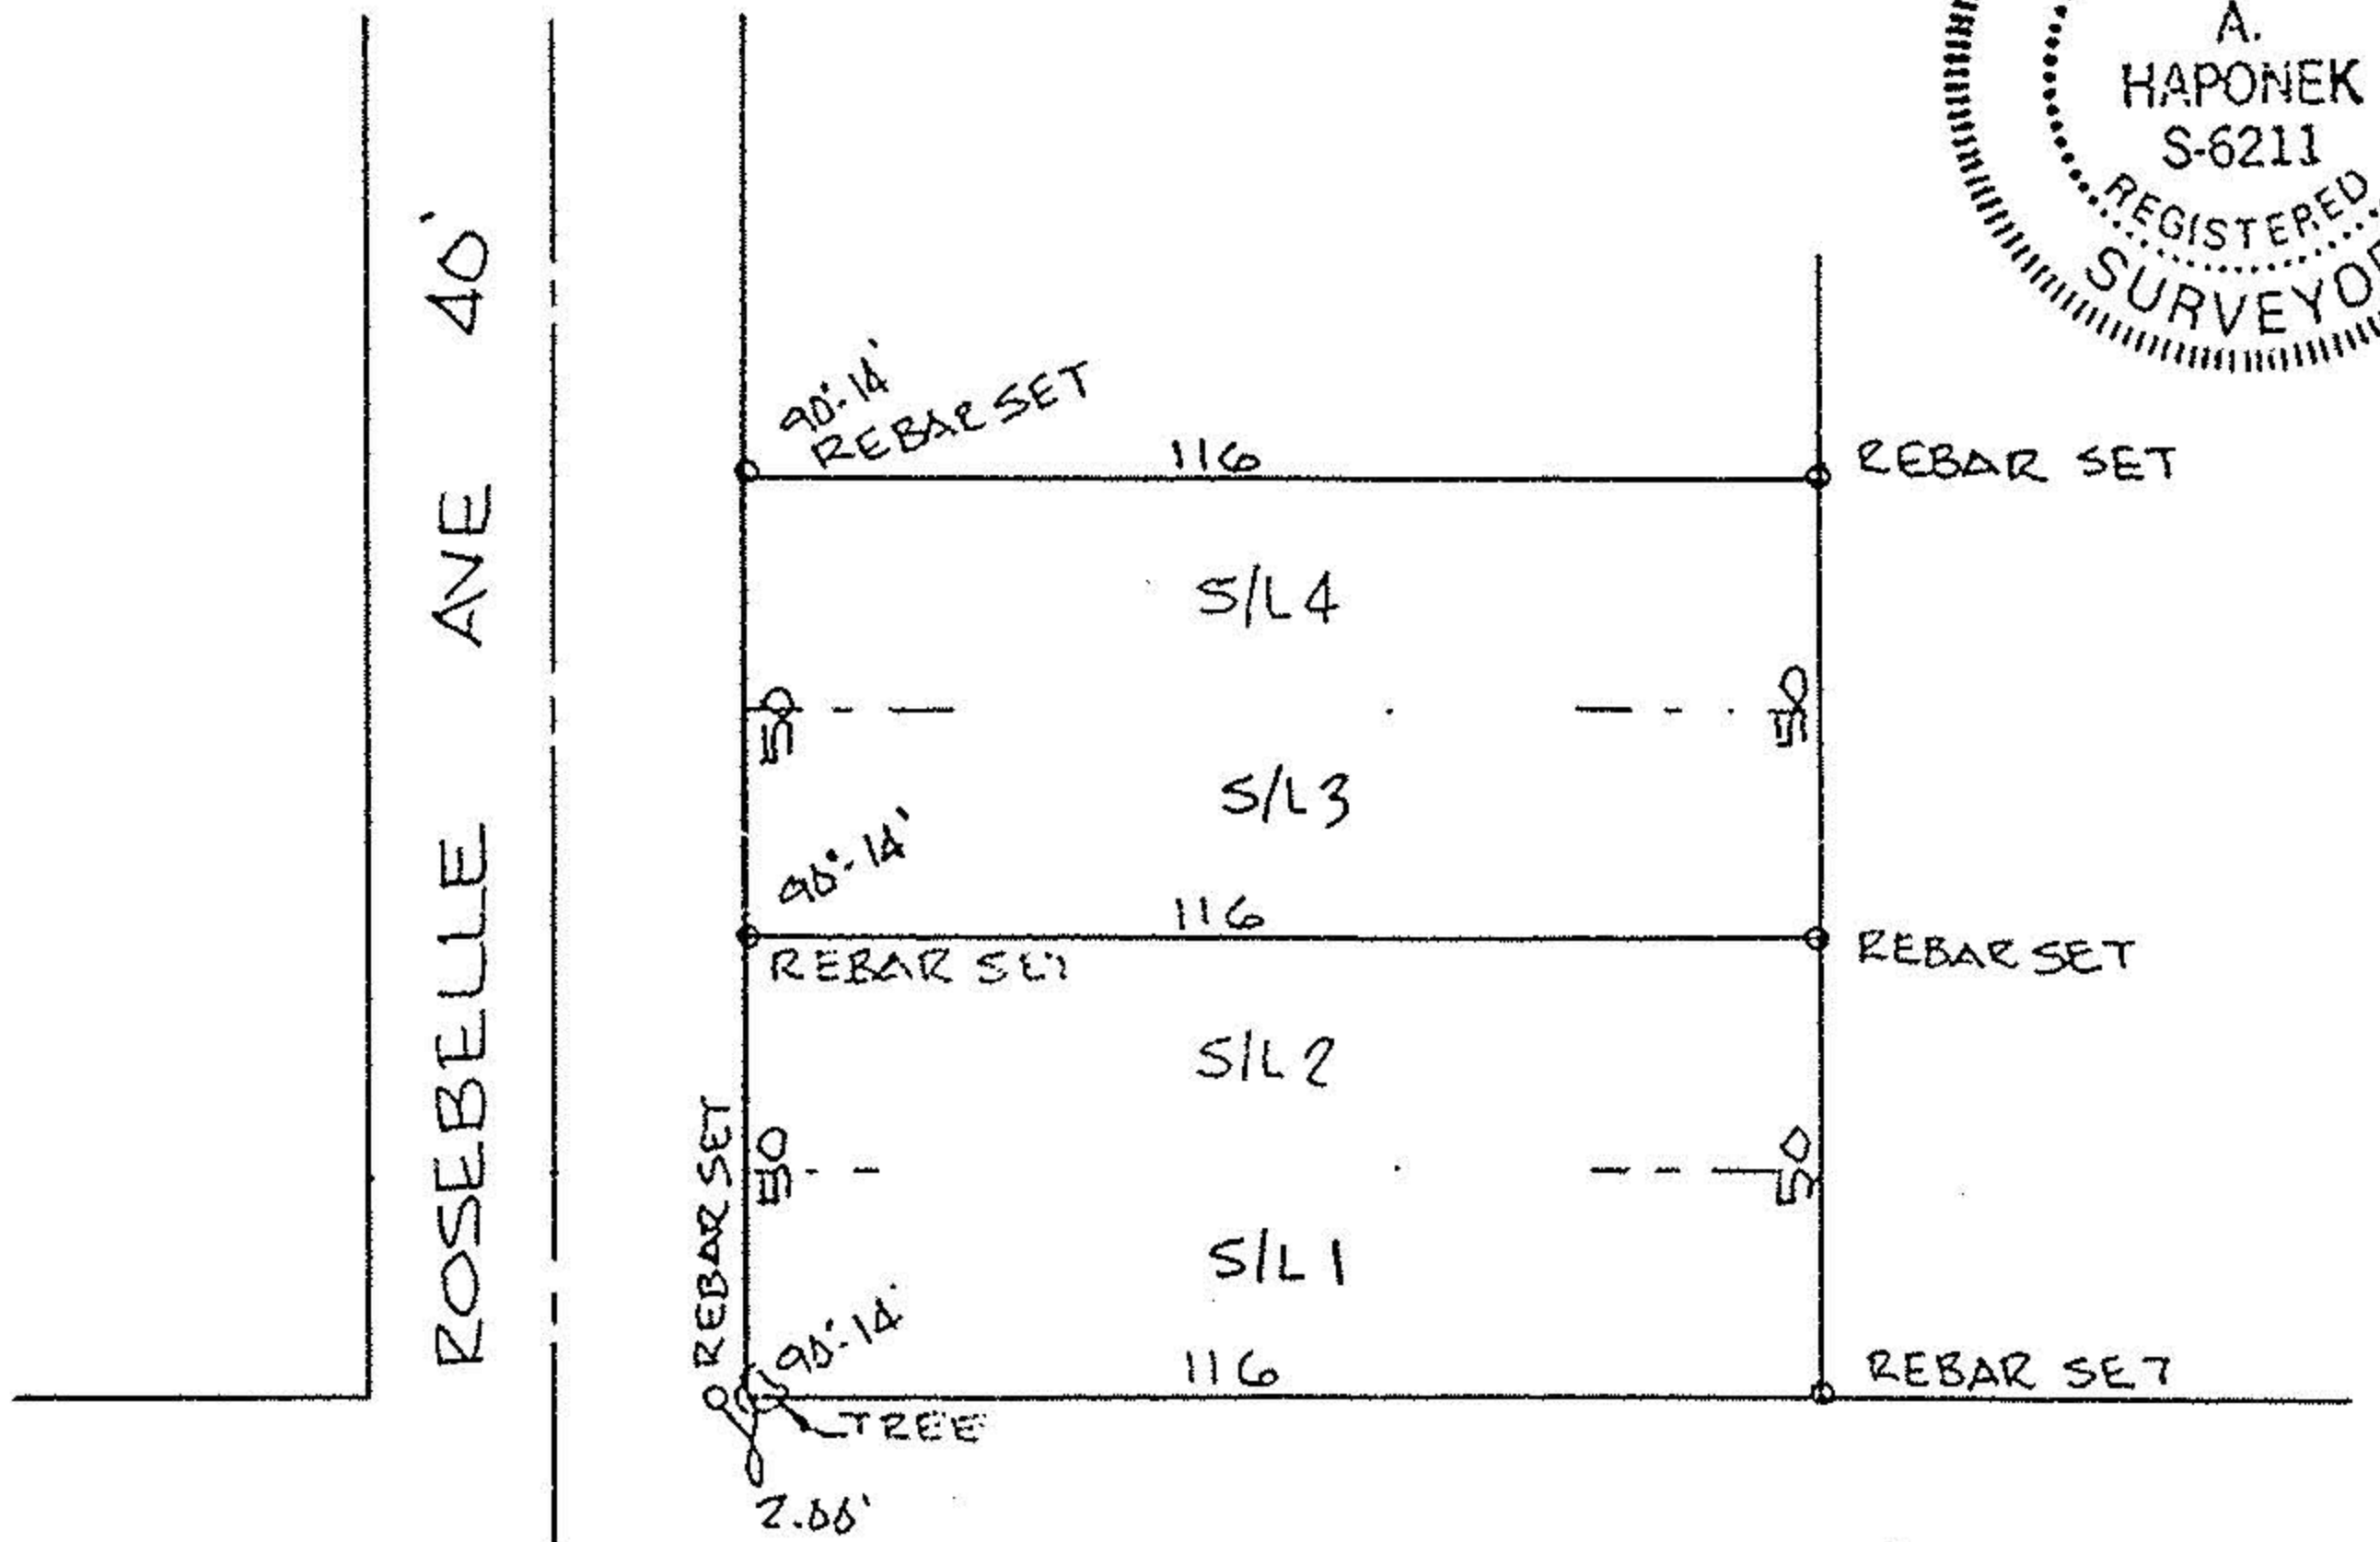

SURVEY
OF

SUBLOTS 1-4 BLK AA
IN
CENTER RIDGE HEIGHTS
CITY OF N. RIDGEVILLE

00808

APPROVED
LORAIN CO.
MAP DEPT

PREPARED FOR
LEROY THOMAS
6260 LAKE RD
MEDINA, OH 44256

DATE 7-19-01

PAGE 7-00-020-B

BY JHATFIELD

01-00808

DATE: OCT 2000
SCALE: 1" = 40'