


#13957

APPROVED	
DRAIN CO.	
MAP DEPT.	
DATE	
PAGE	
BY	
VOID	
AFTER	

Stanley & Rita C. Love!  
D. Vol 472 Pg 477

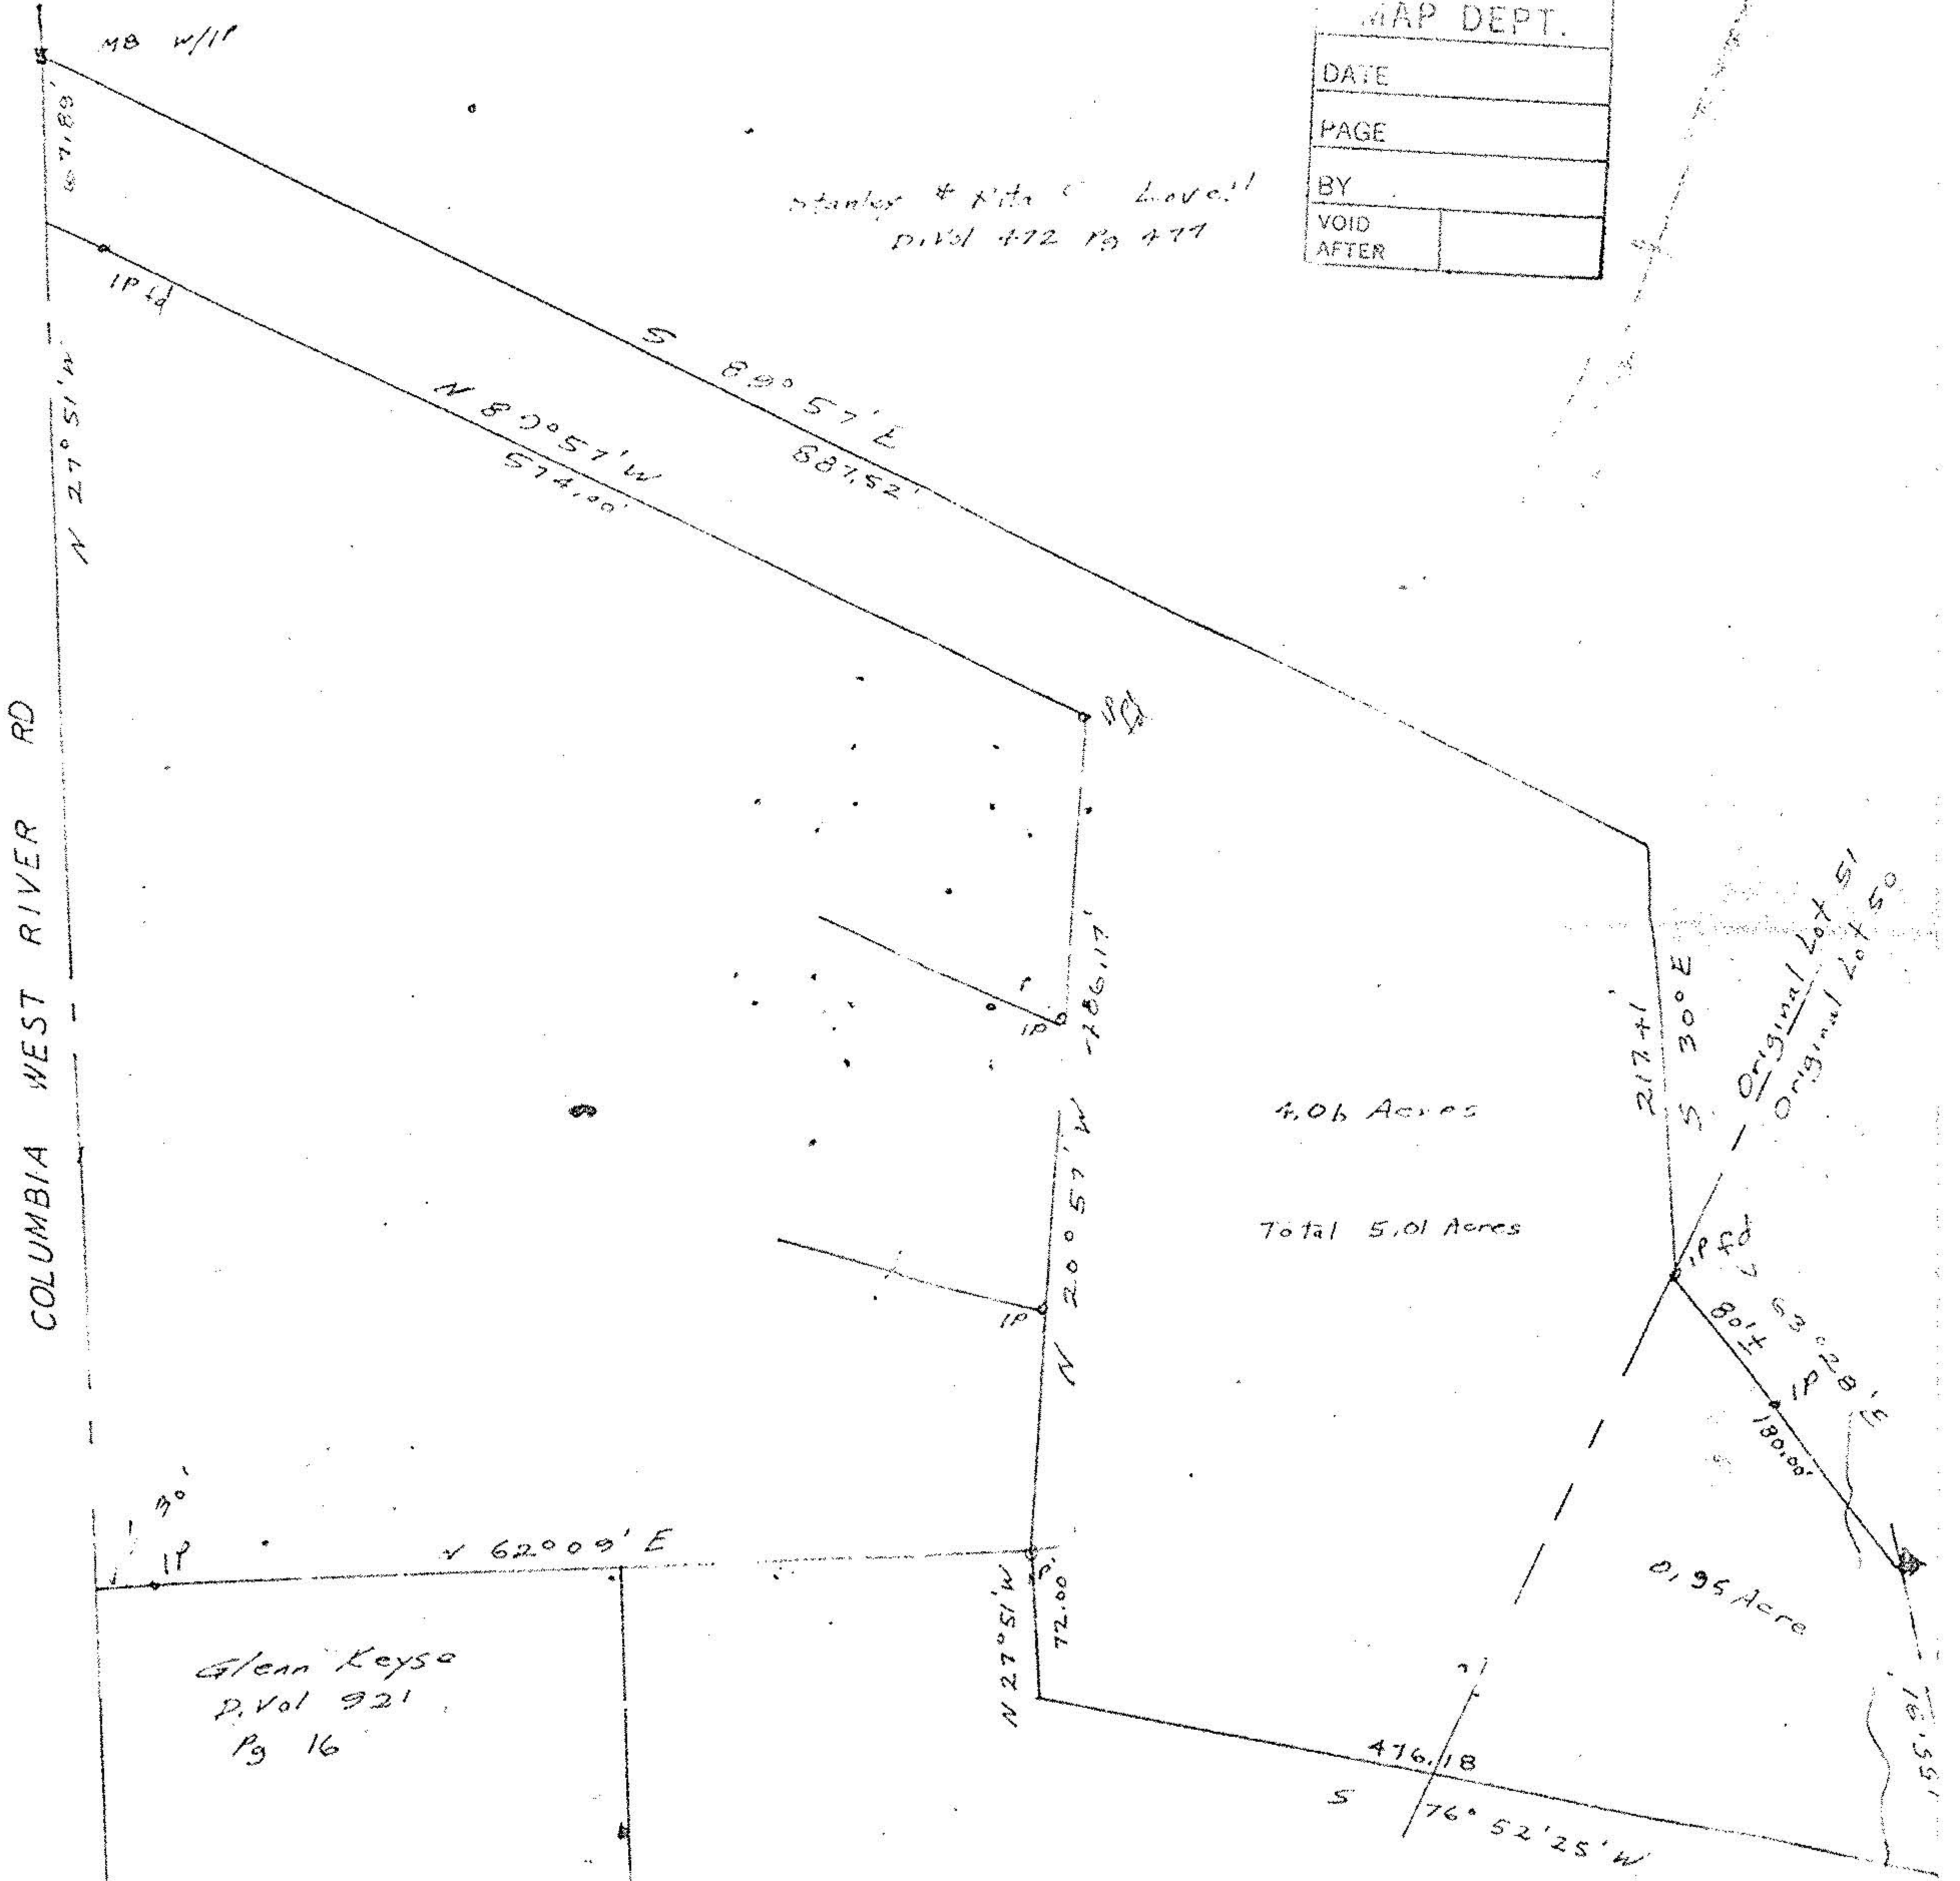

Glenn Keyser  
D. Vol 921  
Pg 16

John Poyywal  
Surveyor  
#5292

0.4150	0.95 Acre
0.4151	4.06 Acres
Total	5.01 Acres

Survey of the southerly lines  
of a parcel split for Glenn Key  
Part of Original Lots 51, 50  
Columbia Township  
Lorain County Ohio  
Scale 1"=100' Nov 8, 1980

Bearings used for  
angles only  
Recorded distances and  
bearings along northerly line  
from D. Vol 1255 Pg 65A  
IP's fd. or set

13957