

005
 03-00-075-116
 #5954
 3-00-075-C

5956

3-00-075

- Iron Pin found
- Iron Pin Set

WEST RIVER ROAD


NORTH

S.E. Cor. of land formerly owned by Bert & Margaret Bodnar Dec. 15, 1948 V. 455 P. 574 --- now the S.E. cor. of land owned by George E. & Mildred E. Kaurich March 20, 1959 V. 743 P. 124

George E. Mildred E. Kaurich March 20, 1959 V. 743 P. 124

0.6094 Ac. O.L. 75
 0.0710 Ac. O.L. 76
 0.6804 Ac. Total

500

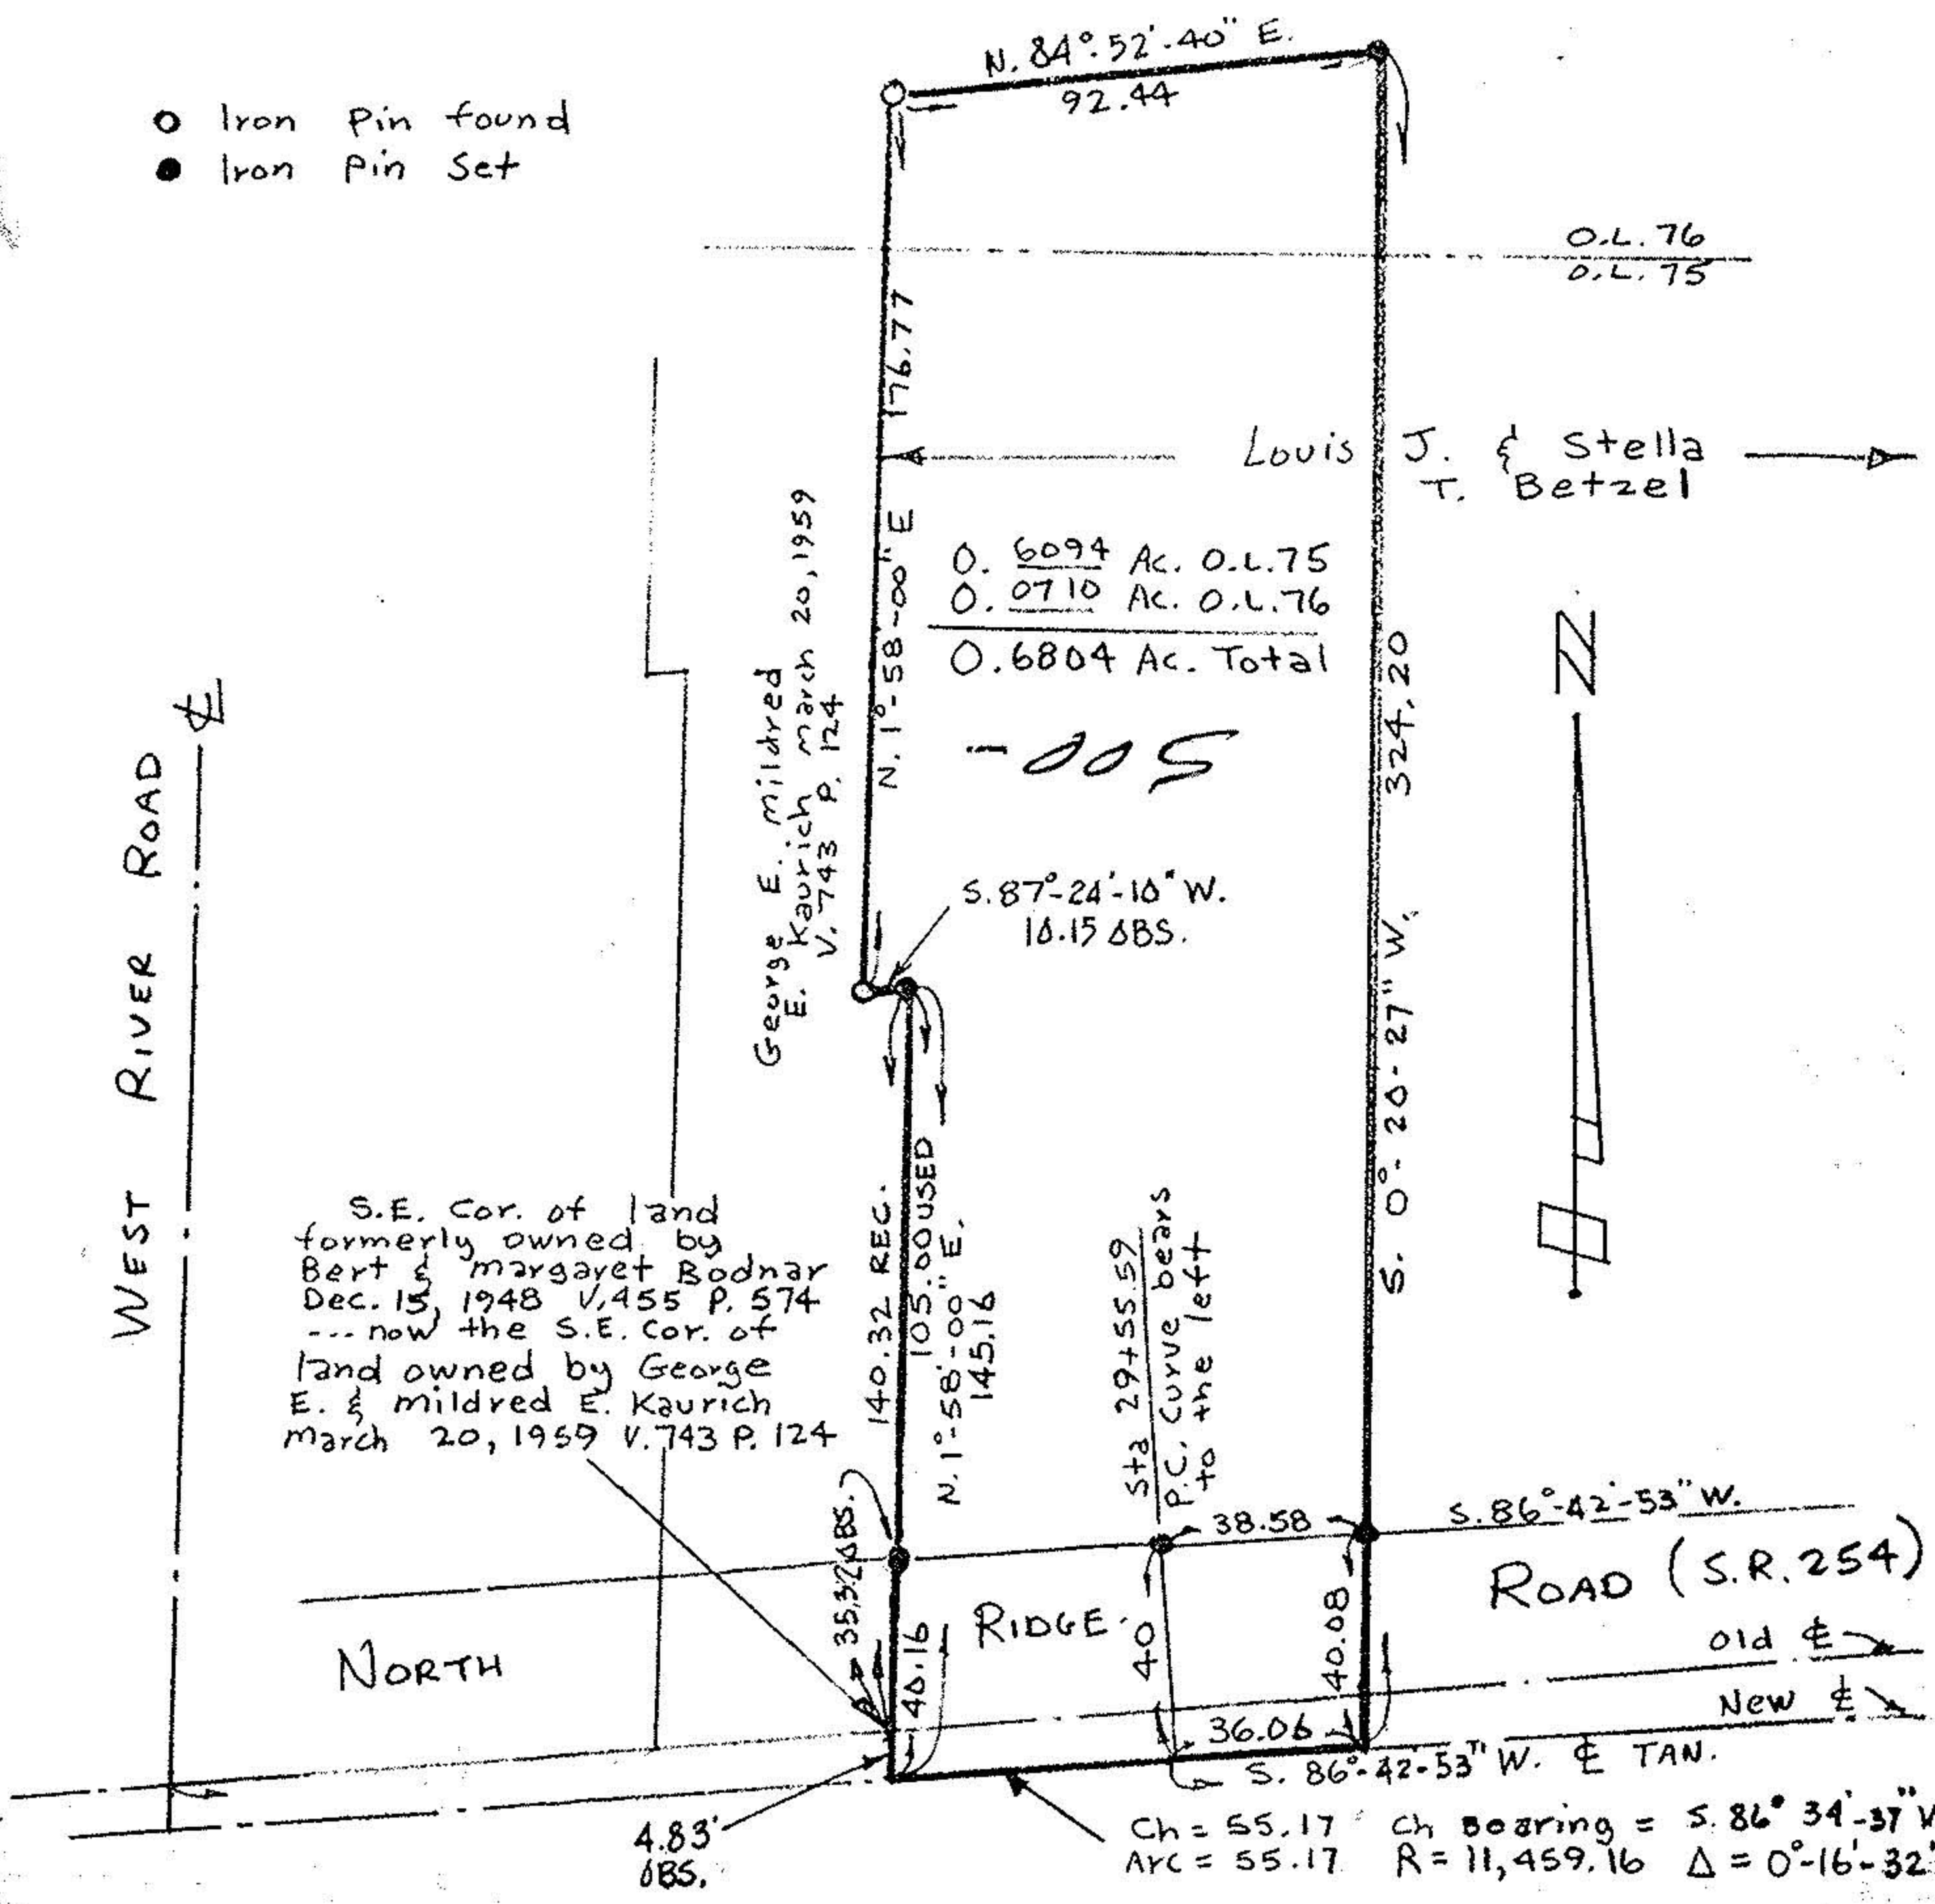

4.83' OBS.

Ch = 55.17 Ch bearing = S. 86° 34' - 37" W.
 Arc = 55.17 R = 11,459.16 Δ = 0° - 16' - 32"

ORIGINAL BY 75 & 76
 Sheffield &

April 13, 1972
 1" = 50'

Lorain
 Ohio

C.J.

1599

3-00-75