


005
 #5954
 03-00-075-116
 3-00-075-C

5956

3-00-

- Iron Pin found
- Iron Pin Set

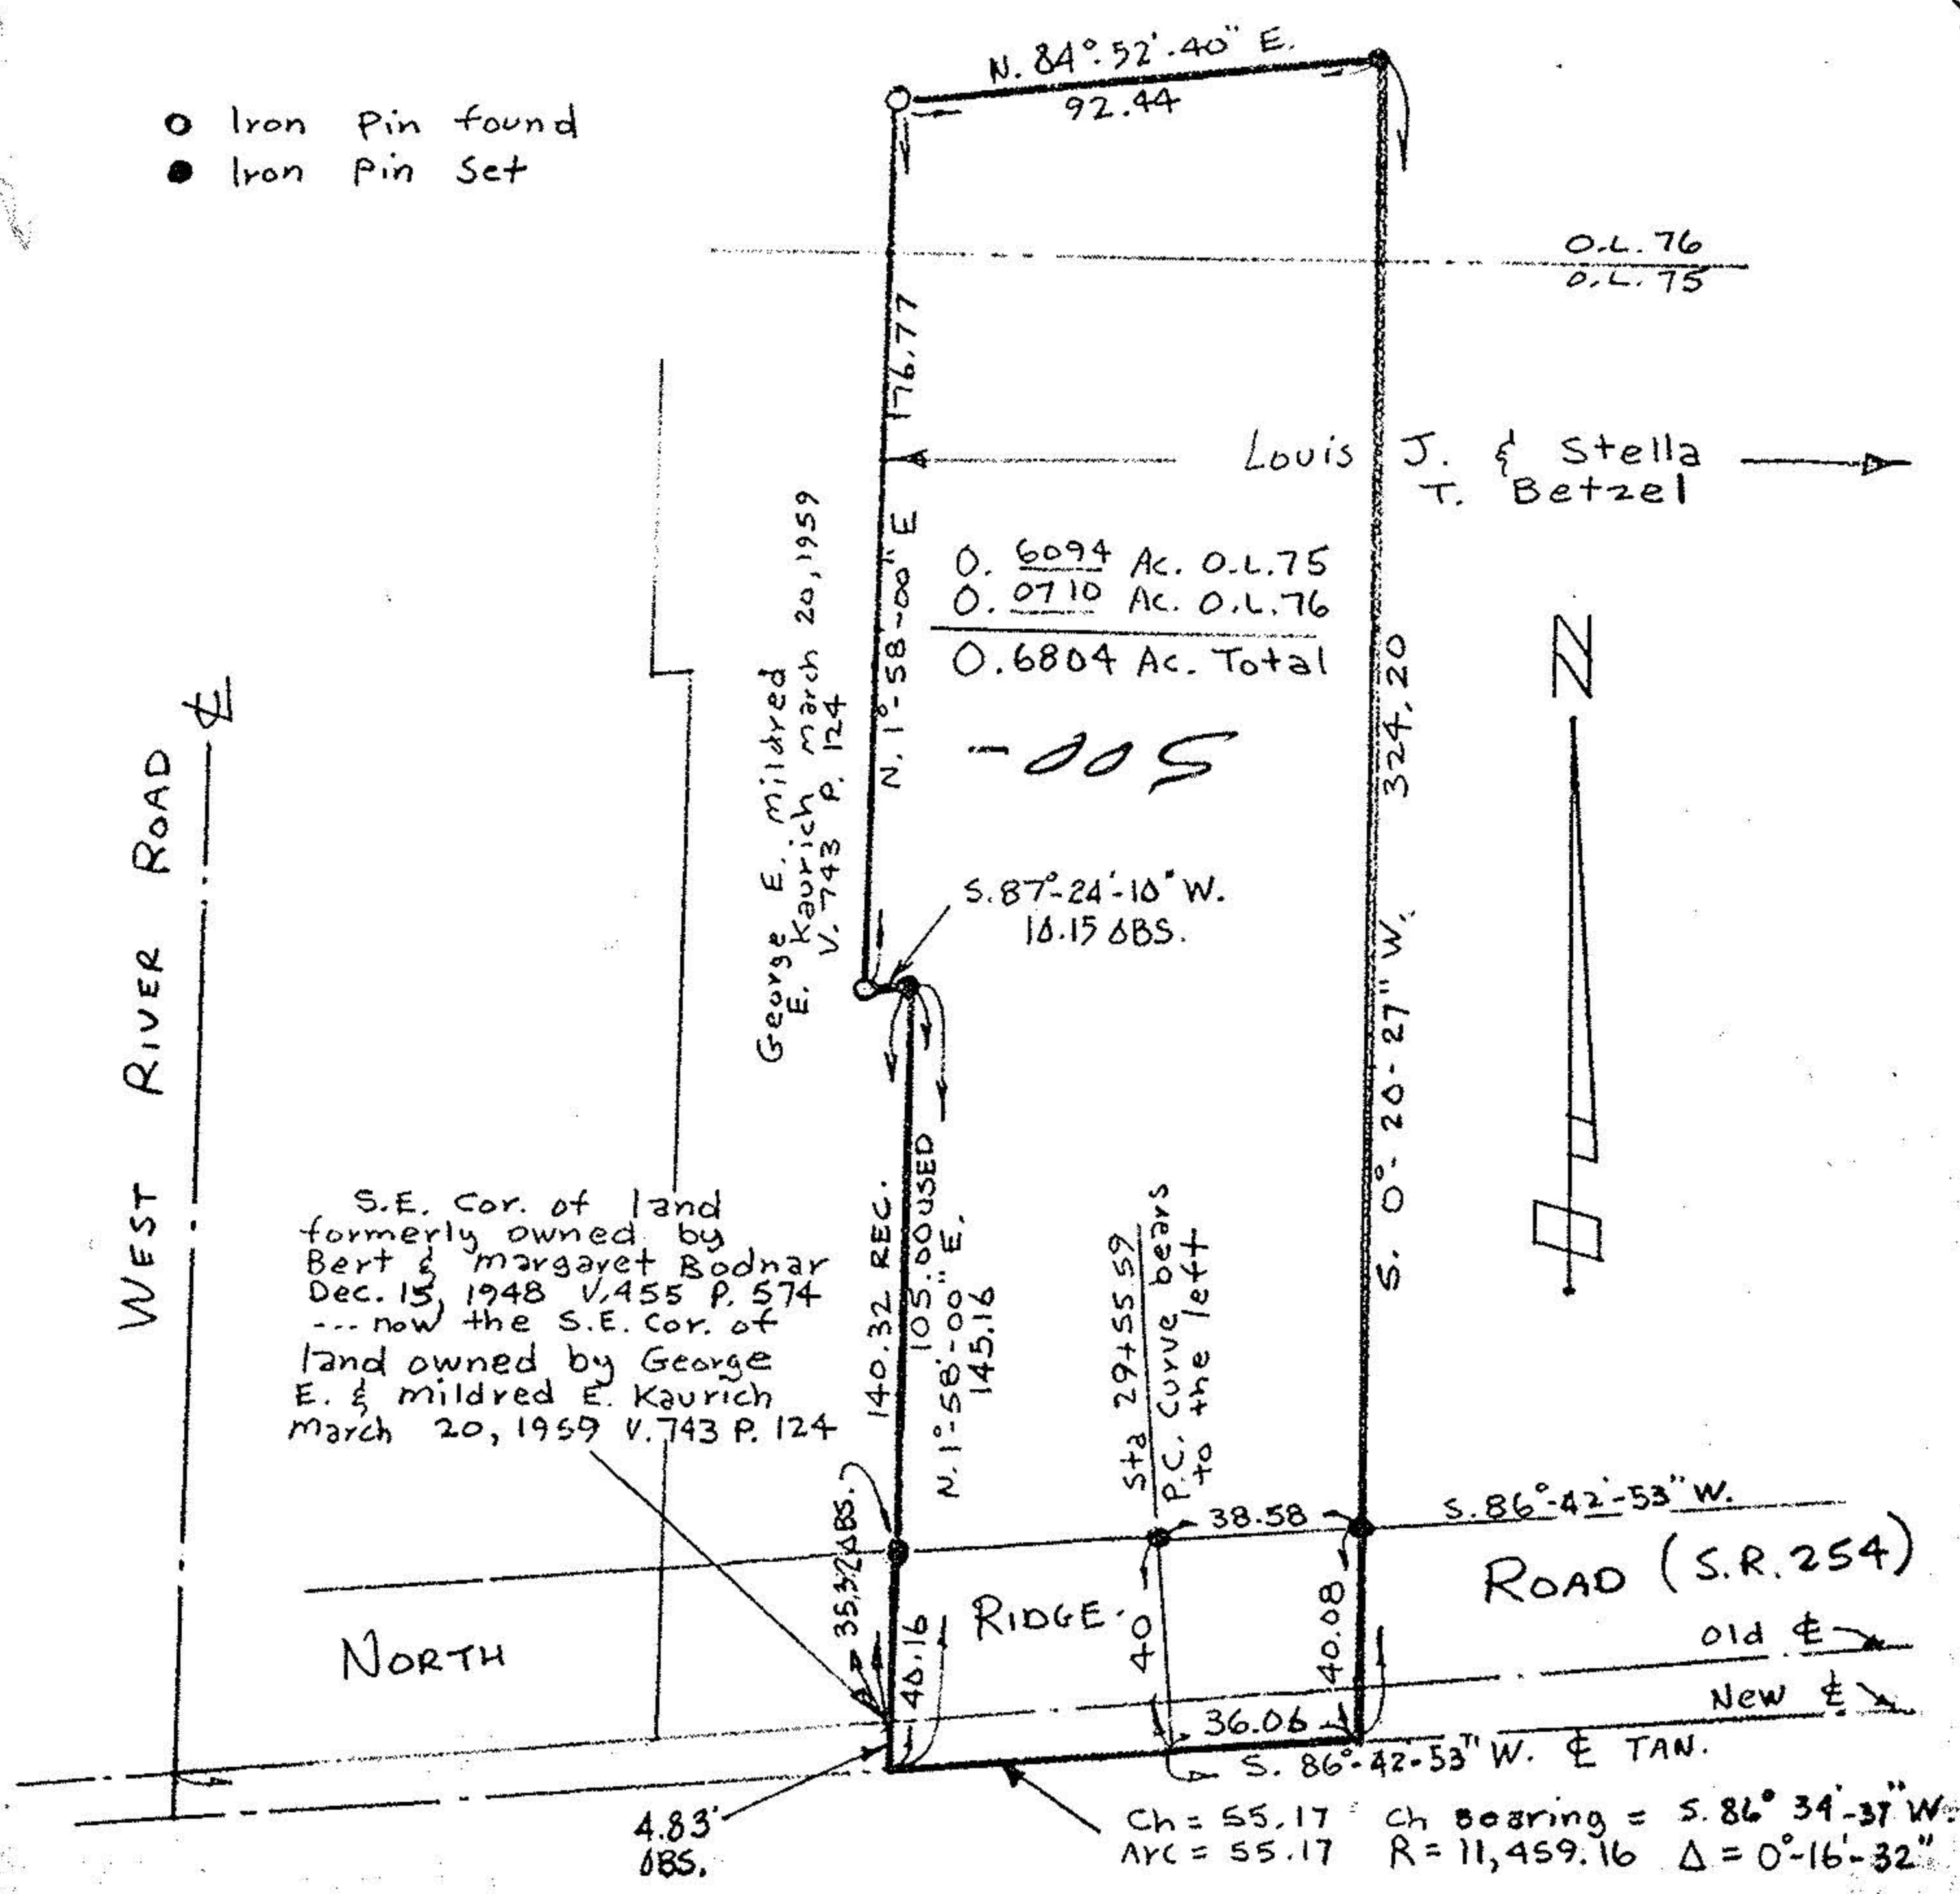

PREPARED BY 75 & 76
 SHEFFIELD &
 Lorain
 Ohio
 1599

April 13, 1972
 1" = 50'
 C.J.
 3-00-75