

A. PIJOR



LAUNDON • SIMON • CAHL & ASSOC. INC.
CONSULTING ENGINEERS & SURVEYORS
ELYRIA, OHIO 44035


SURVEY FOR:

JUAN J. & LUCY V. GONZALEZ

6/L1153 IN HOMEWOOD SUB'N. 6TH ADD'N.
P.V. 22 P. 90

Orig. Lot 77	City of LORAIN	Date 7-19-85 Scale 1"=30'
Orig. Sec	Village of	Dwn. by R.G.S. Chkd. by
Tract	County of LORAIN	Job No. 85-1396 F.B. No
Township of SHEFFIELD	State of OHIO	Printed

FAIRLESS DR. 60'

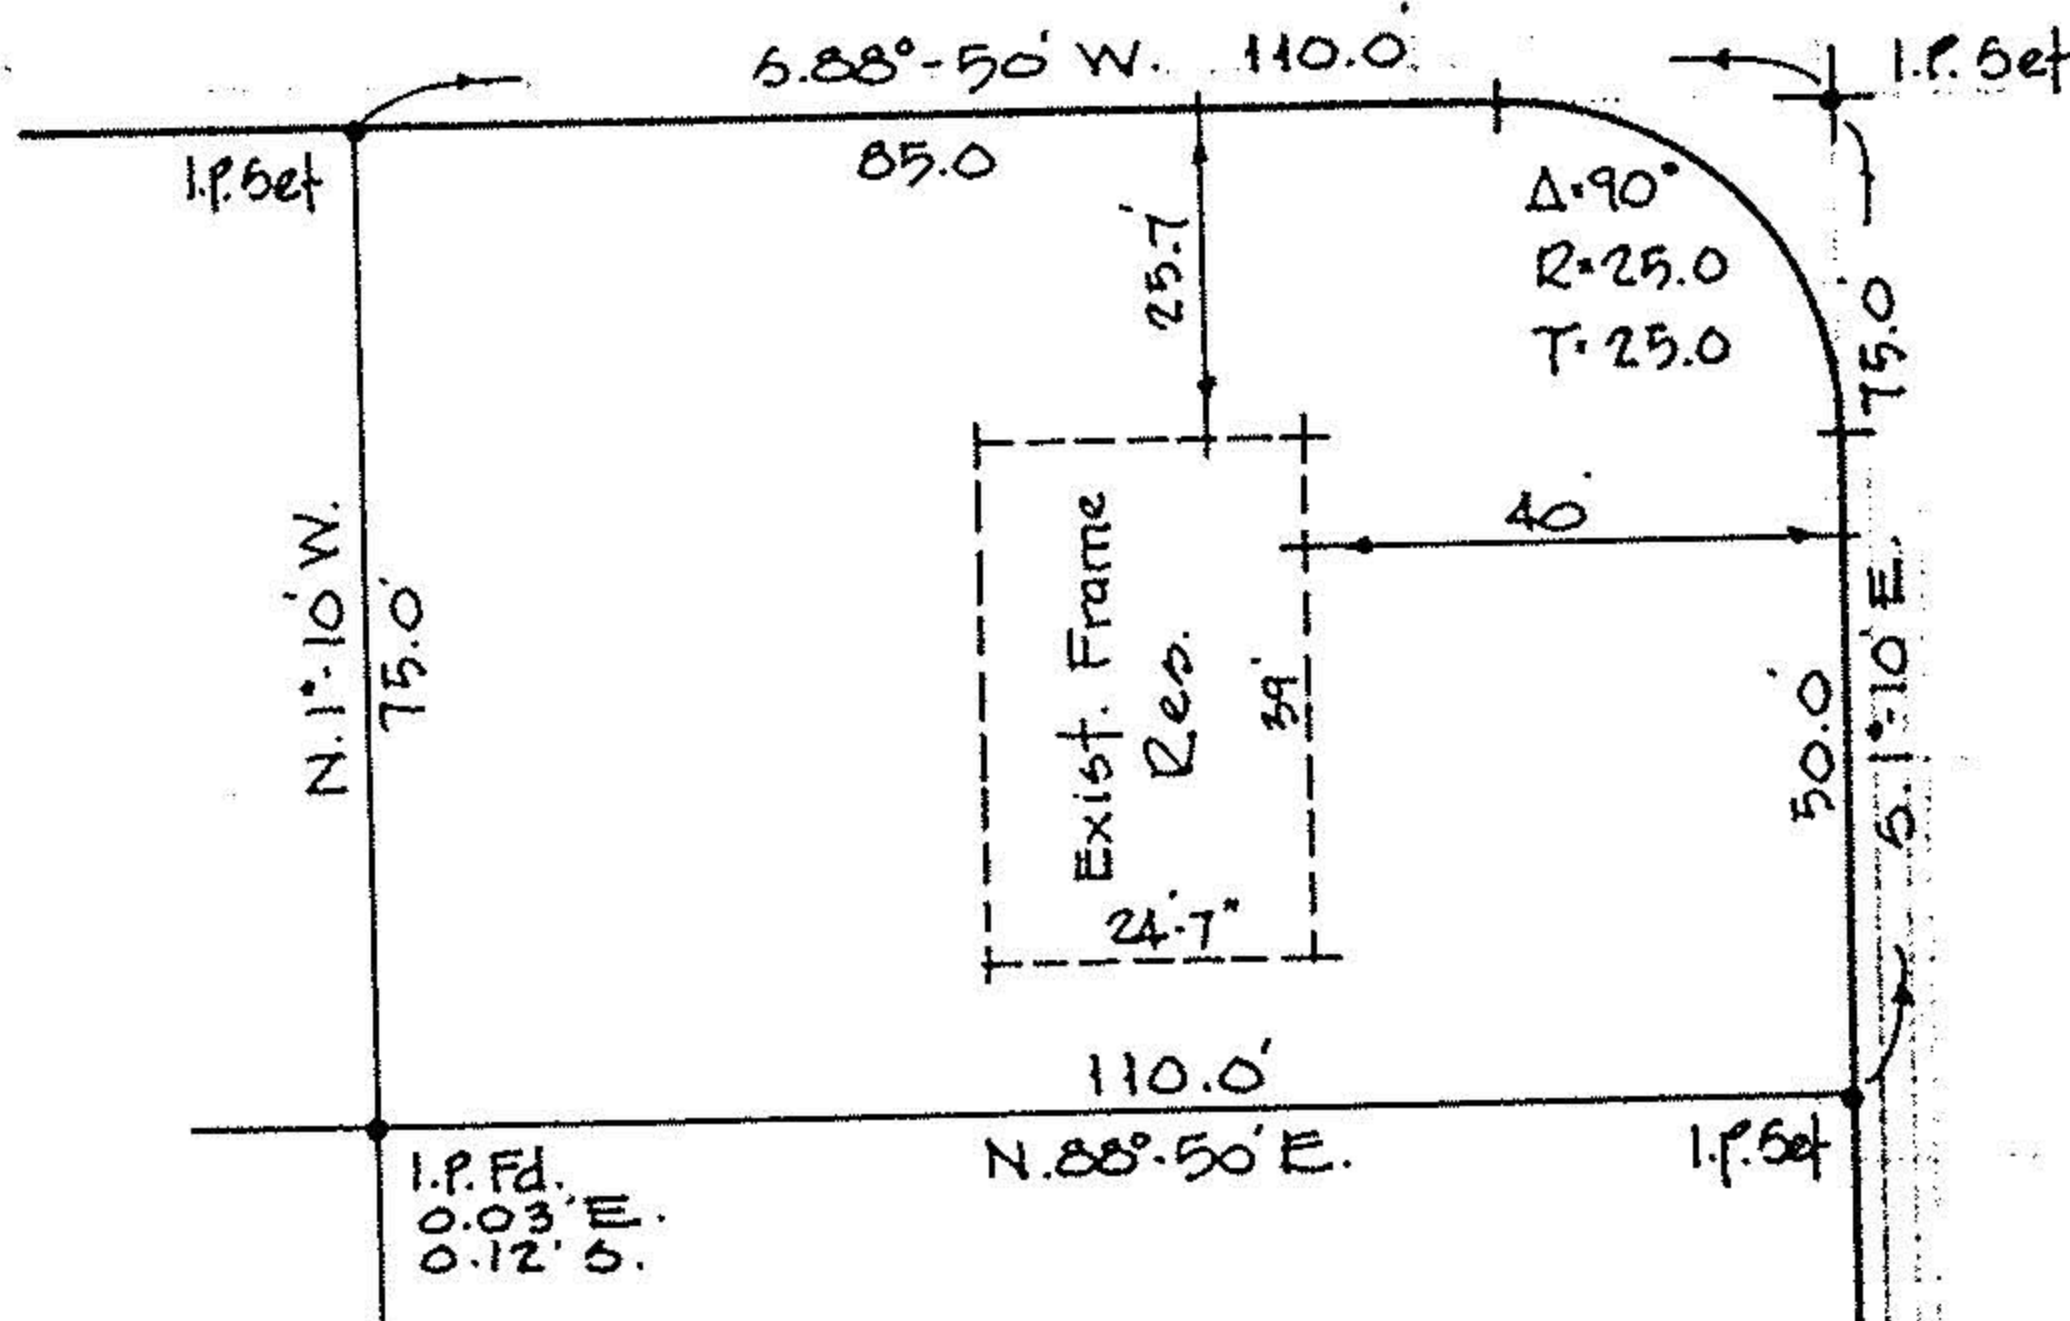

PALM AVE. 60'