

No 01171

APPROVED LORAIN CO. MUN DEPT
DATE 8-5-02
CASE 3.00-097-A
BY JHATfield
* 02. 01171




DATE: MARCH 1999
SCALE: 1" = 40'

PREPARED FOR
HECTOR VAZQUEZ
3503 LOWELL ST
LORAIN, OHIO



P.P.N 03-00-097-121-008, 017, -018

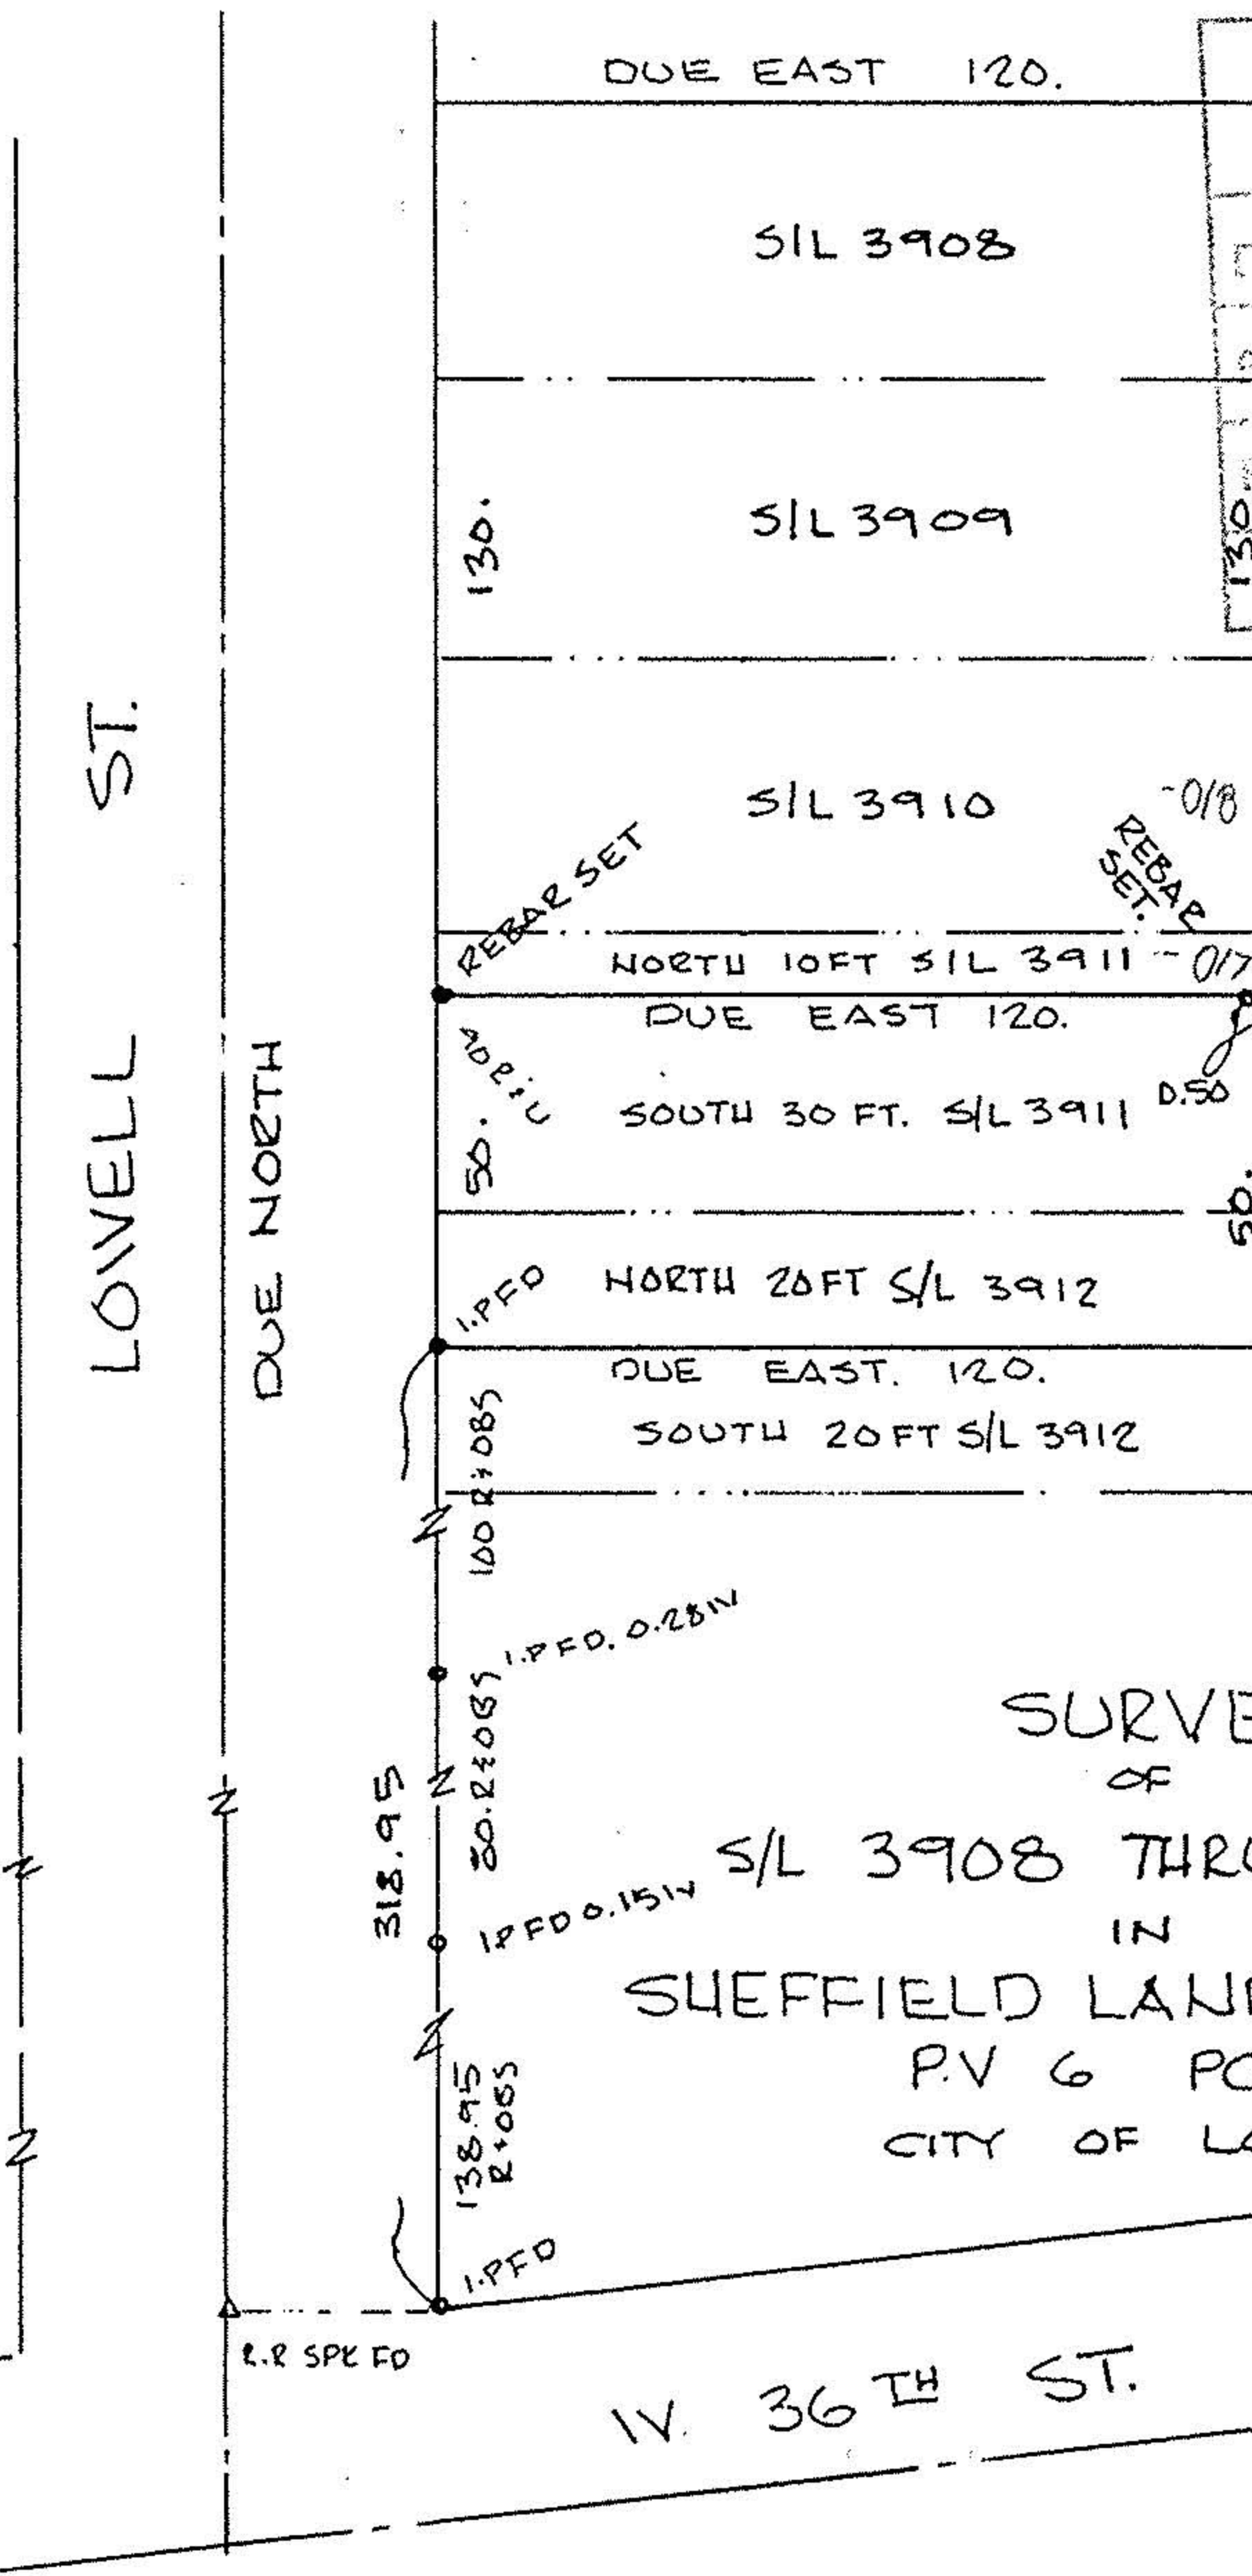

SURVEY

OF
S/L 3908 THRU S/L 3912
IN
SHEFFIELD LAND & IMP. CO'S SUB NO
P.V 6 PG 13
CITY OF LORAIN