


MATCH LINE SEE SHEET #1

MATCH LINE SEE SHEET #4

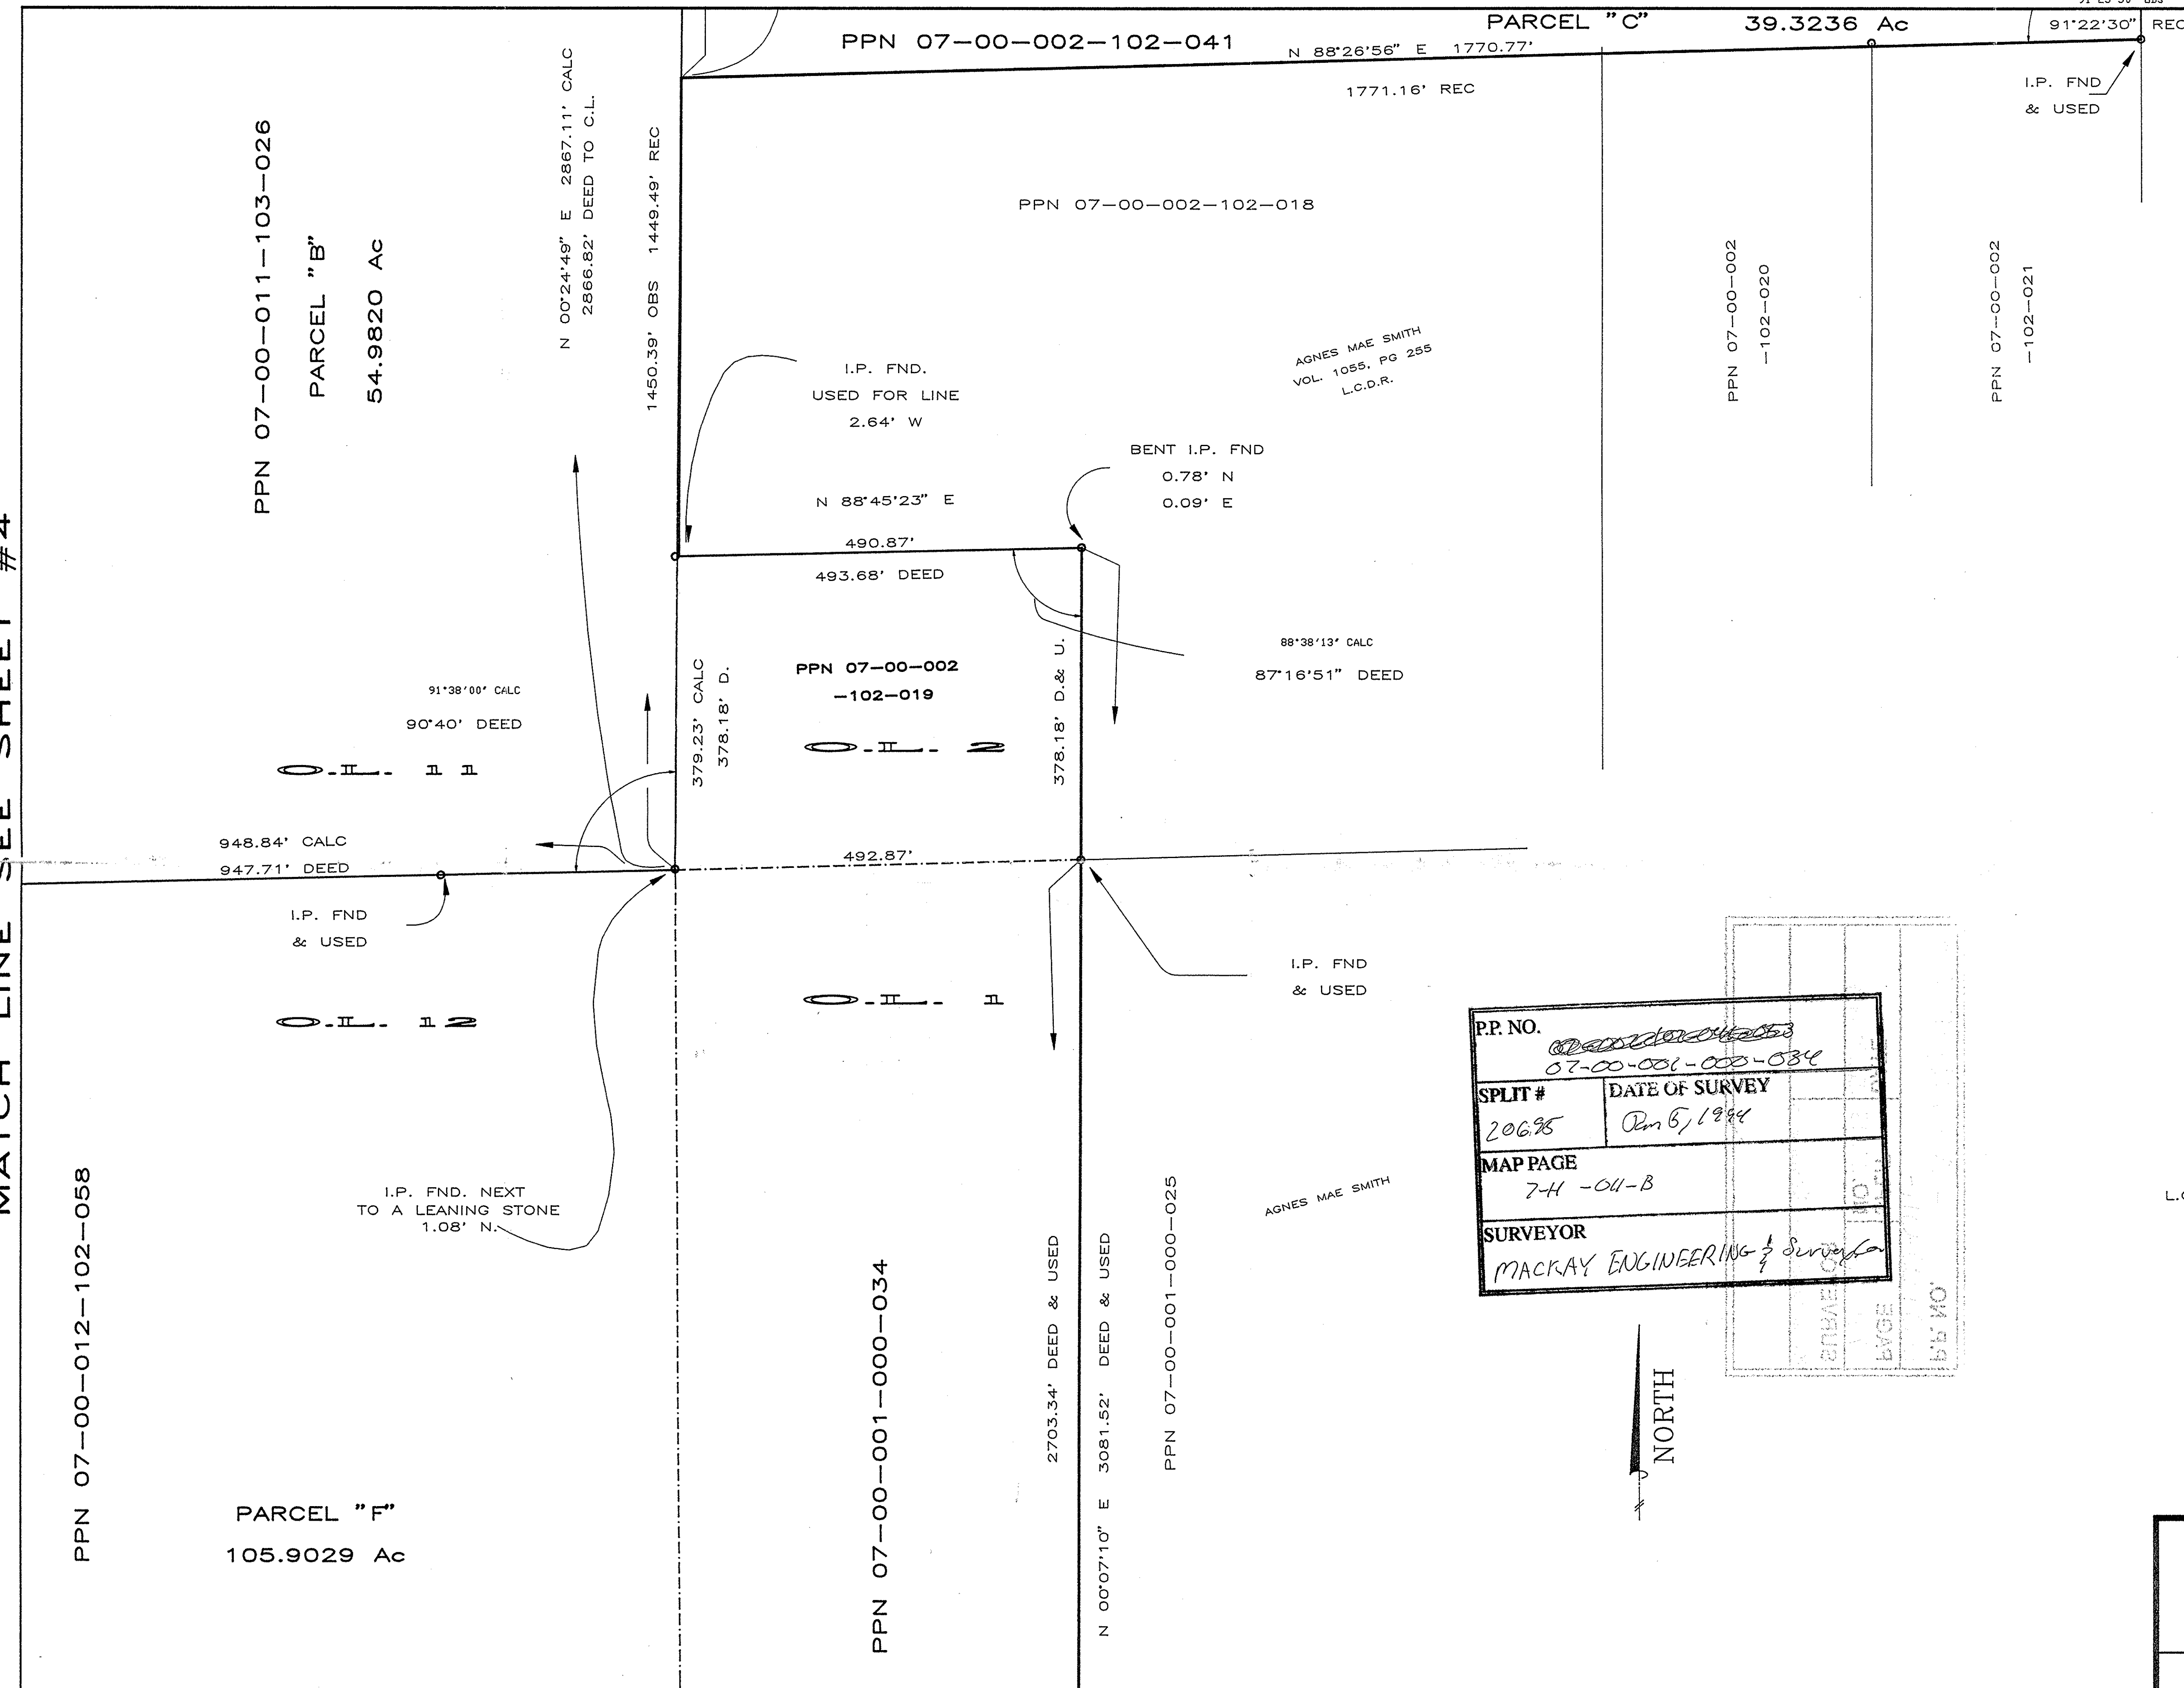

LOTTIE PELECH
VOL. 932, PG 476
L.C.D.R.

AGNES MAE SMITH
VOL. 1055, PG 255
L.C.D.R.

AGNES MAE SMITH

P.P. NO. <i>07-00-001-000-034</i>	
SPLIT # <i>20675</i>	DATE OF SURVEY <i>Jan 6, 1994</i>
MAP PAGE <i>7-H-04-B</i>	
SURVEYOR <i>MACKAY ENGINEERING & Surveying</i>	



- LEGEND
- I.P. - IRON PIN
 - MON. - MONUMENT
 - OBS - OBSERVED DIMENSION
 - D. - DEED DIMENSION
 - C. - CALCULATED DIMENSION
 - FND - FOUND
 - L.C.D.R. - LORAIN COUNTY DEED RECORDS
 - RB - RE-BAR
 - O.L. - ORIGINAL LOT

93E12

MAP OF SURVEY
FOR
RIDGEFIELD HOMES
IN THE CITY OF
NORTH RIDGEFIELD

MACKAY
Engineering & Surveying Company
7017 Pearl Road, Cleveland, Ohio 44130

(216) 886-4500 (216) 886-4590 Fax	DATE: JAN. 5, 1994
SCALE: 1" = 100'-0"	SHEET 2 OF 5

MATCH LINE SEE SHEET #3