


PLAT OF SURVEY FOR 1.8577 ACRE PARCEL
 PART OF ORIGINAL LOT NO. 10
 EATON TWP. LORAIN COUNTY, OHIO

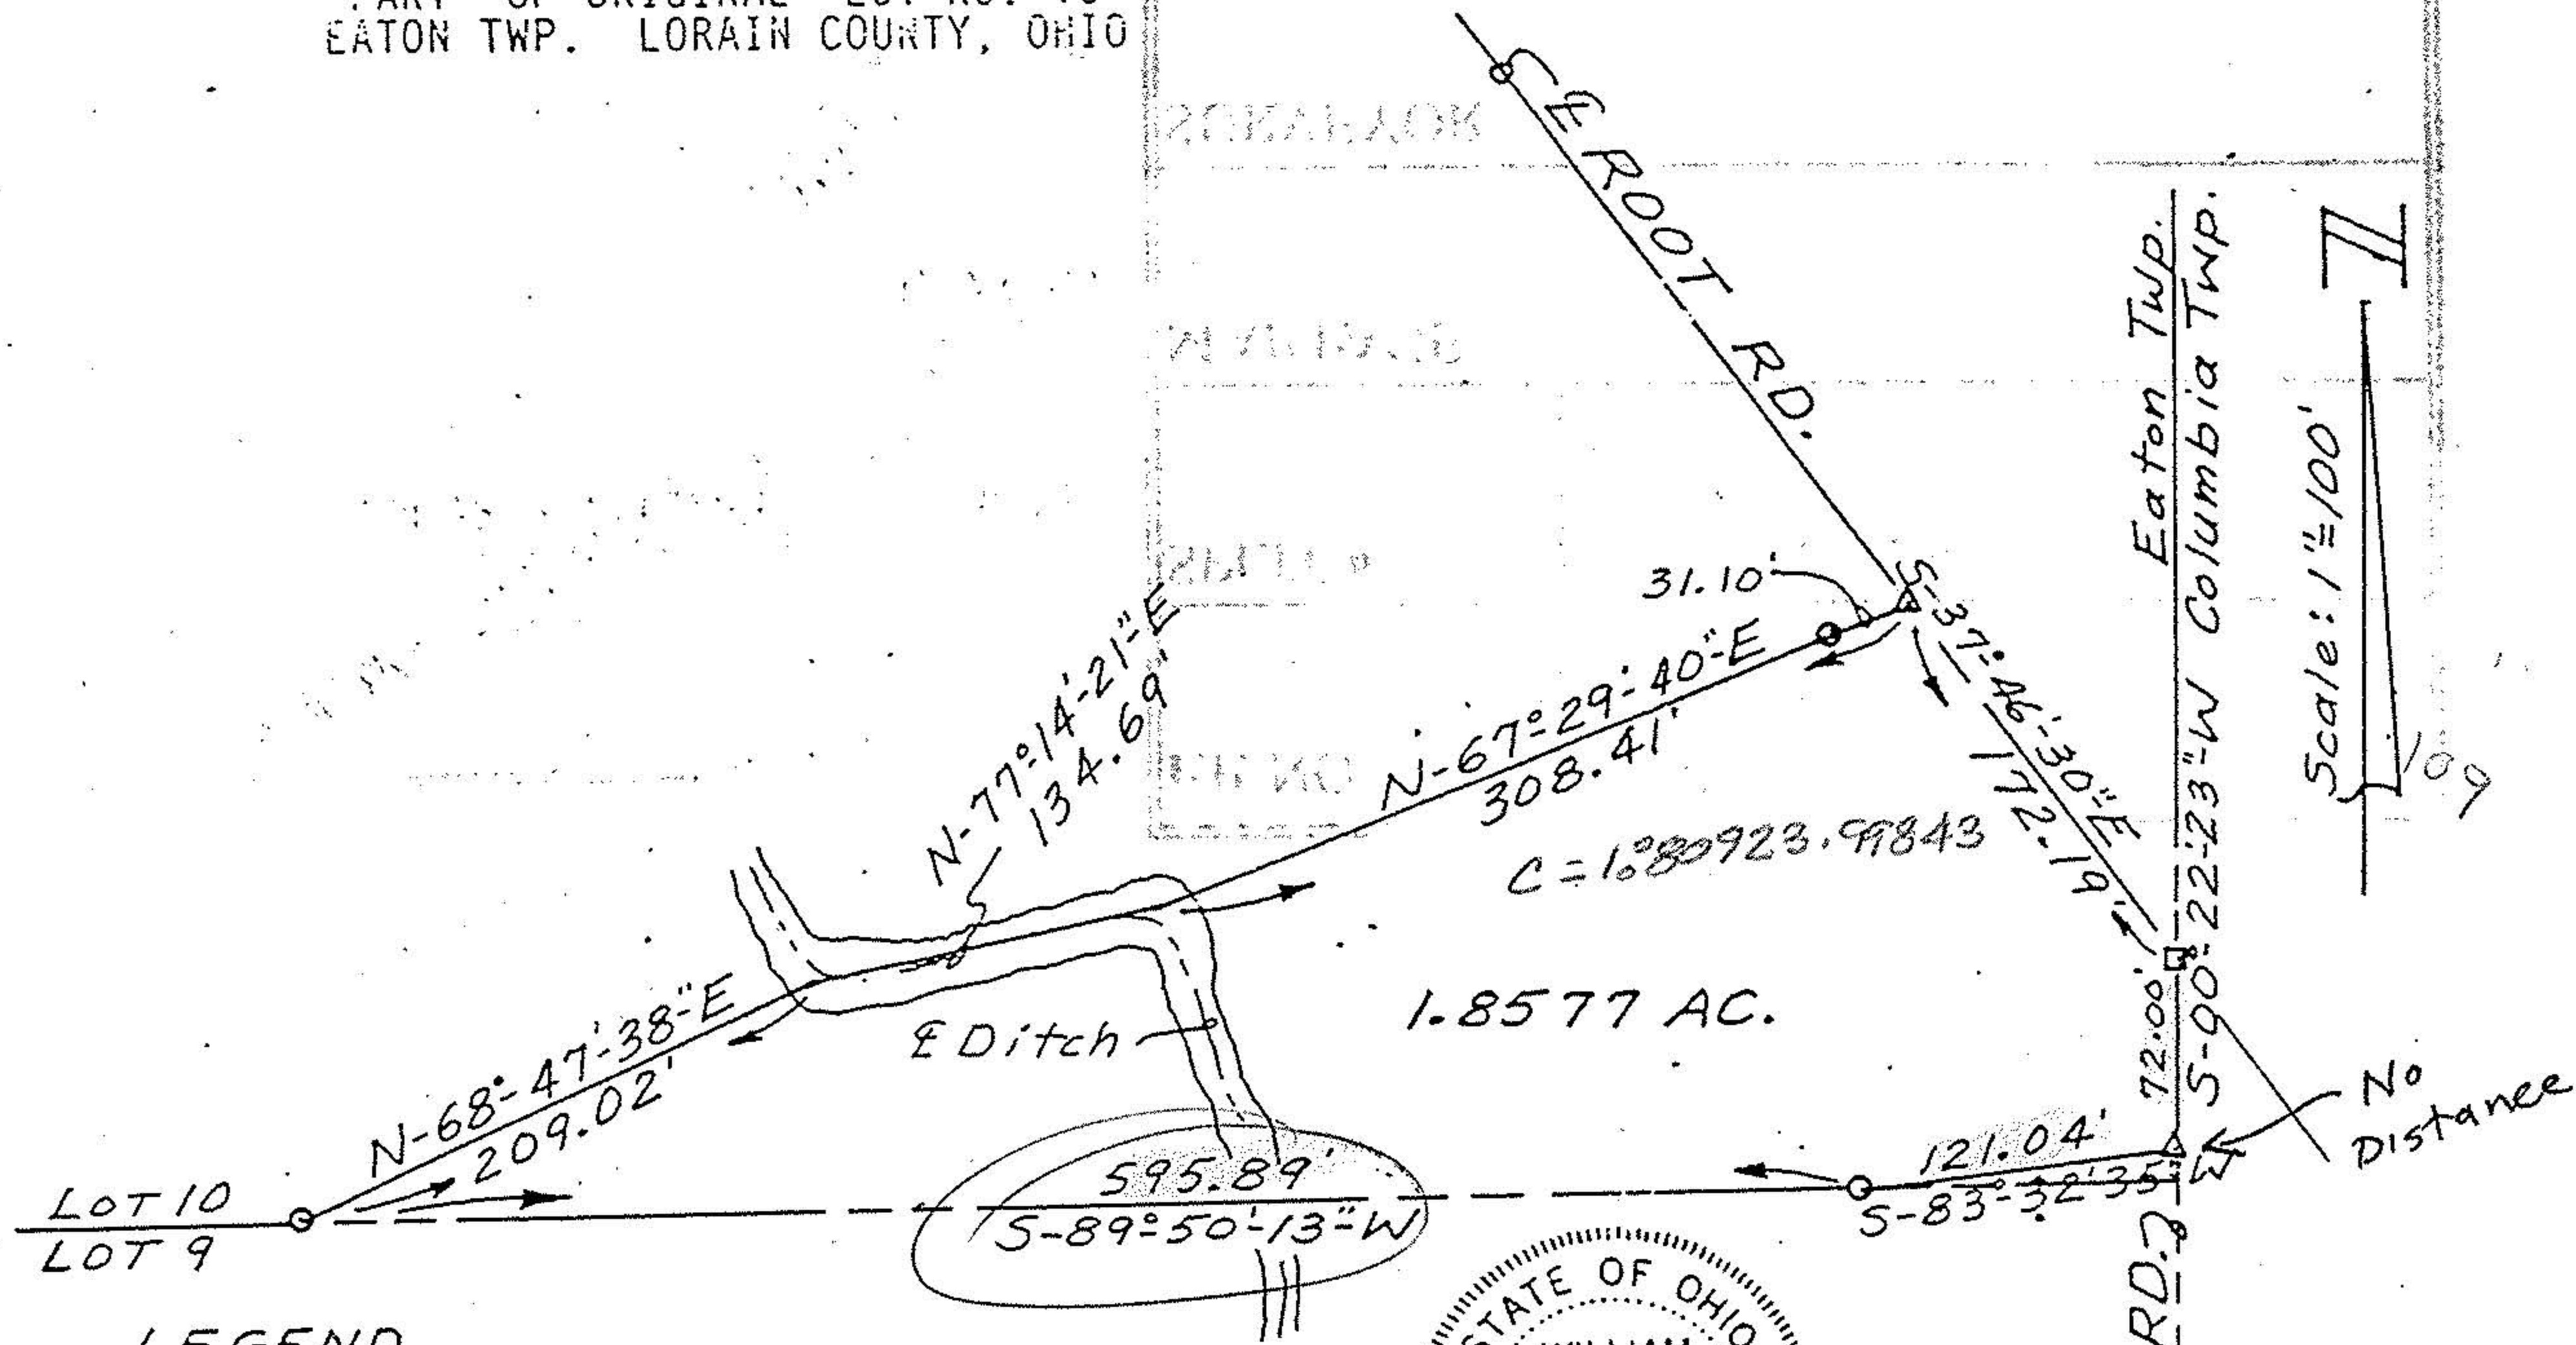

LEGEND

- IRON PIN SET
- △ R/R SPIKE SET
- MON. BOX W/ IRON PIN

All bearings are magnetic and are to be used for the determination of angles only.



William L. Fox
 William L. Fox, P.S.
 Reg. Surveyor No. 5878