




LAUNDON, SIMON, CAHL & ASSOC. INC.  
CONSULTING ENGINEERS & SURVEYORS  
219 COURT ST. ELYRIA, OHIO 44035

SURVEY FOR:

FRANCIS WESTON

Orig. Lot #6	City of	Date OCT. 1986	Scale 1"=200'
Orig. Sec	Village of	Dwn. by R.G.S.	Chkd. by C.J.
Tract	County of LORAIN	Job No. 86-1537	F.B.
Township of EATON	State of OHIO	Printed	

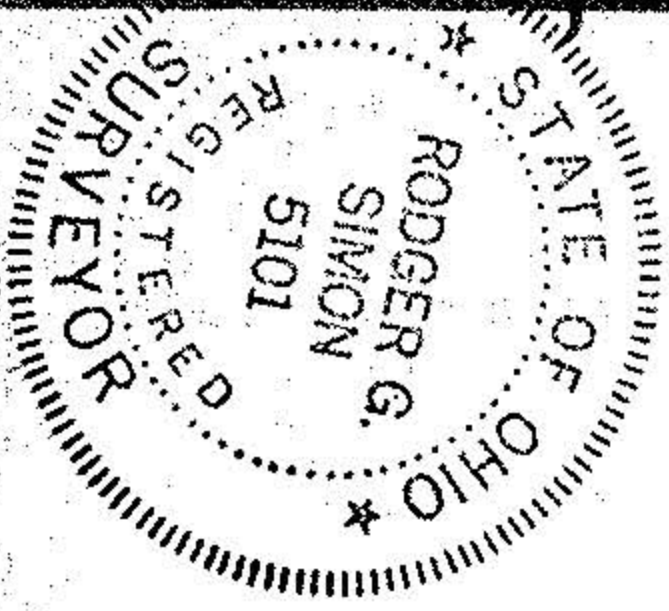

REVISED FOR BURKE  
AUG. 13, 1987 - PCL. N° 3  
REVISED - 4.3.91



REED RD. 50' NO. 10'E. 729.64' R&M.

JESSE & WILLA D. CONRAD  
V. 859 P. 300

~~CHARLENE E. KANUGH~~ RANDAL T & IRENE  
~~V. 1199 P. 62~~ CUTLIP ORV. 91 P. 790

BENJAMIN L &  
RUTH A.  
MICHAEL  
V. 1146 P. 517

JAMES S & LILY TSDJ  
V. 1210 P. 717

435.60  
700.00  
PCL. N° 4  
4.0169 AC.

709.32' @  
N. 89° 14' E. 1493.87 R&M. @  
793.87

RMDR. of PCL. N° 1  
9.1026 AC.

250.00  
N. 89° 14' E. 700.00'  
PCL. N° 3  
4.0169 AC.

250.00  
500.00  
1.95 @  
5.0° 10' W.  
250.00'

792.41'

JAMES M. & SUSAN M. SMITH  
V. 1411 P. 724

PCL. N° 2  
7.8650 AC.

1492.41' @  
-072

5.89° 14' W. 1491.75' R&M. @

O.L. 16  
O.L. 17

#19345

APPROVED  
LORAIN CO.  
MAP DEPT.

DATE 4-26-91

PAGE 11-00-016A, B  
CAROLYN  
BY FRANCIS

VOID AFTER # 19345