


George & Marie Kocsis
Deed Vol 416 Pg 248

James M & Hazel Elliott
Deed Vol 1007 Pg 13

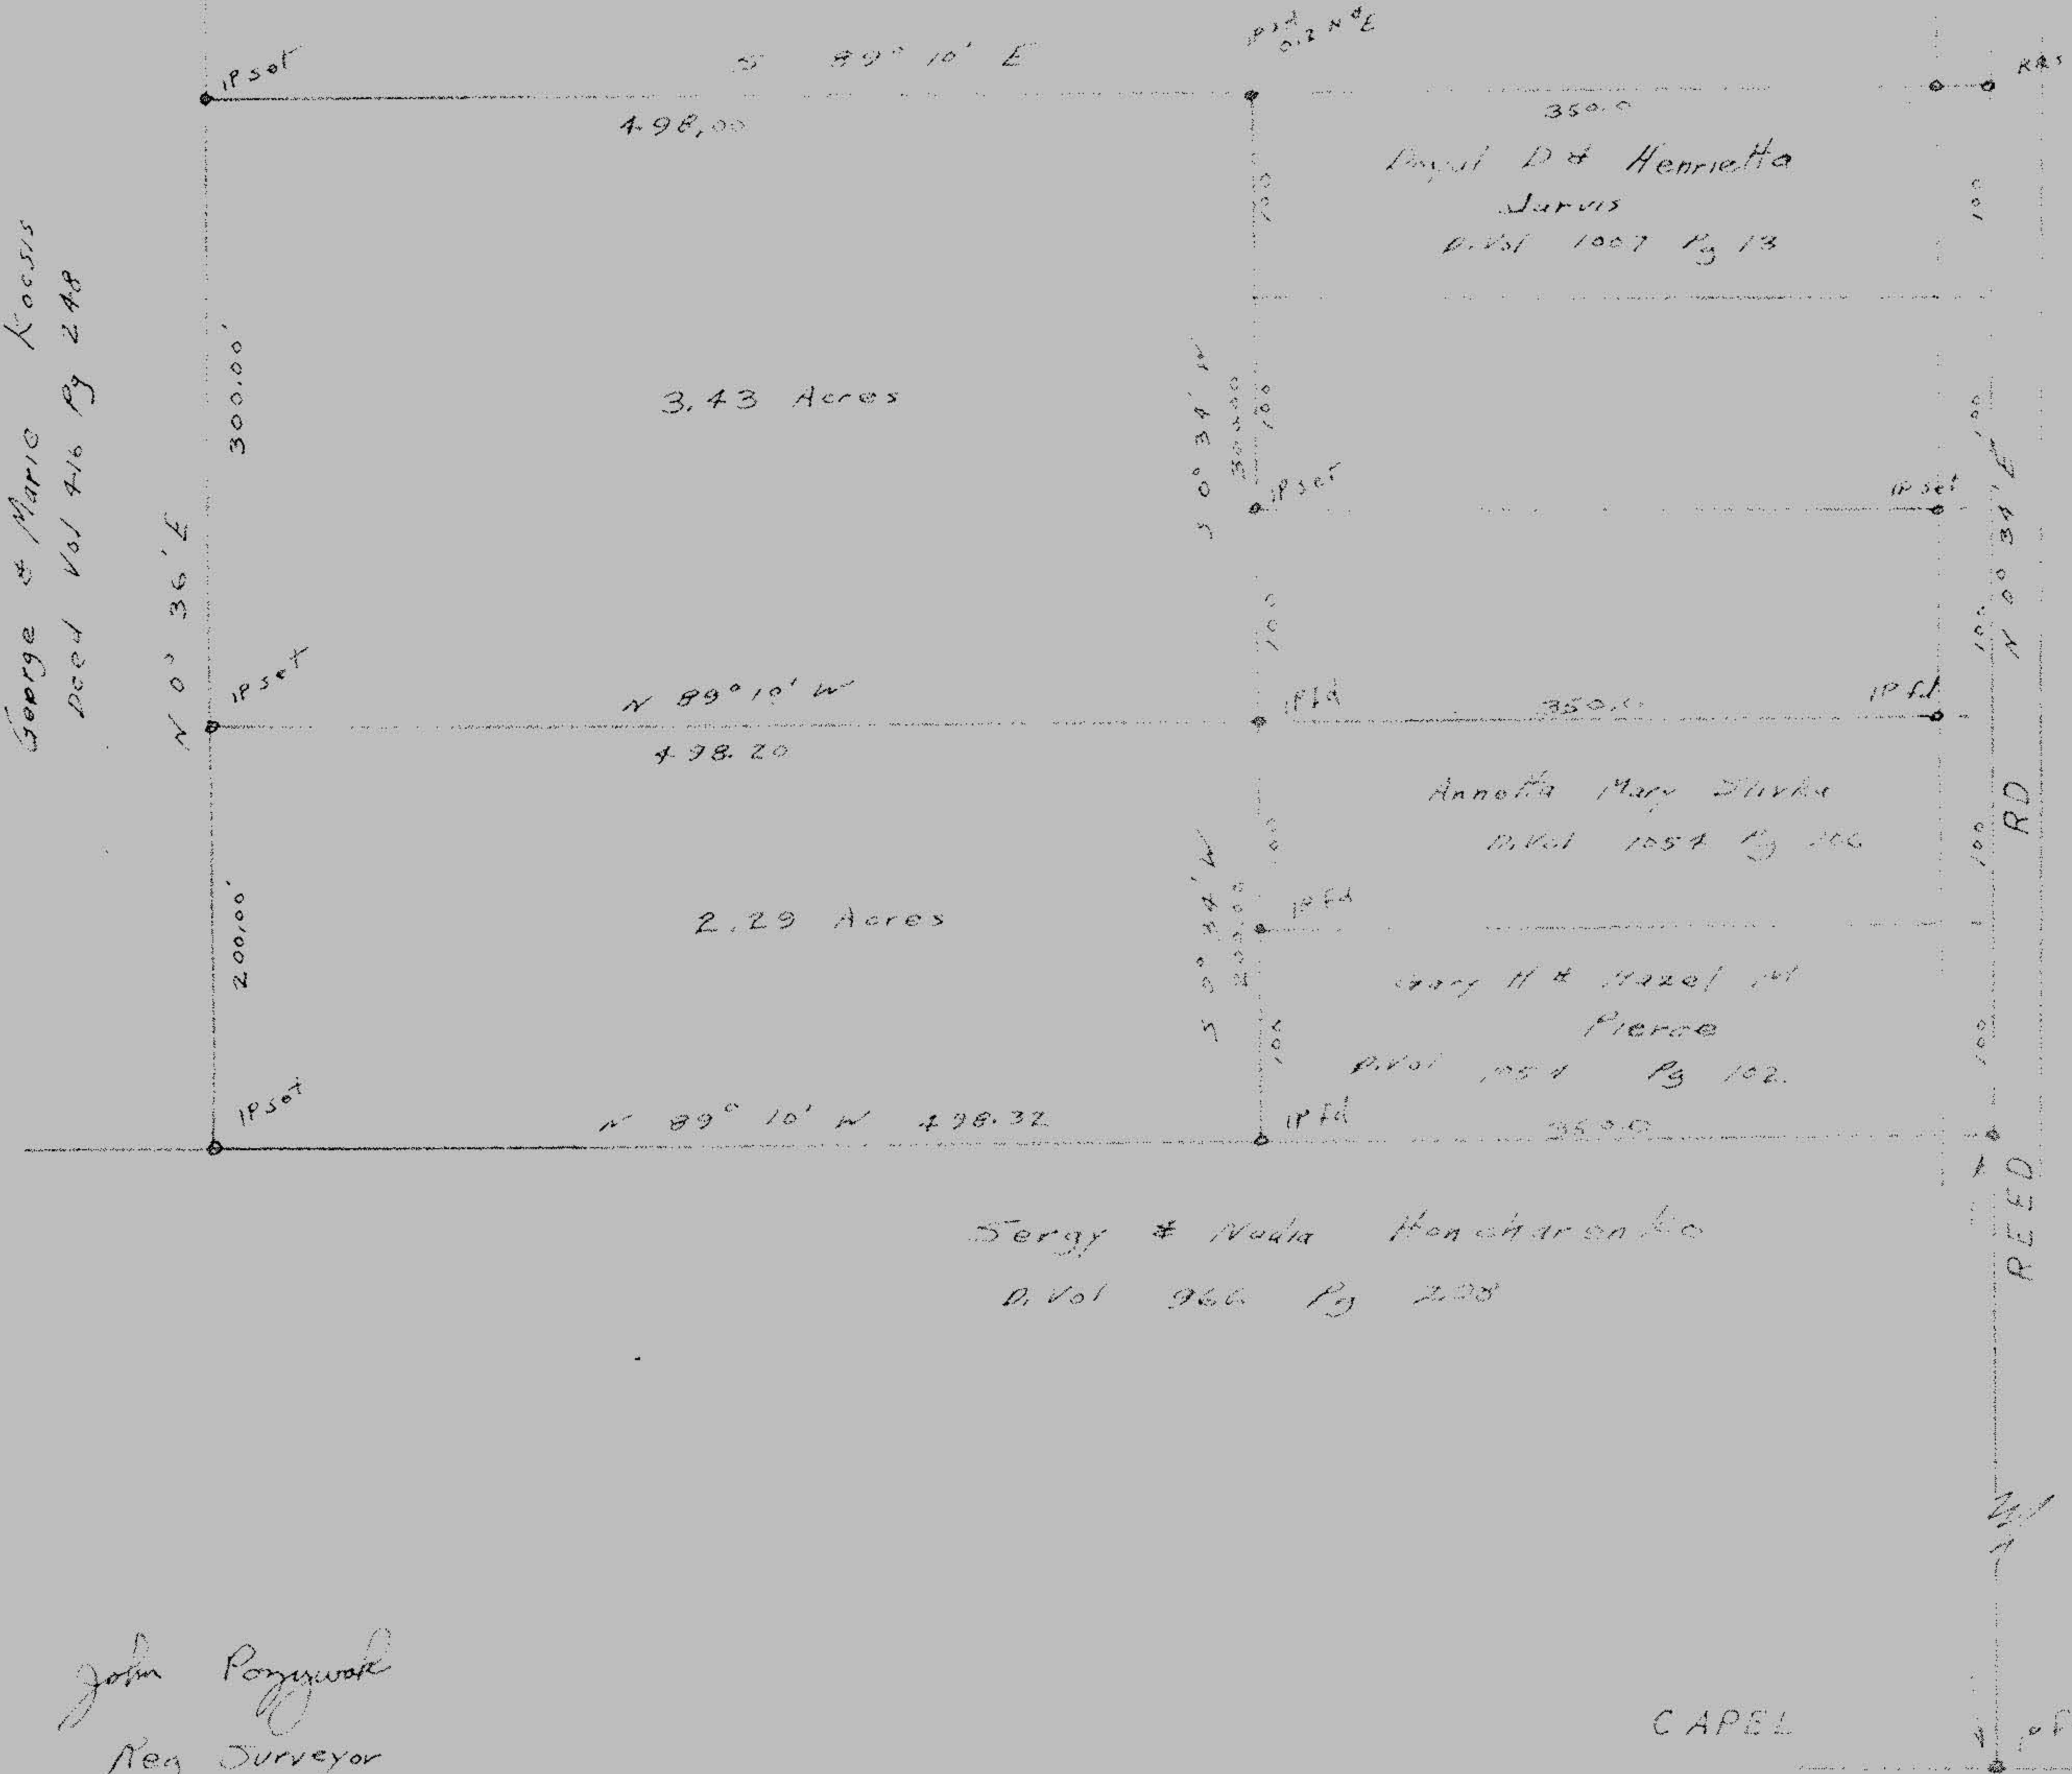

P.P. NO. 11-00-024-000-036,023,024,070,071,017	
SPLIT #	DATE OF SURVEY June 1974
MAP PAGE 11-00-024-B	
SURVEYOR John Poznyak	

Survey for
James M Elliott
Part of Original Lot 24
Eden Township
Lorain County, Ohio
Scale 1" = 200 June 1974

John Poznyak
Reg Surveyor
#5292

CAPEL ROAD