

6-19 16844 06-23-001-103-030



KLEINOEDER-SCHMIDT

and ASSOCIATES

ENGINEERS — SURVEYORS — CONSULTANTS IN LAND PLANNING
ELYRIA - NORWALK - MEDINA OHIO

SURVEY

Sublot(s) _____
Subd'n _____

Township ELYZIA Tract BRACE
Orig. Lot(s) 1 Sec. _____
County of LORAIN State of Ohio
Corporation _____


16844

7-8-81
6-19
C. FRANKS
VOID AFTER 16844



WEST RIDGE ROAD

DELLEFIELD ROAD

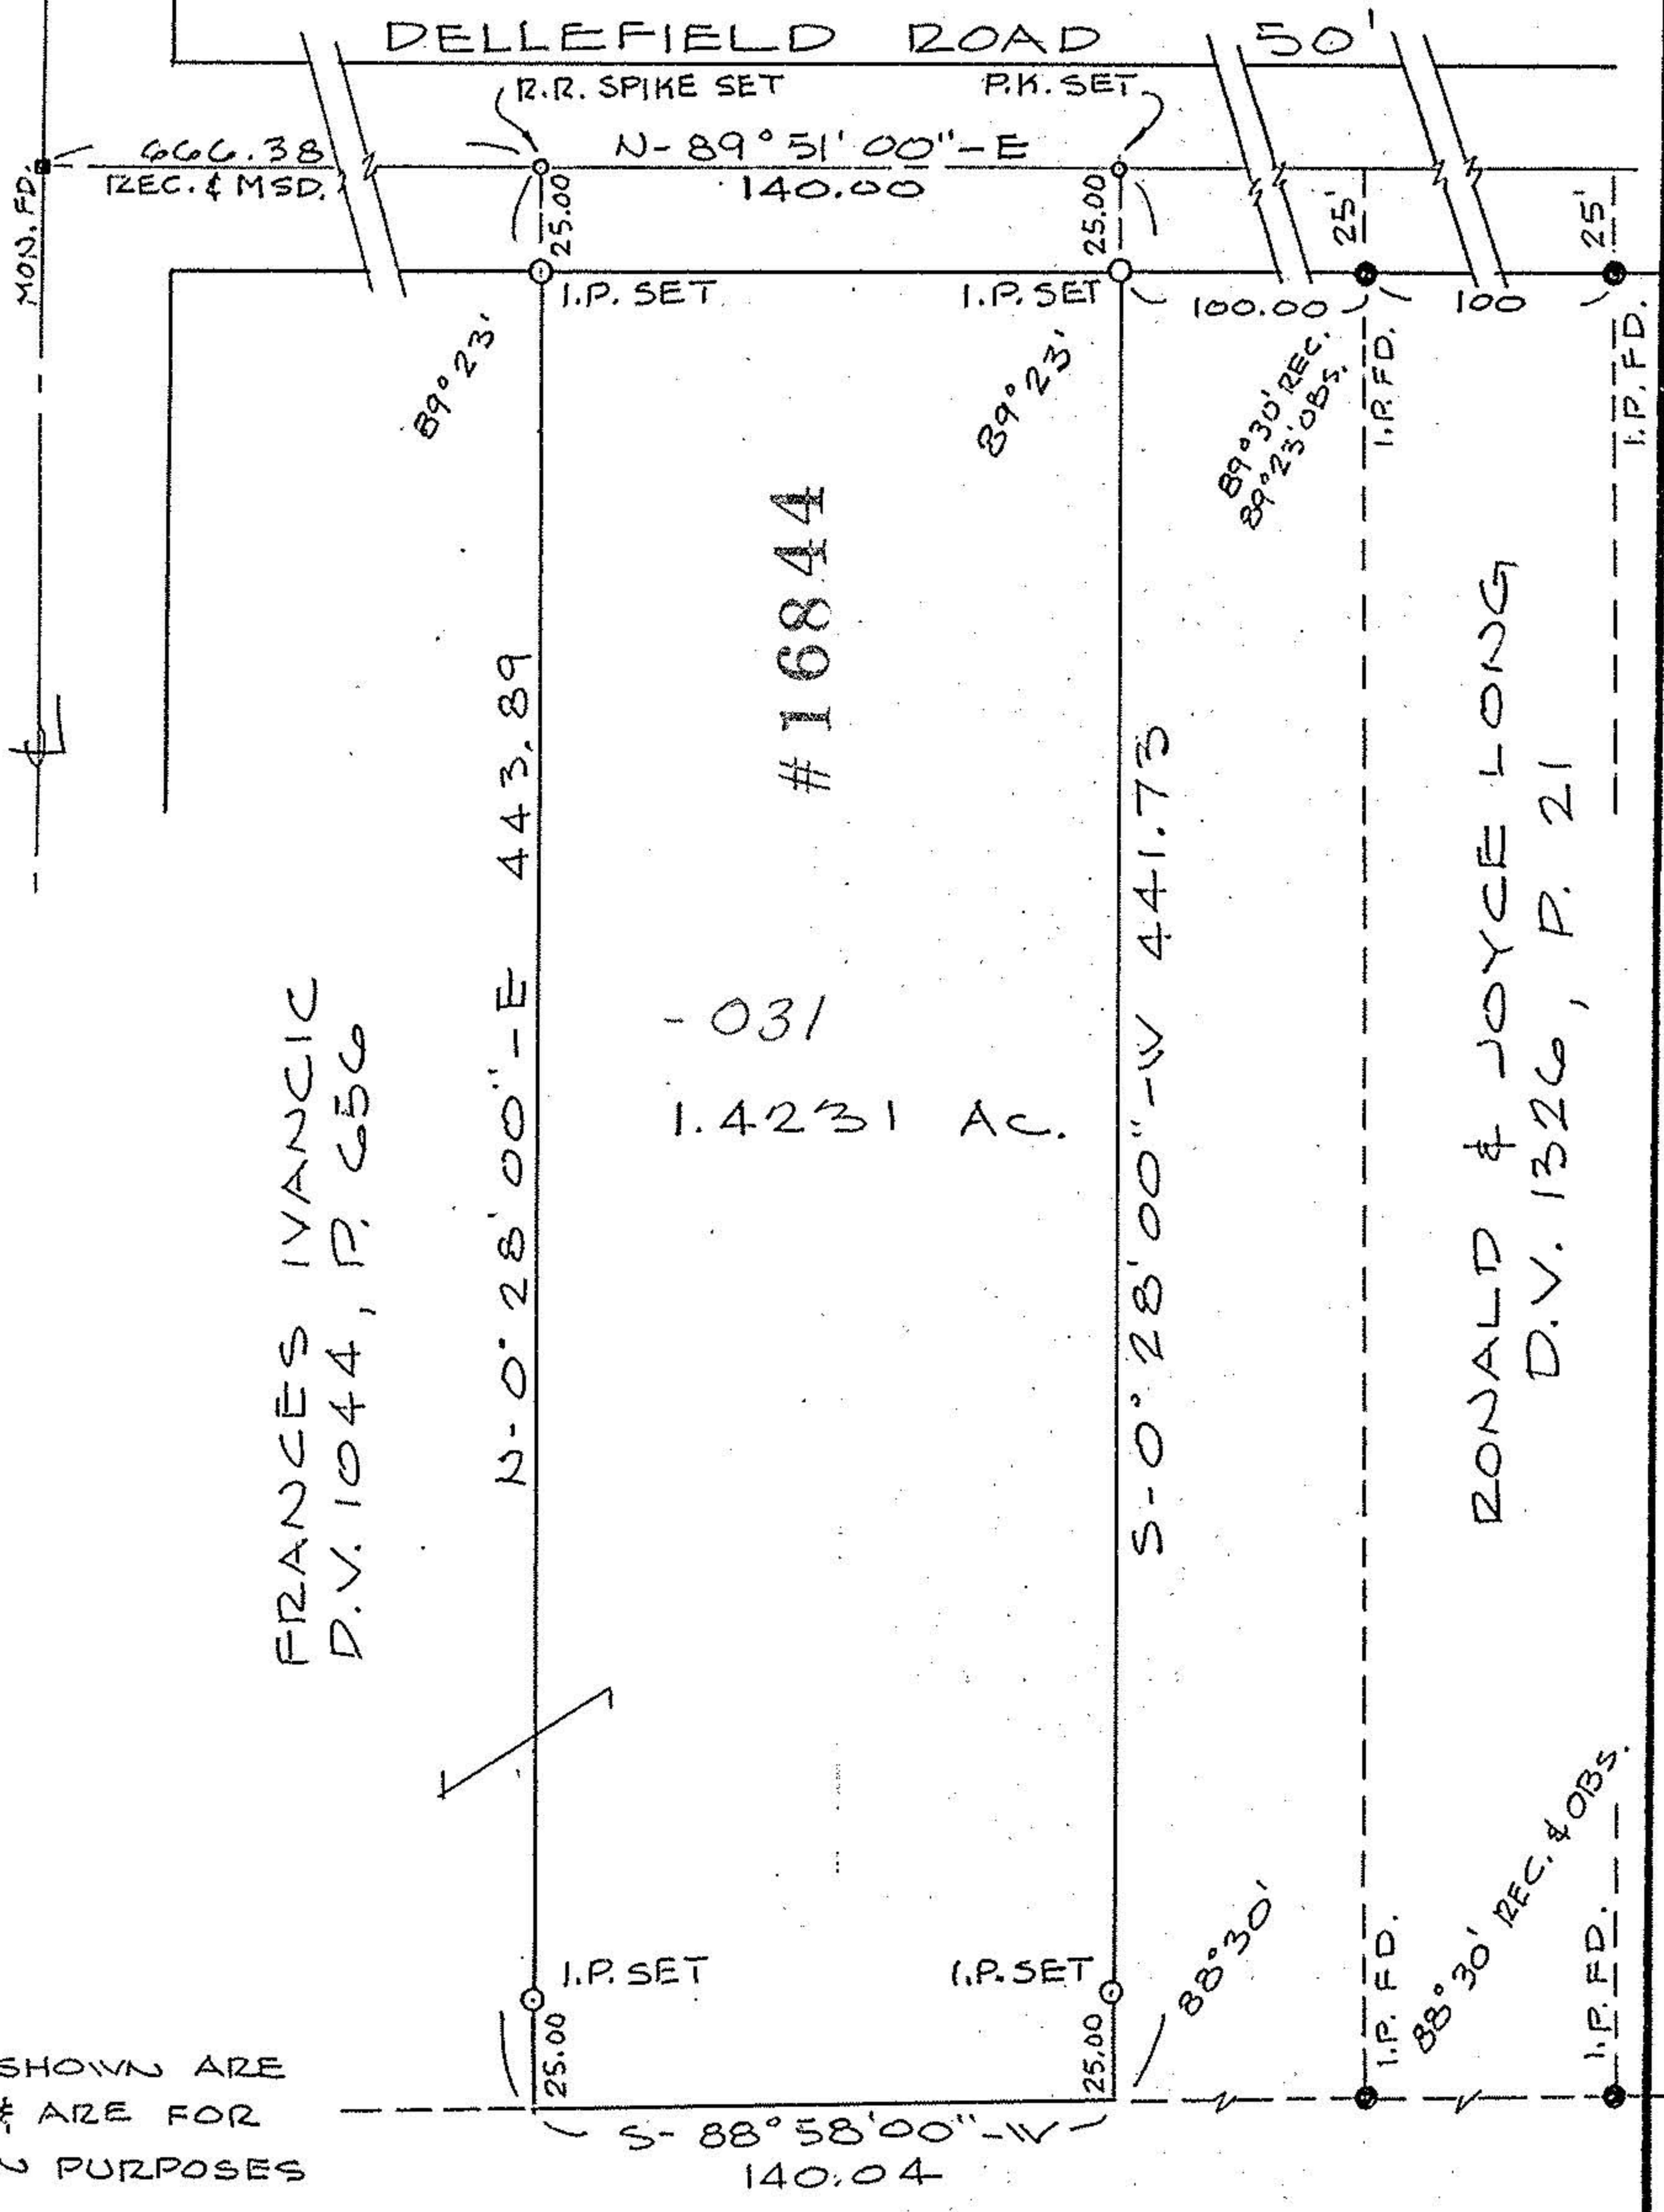

NOTE:
BEARINGS SHOWN ARE ASSUMED & ARE FOR DESCRIPTION PURPOSES ONLY.

Prepared for: WILLIAM J. IVANCIC