


06-23-018-000

#18903

6-31

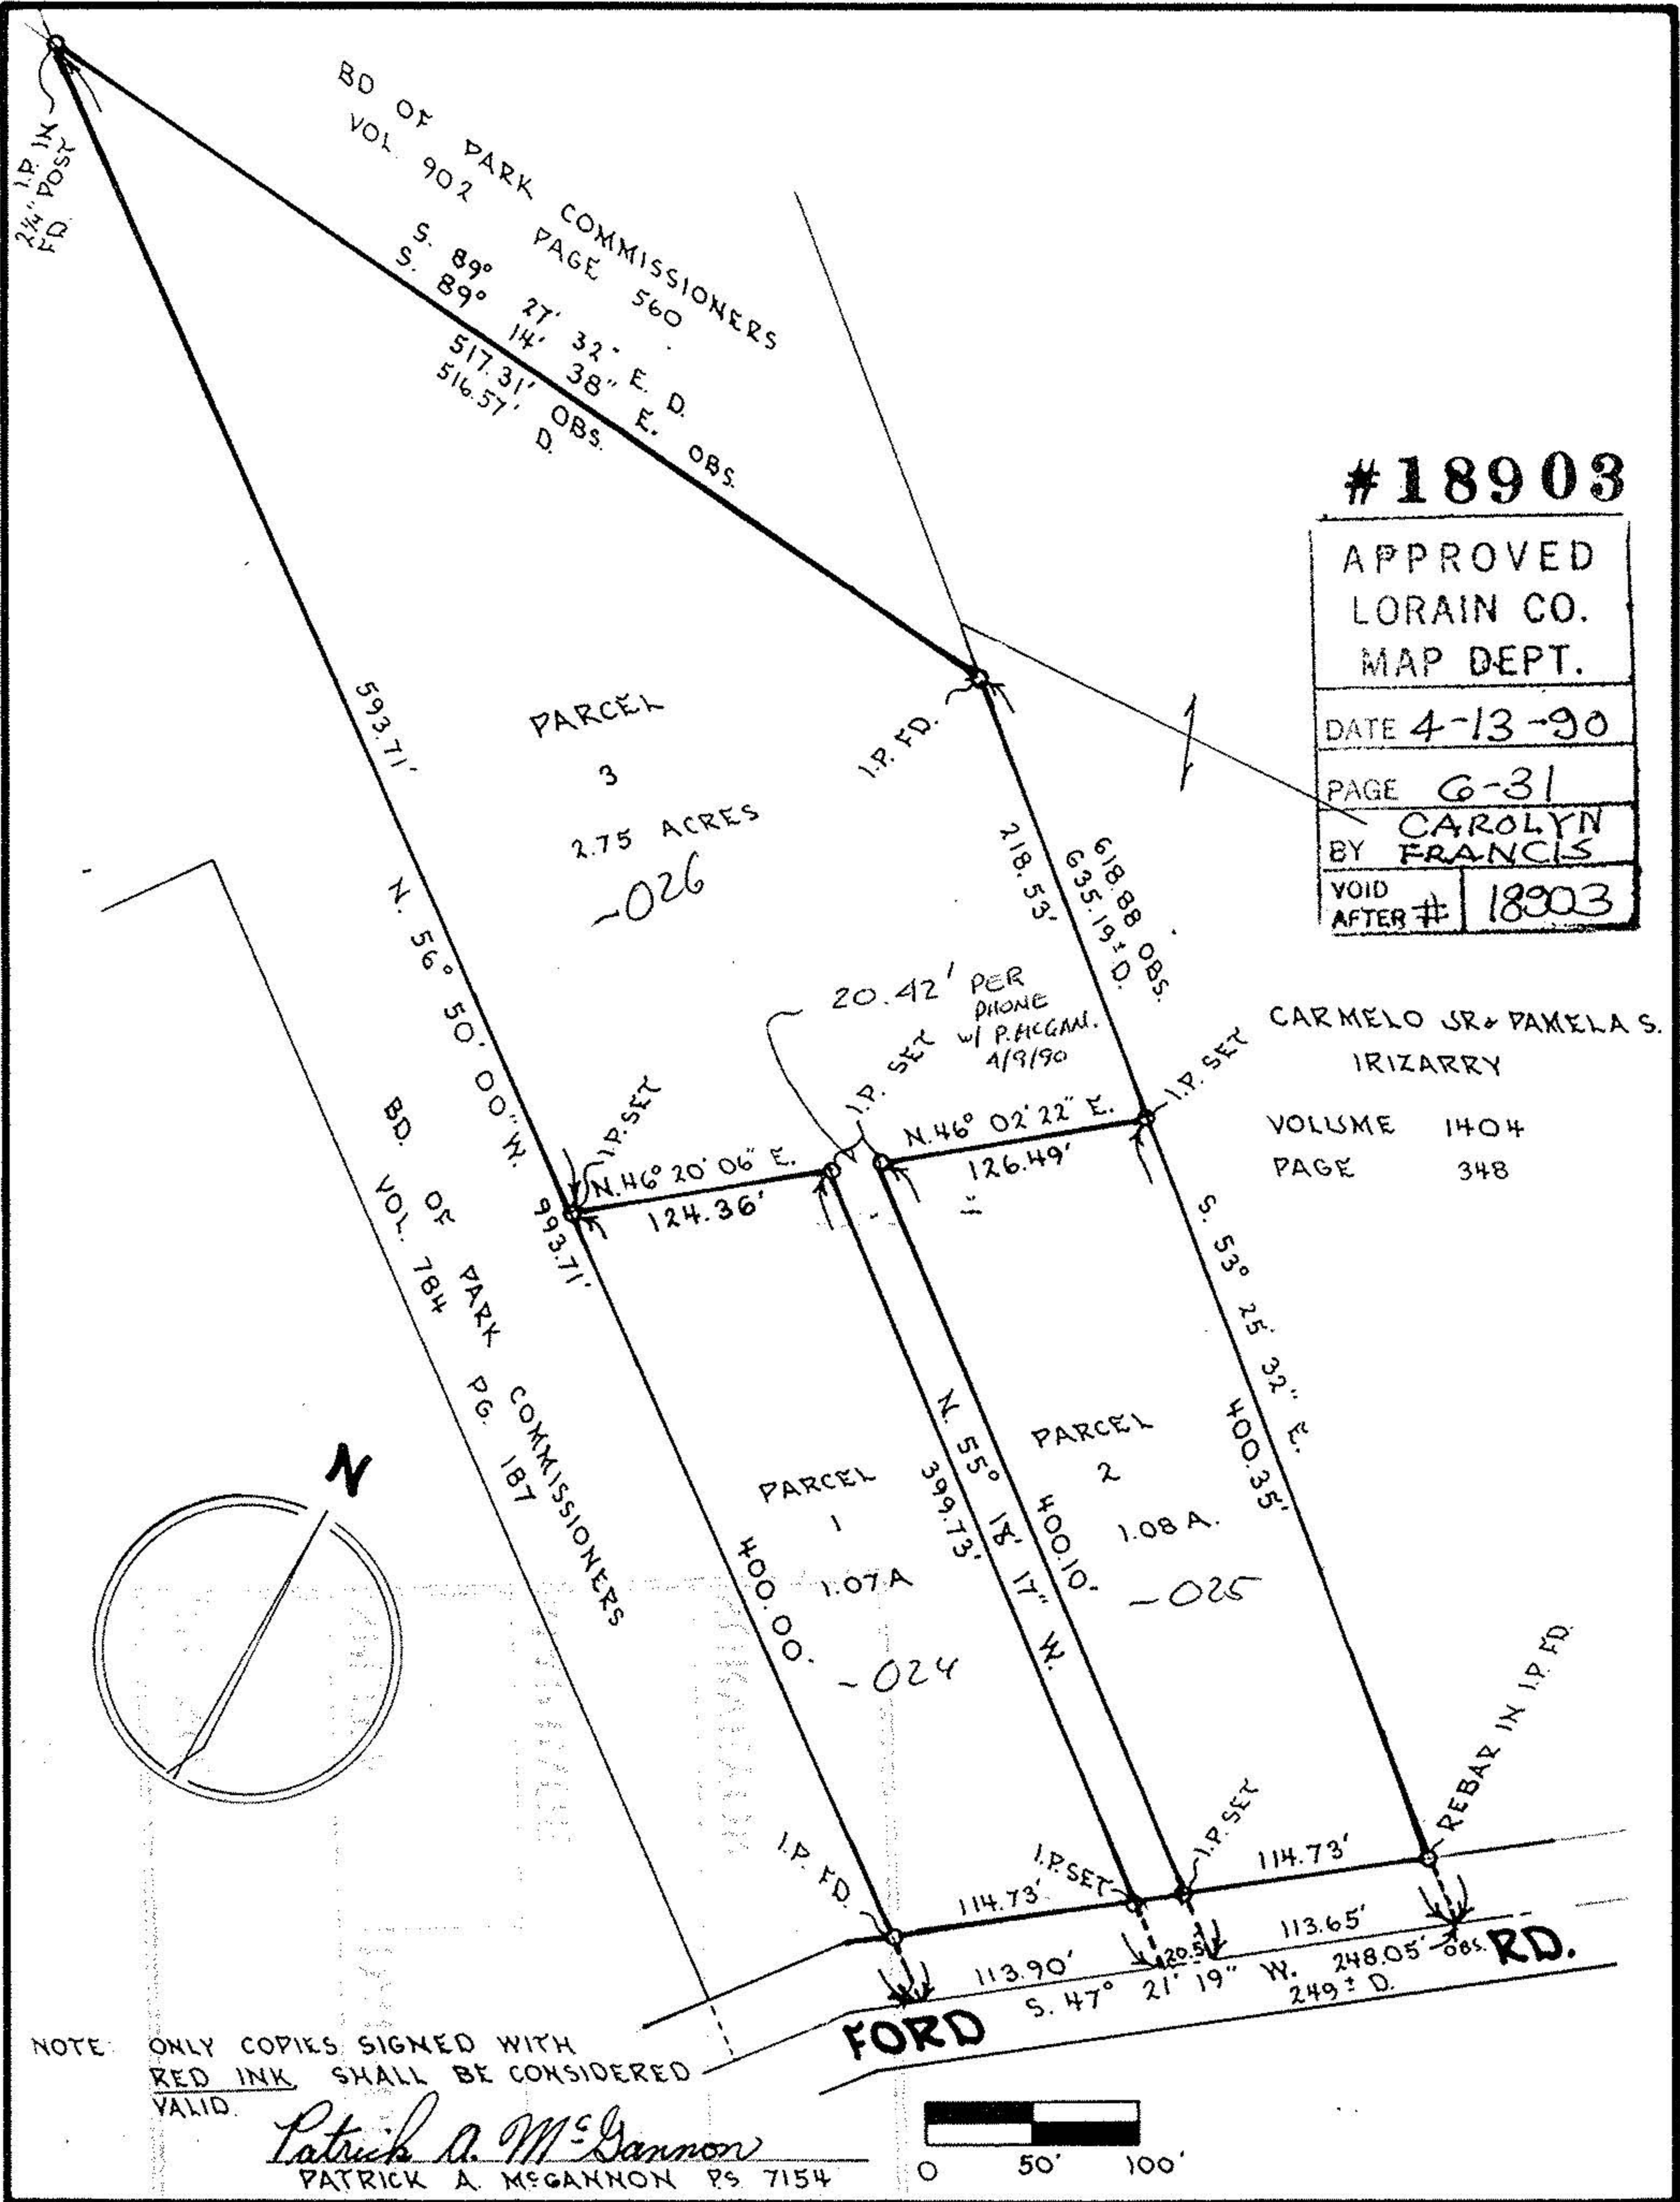

#18903

APPROVED
LORAIN CO.
MAP DEPT.
DATE 4-13-90
PAGE 6-31
BY CAROLYN FRANCIS
VOID AFTER # 18903

CARMELO JR & PAMELA S. IRIZARRY
 VOLUME 1404
 PAGE 348

NOTE: ONLY COPIES SIGNED WITH RED INK SHALL BE CONSIDERED VALID.

Patrick A. McGannon
 PATRICK A. MCGANNON PS 7154



Boundary Survey		Date 14-OCTOBER-1989
Prepared For: ROY E. & DEBORAH COLLINS		Drawn P.A.M.G.
PROPOSED LOT SPLIT OF 06-23-018-000-014 IN THE CITY OF ELYRIA, COUNTY OF LORAIN AND STATE OF OHIO.		Scale 1" = 100'
Patrick A. McGannon, Registered Professional Surveyor 1731 Gettysburg Drive, Lorain, Ohio., Ph (216) 282 2712		