





0 200 400 600

-012 Gilbert E. & Joyce M. Haury V. 1193 P. 624

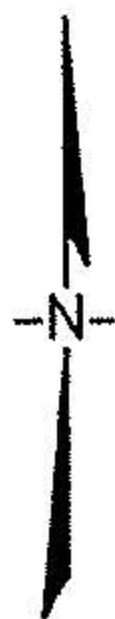


Assumed  
March 2004

- =Iron Pipe Found
- × =Iron Pin Set
- =Monument Box

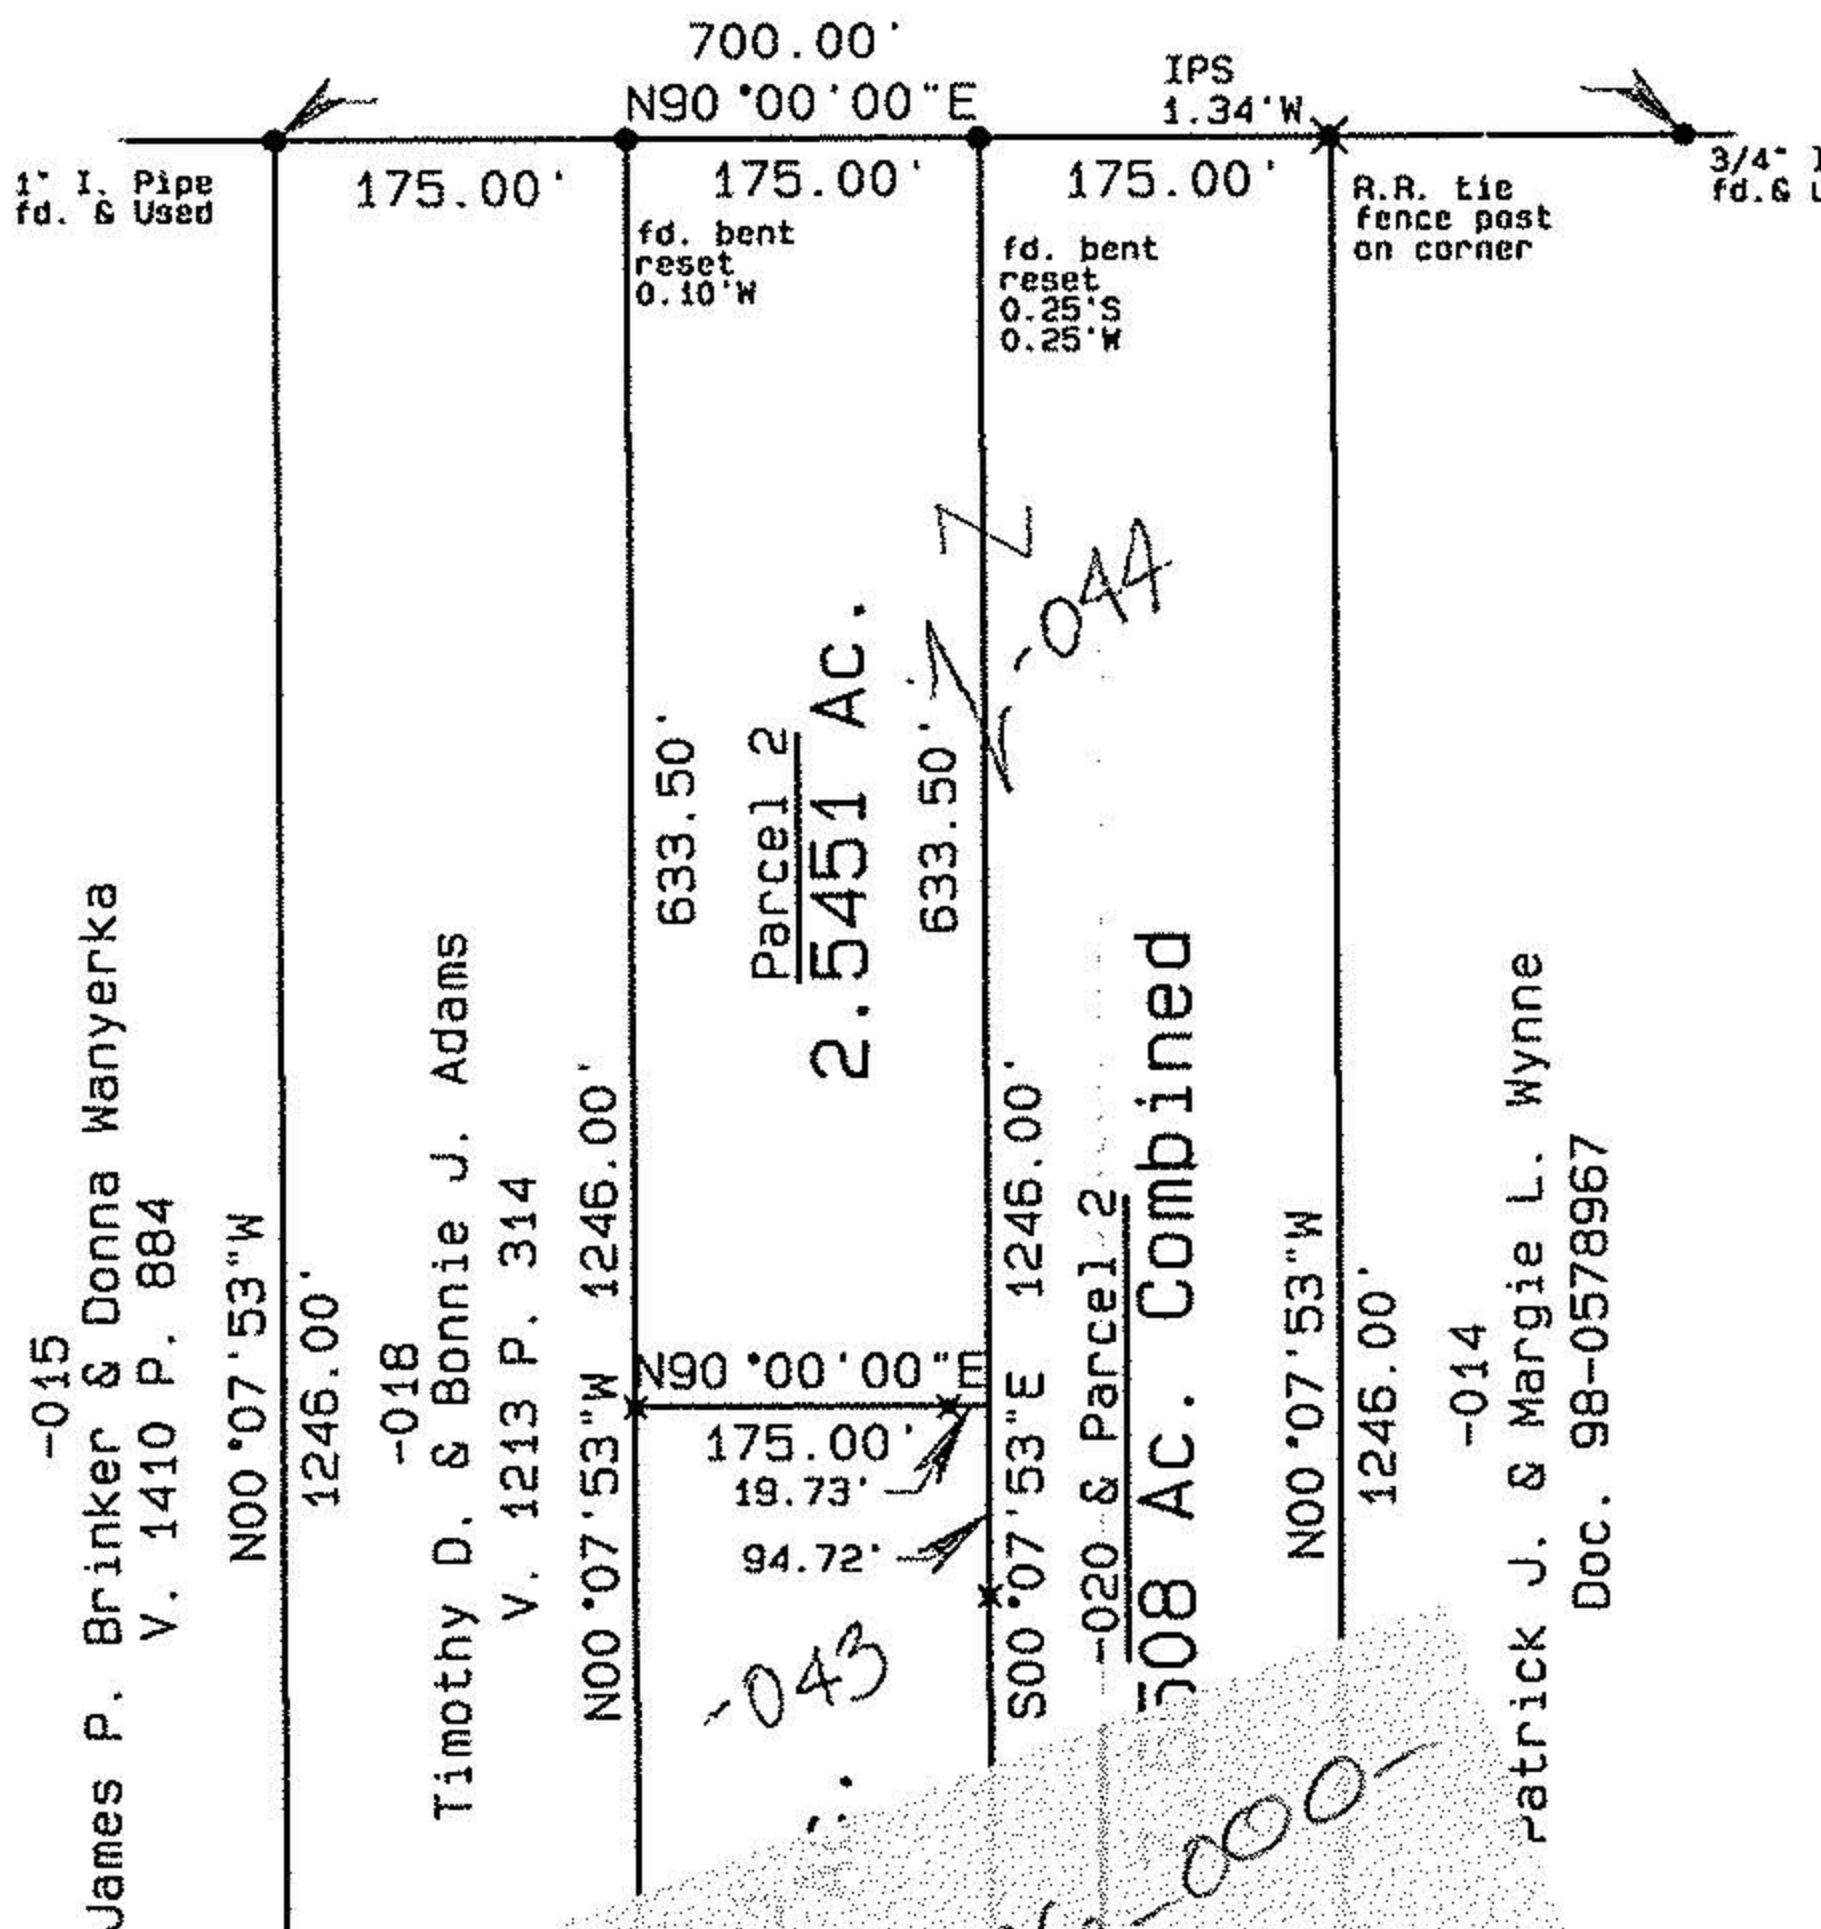

O.L. 85

O.L. 86

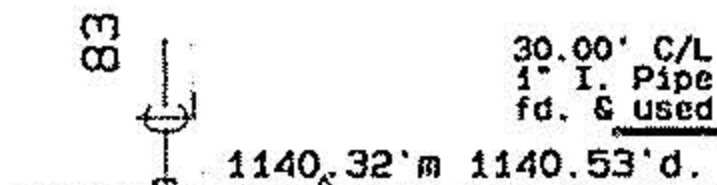

O.L. 96

S.R.

O.L. 95

NEF

No. 01634

APPROVED  
LORAIN CO.  
MAP DEPT

DATE 6-1-04

PAGE 16-00-086-B

BY JHaffield

# 04 01634

TIM ADAMS

Grafton Twp.  
Lorain Co.

ESKUT

O.L. 86  
Ohio

CARLSON SURVEYS

440-926-0200  
Job #1601-41

*Handwritten notes:*  
16-00-086-000  
042  
Three  
0 1/4

-015  
James P. Brinker & Donna Wanyerka  
V. 1410 P. 884

-018  
Timothy D. & Bonnie J. Adams  
V. 1213 P. 314

-014  
Patrick J. & Margie L. Wynne  
Doc. 98-0578967