




SURVEY FOR  
**MERRILL E. & GLORIA M. STUDESAKER**  
 AND  
**CYNTHIA BURGE**

PART OF O.L. 9 TOWNSHIP OF WELLINGTON  
 COUNTY OF LORAIN STATE OF OHIO  
 SCALE 1"=150' DEC. 1995  
 LAINBOM, SIMON, CAHL & ASSOC.  
 PROFESSIONAL LAND SURVEYORS  
 JOB NO. 95-2197 50 238 P 10-11

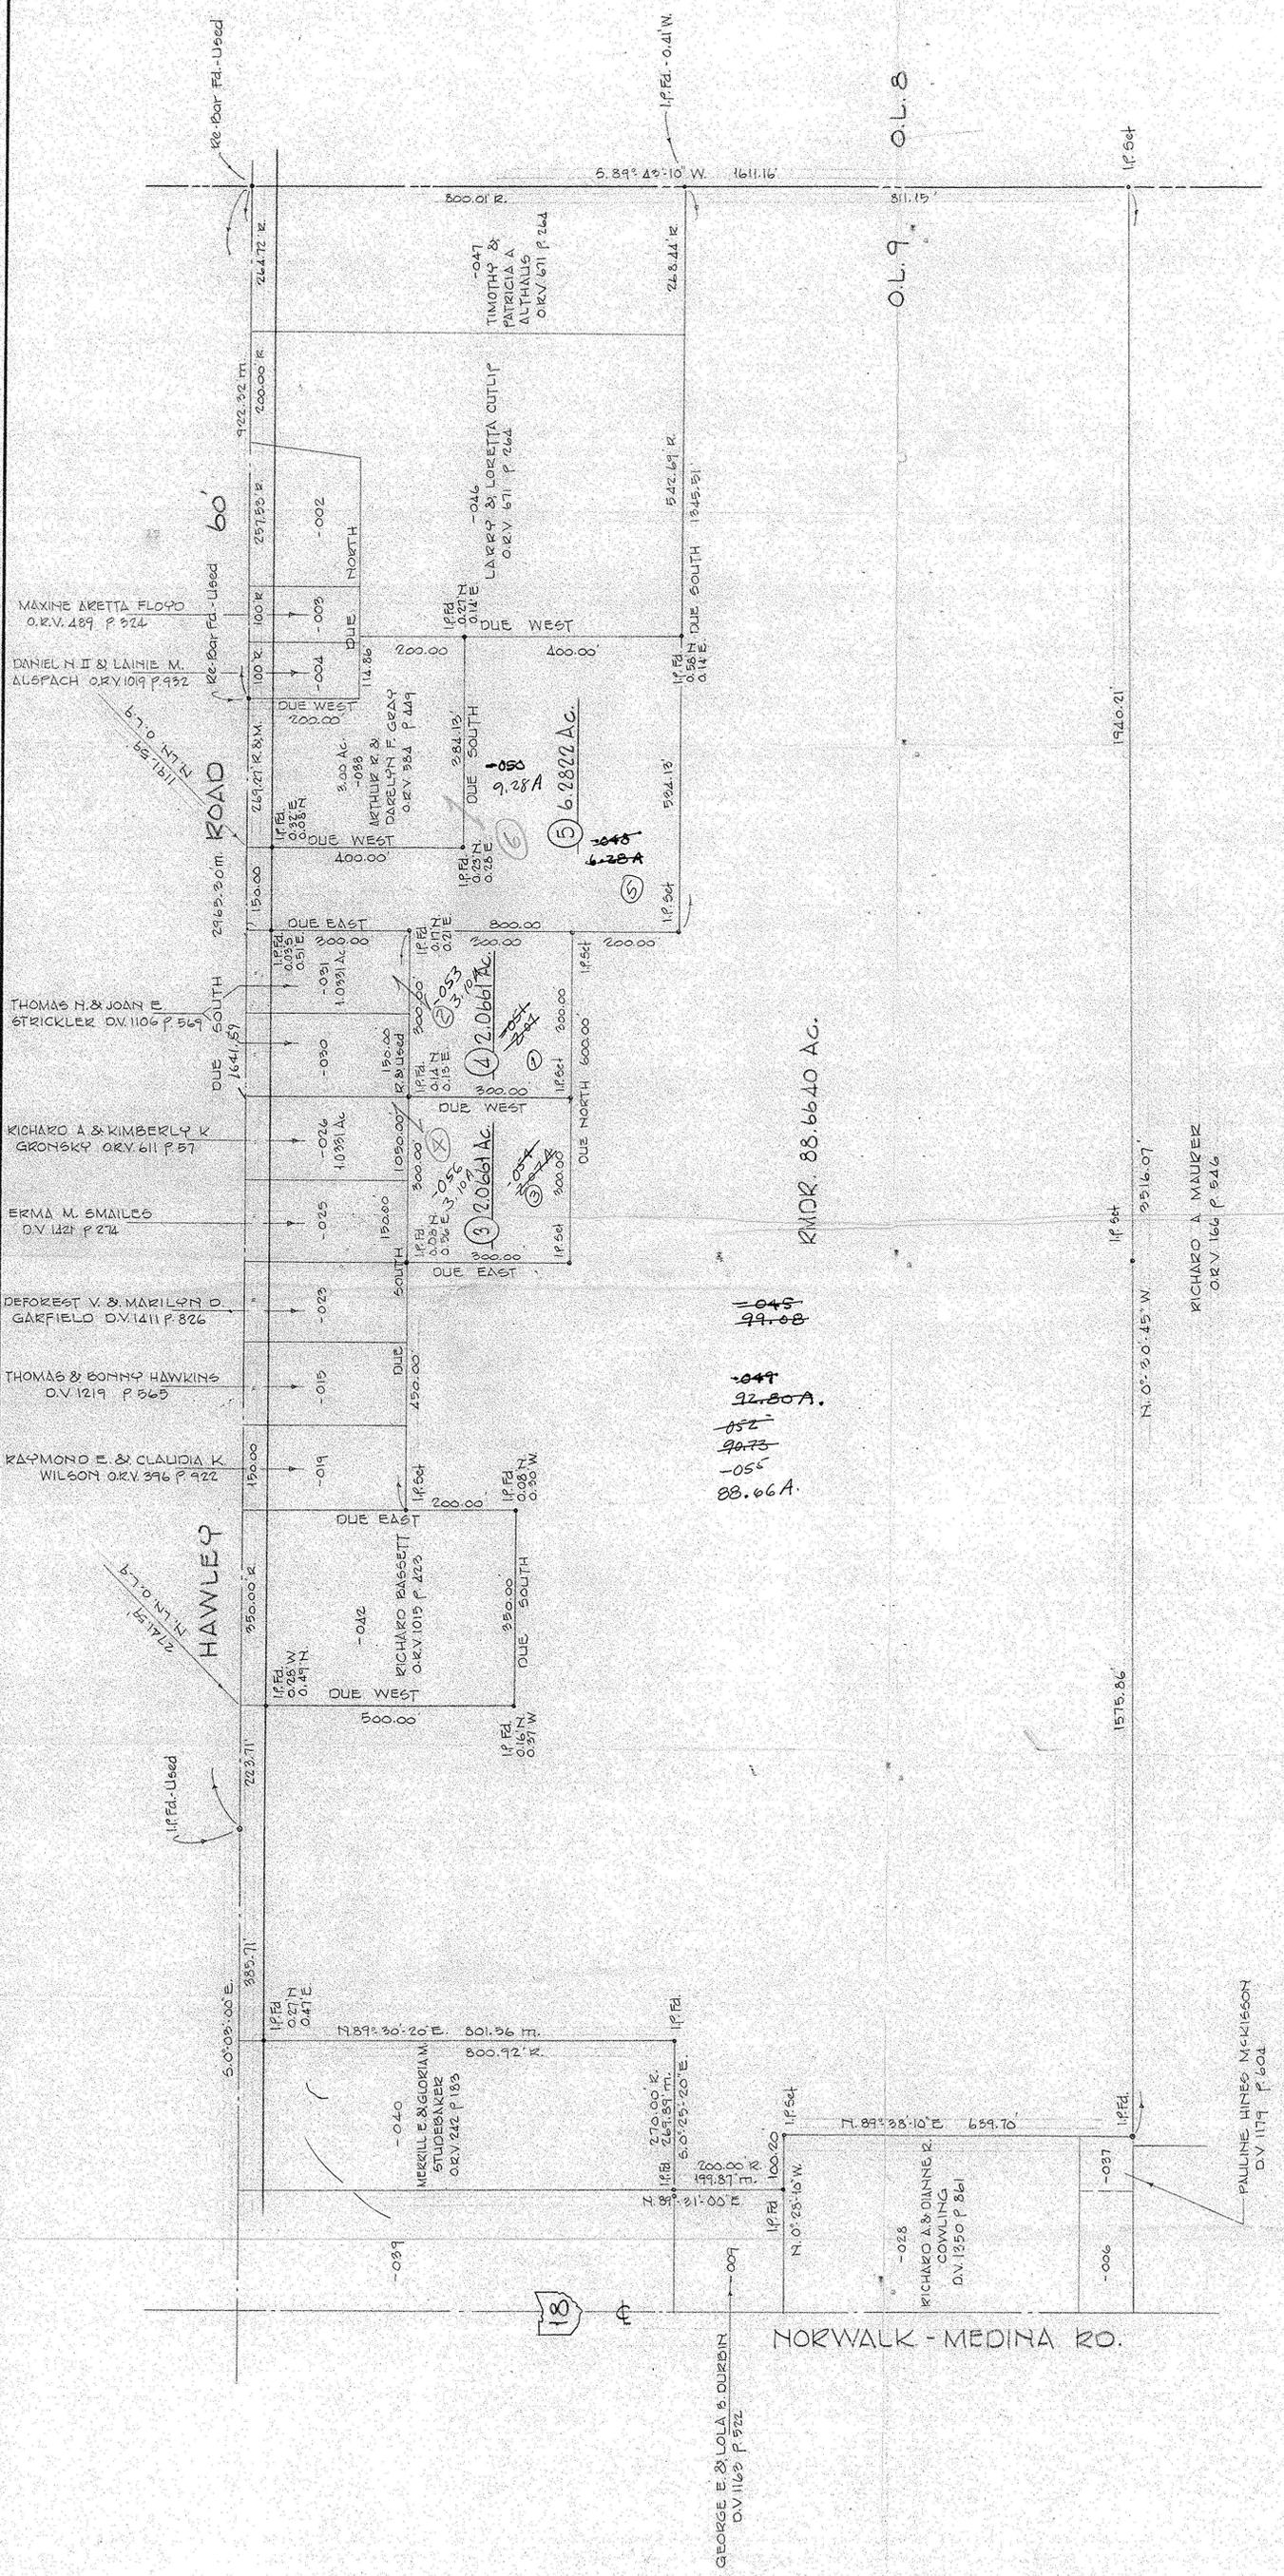

RMOR. 88.6640 AC.  
 -045-  
 99.68  
 -049  
 92.80A.  
 -052-  
 90.75  
 -055-  
 88.66A.

**#22635**  
 APPROVED  
 LORAIN CO.  
 MAP DEPT.  
 DATE 9-3-98  
 PAGE 18-D  
 BY *[Signature]*  
 JOB NUMBER 22635

