


PLAT OF BOUNDARY SURVEY
DALE H. RICHMOND
 PART OF ORIGINAL LOT 57
 TOWNSHIP OF AMHERST, LORAIN COUNTY, OHIO

BEARINGS ARE ASSUMED.

ERROR OF CLOSURE IS LESS THAN 1:10,000.

SCALE 1"=60'

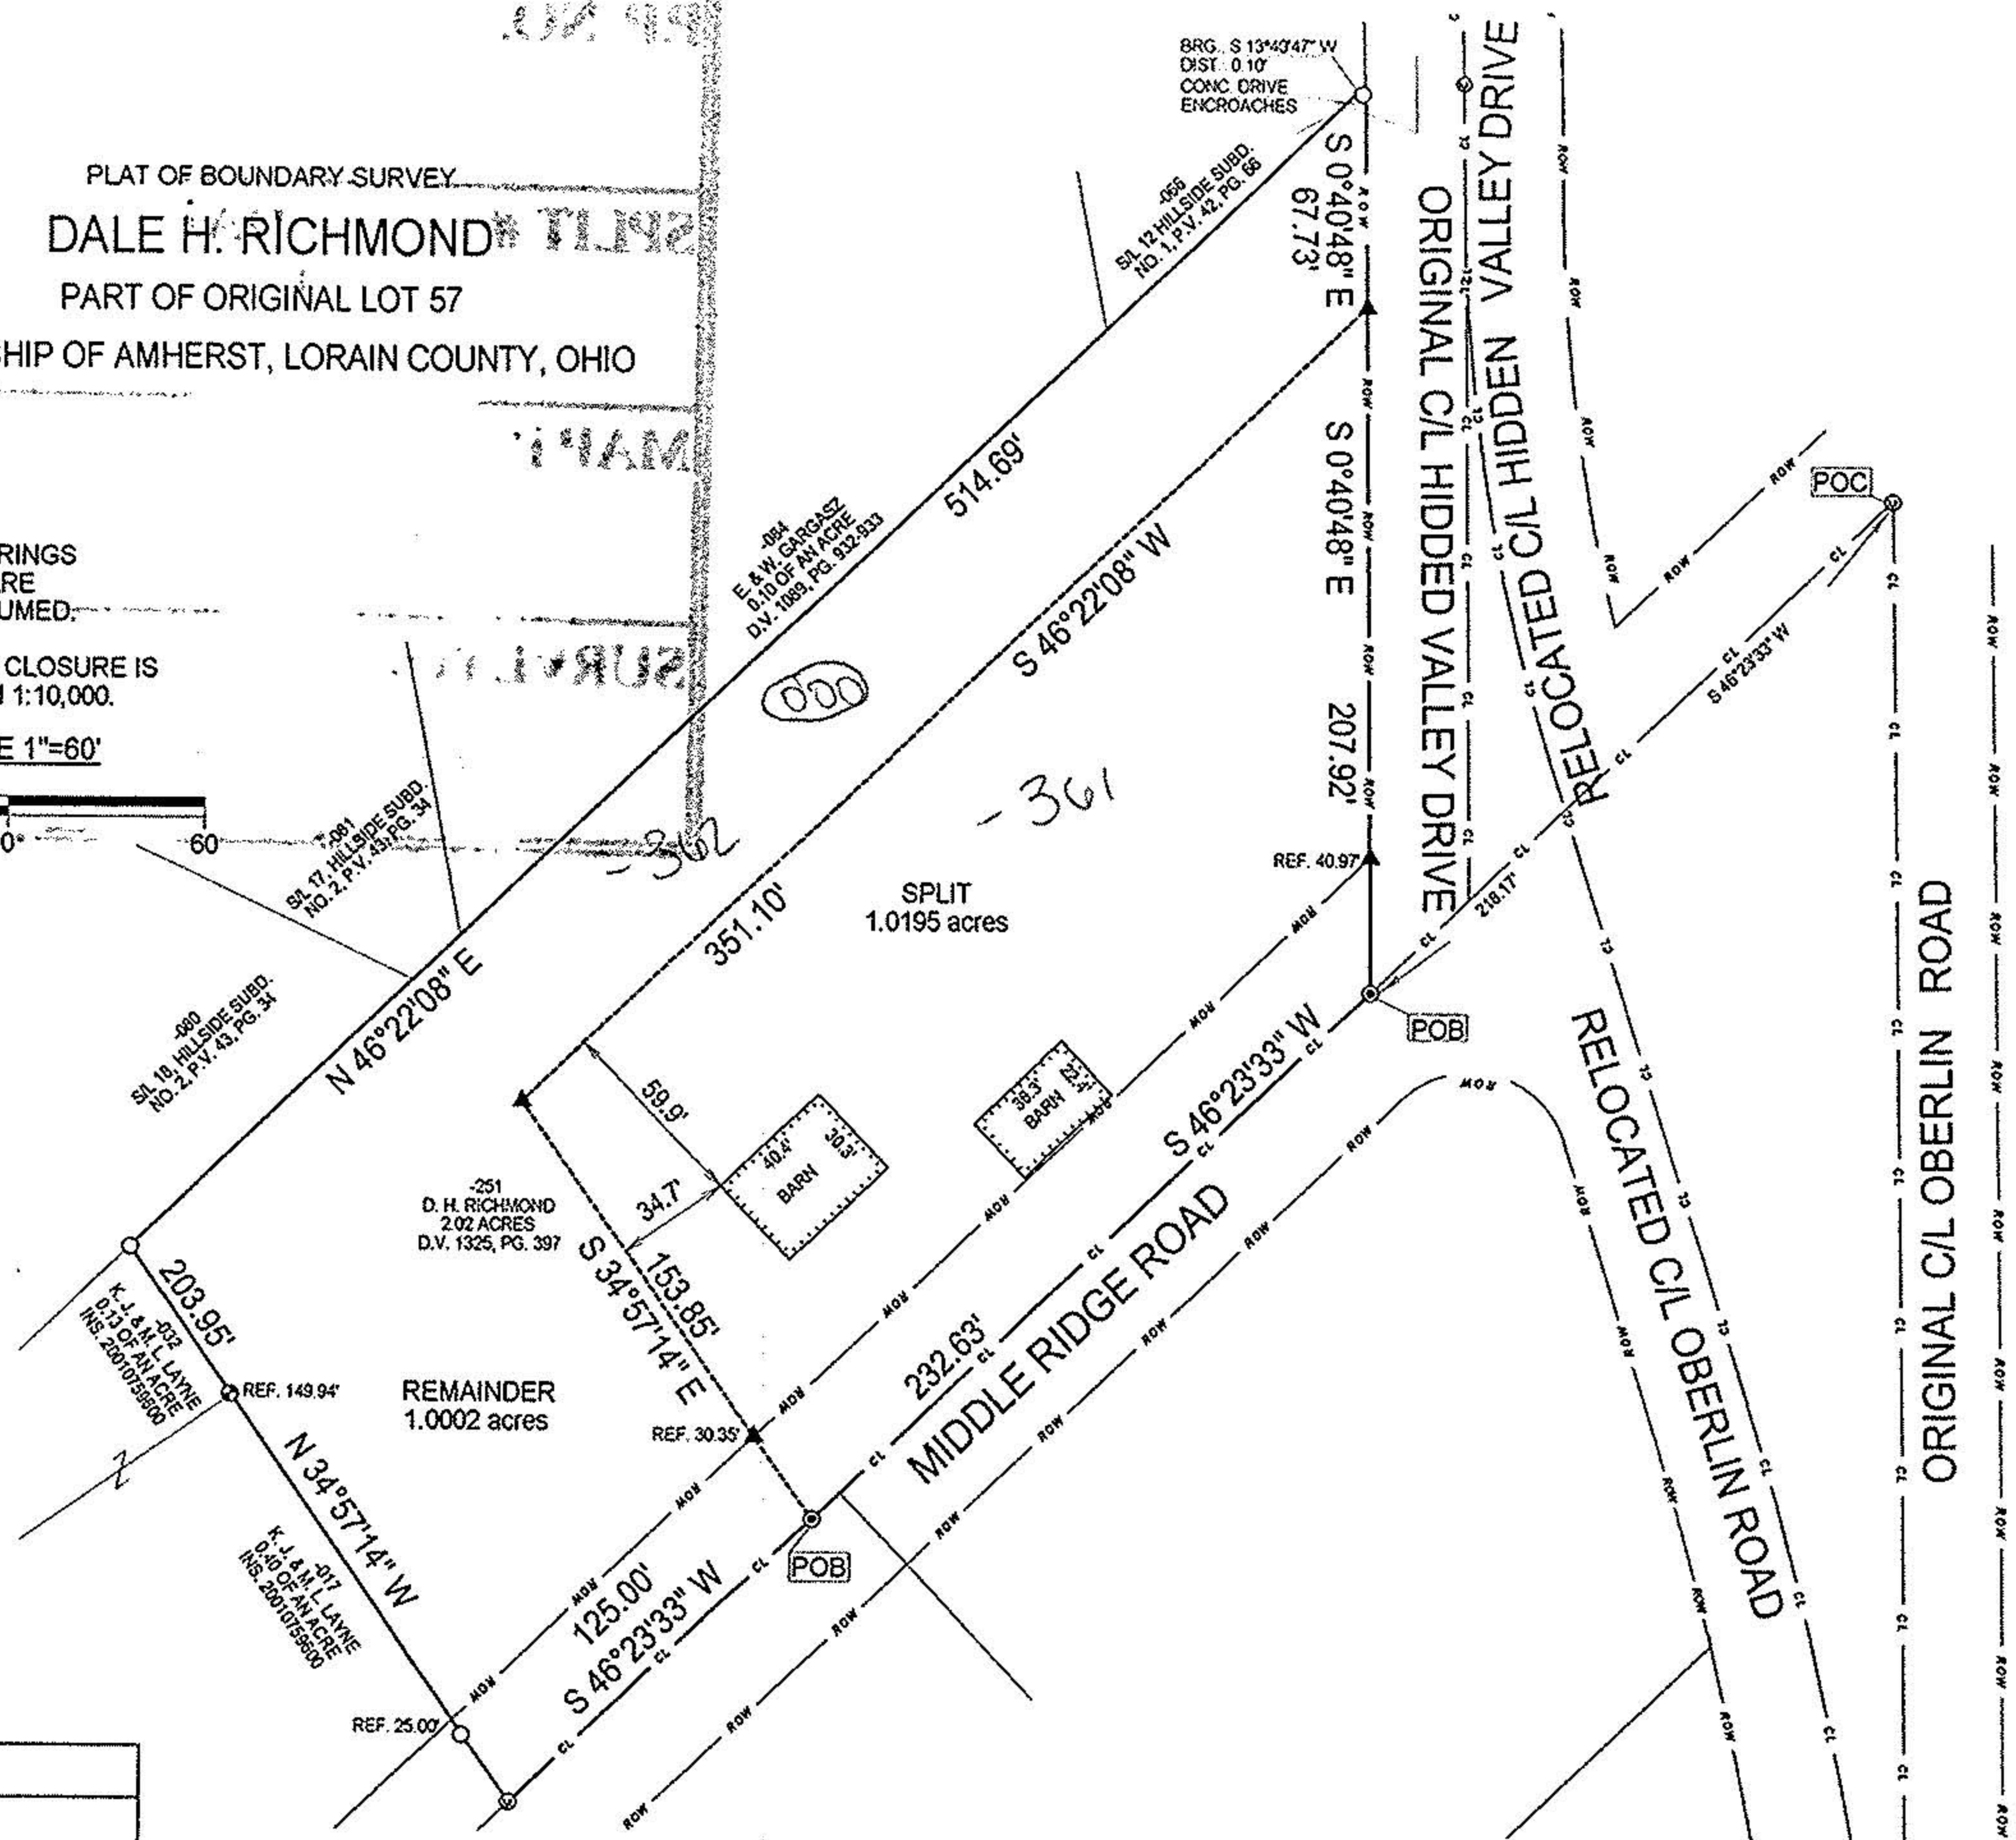

Legend

- Iron Pipe Found
- ⊙ Concrete Monument Found
- ⊕ Iron Pin In Monument Box Found
- ⊙ Magnetic PK Spike Set
- ▲ 5/8" Iron Pin Set with Cap Stamped "Kelser 7871"

No 01705
 APPROVED
 LORAIN CO.
 MAP DEPT
 DATE 7-15-04
 PAGE 5-00-057-B
 BY JHAtfield
 #04-01705



LAUNDON • SIMON • KELSER & ASSOC., INC.
 PROFESSIONAL LAND SURVEYORS
 110 MIDDLE AVE. • ELYRIA, OHIO • 44035
 PHONE (440) 322-7625
 Alex Kelser
 RLS #7871

DATE: 6/1/04
 JOB NO.: 04-3714