

KLEINEDER-SCHMIDT AND ASSOCIATES

ELYRIA - NORWALK - MEDINA

ENGINEERS — SURVEYORS — CONSULTANTS IN LAND PLANNING

OHIO

SURVEY

Sublot(s) _____


Subd'n _____

Township EATON
Orig. Lots) 74
County of LORAIN
Corporation _____

Tract _____
Sec. _____
State of Ohio

#16986


APPROVED
LORAIN CO.
MAP DEPT.
DATE 9.9.86
PAGE 11-B & 11-00-074-A
BY T. McMain
VOID
AFTER _____

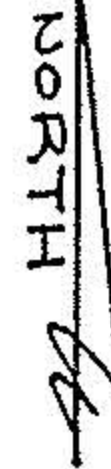

11-B
11-00-074-A

#16986

11-00-074-000

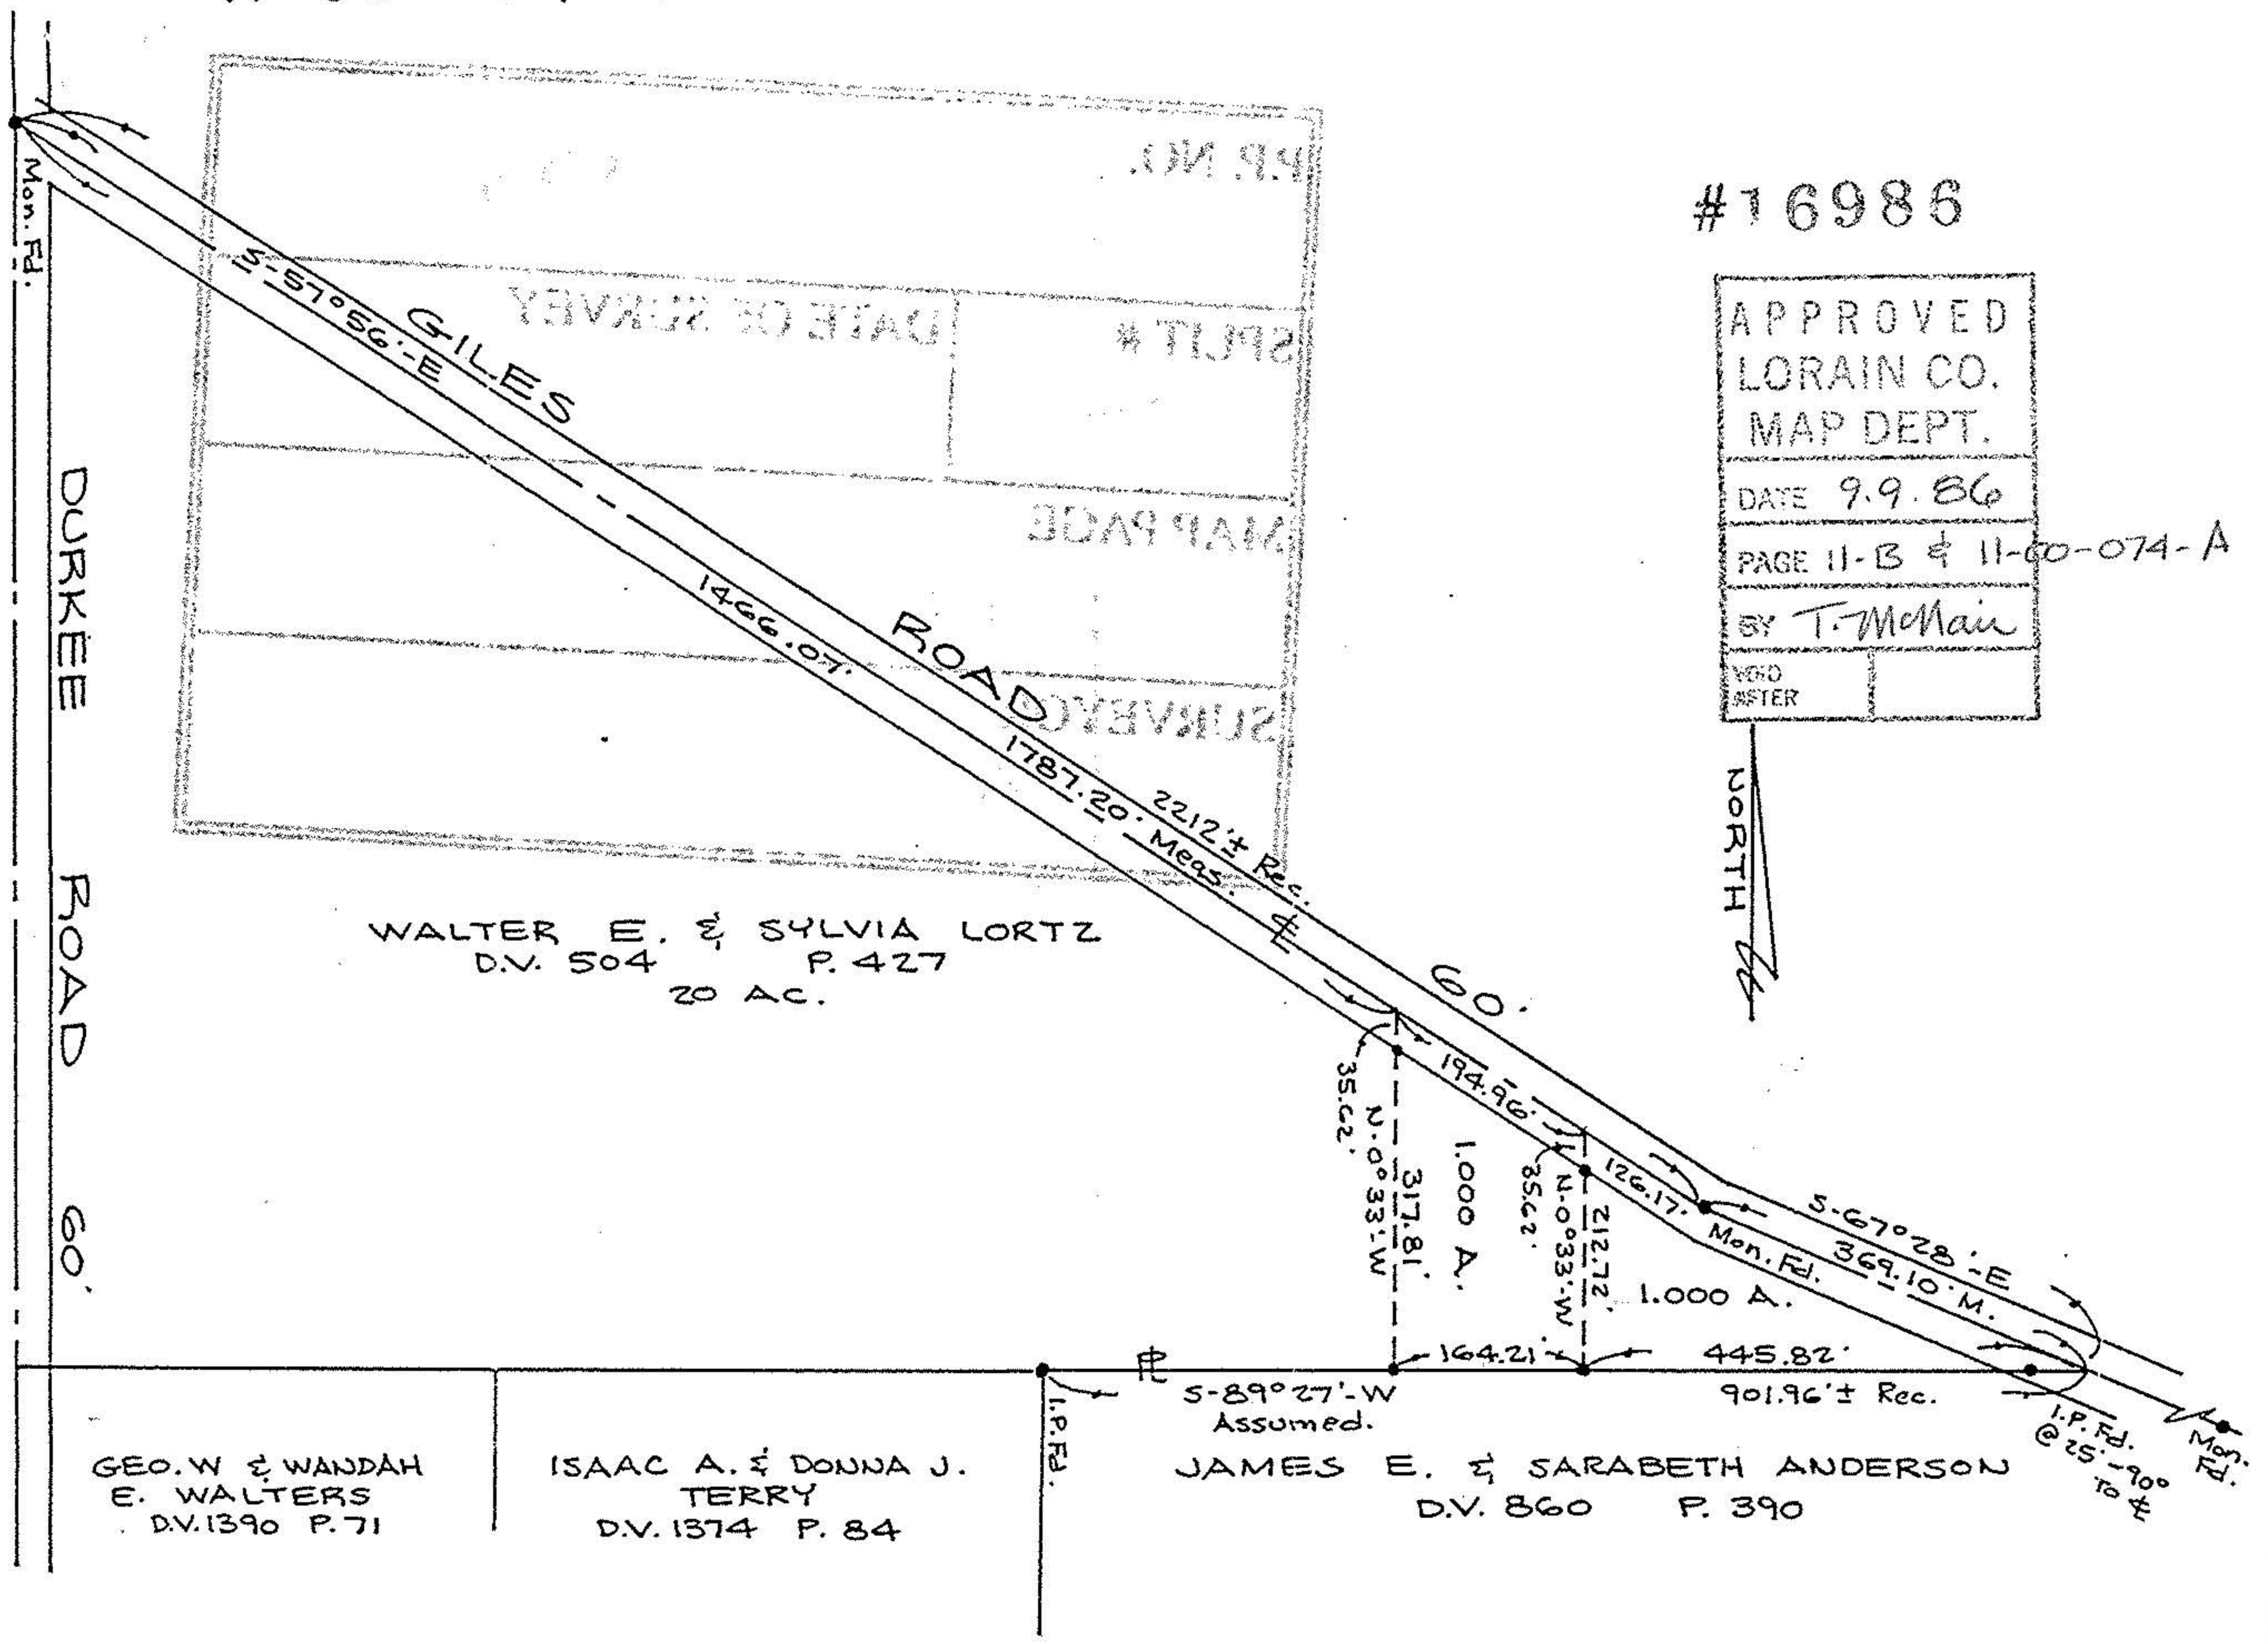

WALTER E. & SYLVIA LORTZ
D.V. 504 P. 427
20 AC.

GEO. W. & WANDAH
E. WALTERS
D.V. 1390 P. 71

ISAAC A. & DONNA J.
TERRY
D.V. 1374 P. 84

JAMES E. & SARABETH ANDERSON
D.V. 860 P. 390

Prepared for:

Scale: 1" = 200'

Date: AUG. 1, 1986

Dr. by: D.E.

Job No 86-146