



10651

11-00-076-000
OL 76 EATON TWP ROAD 60

JOSEPH & EVELYN SPANCKI
3-13-64 DV 574 P. 421

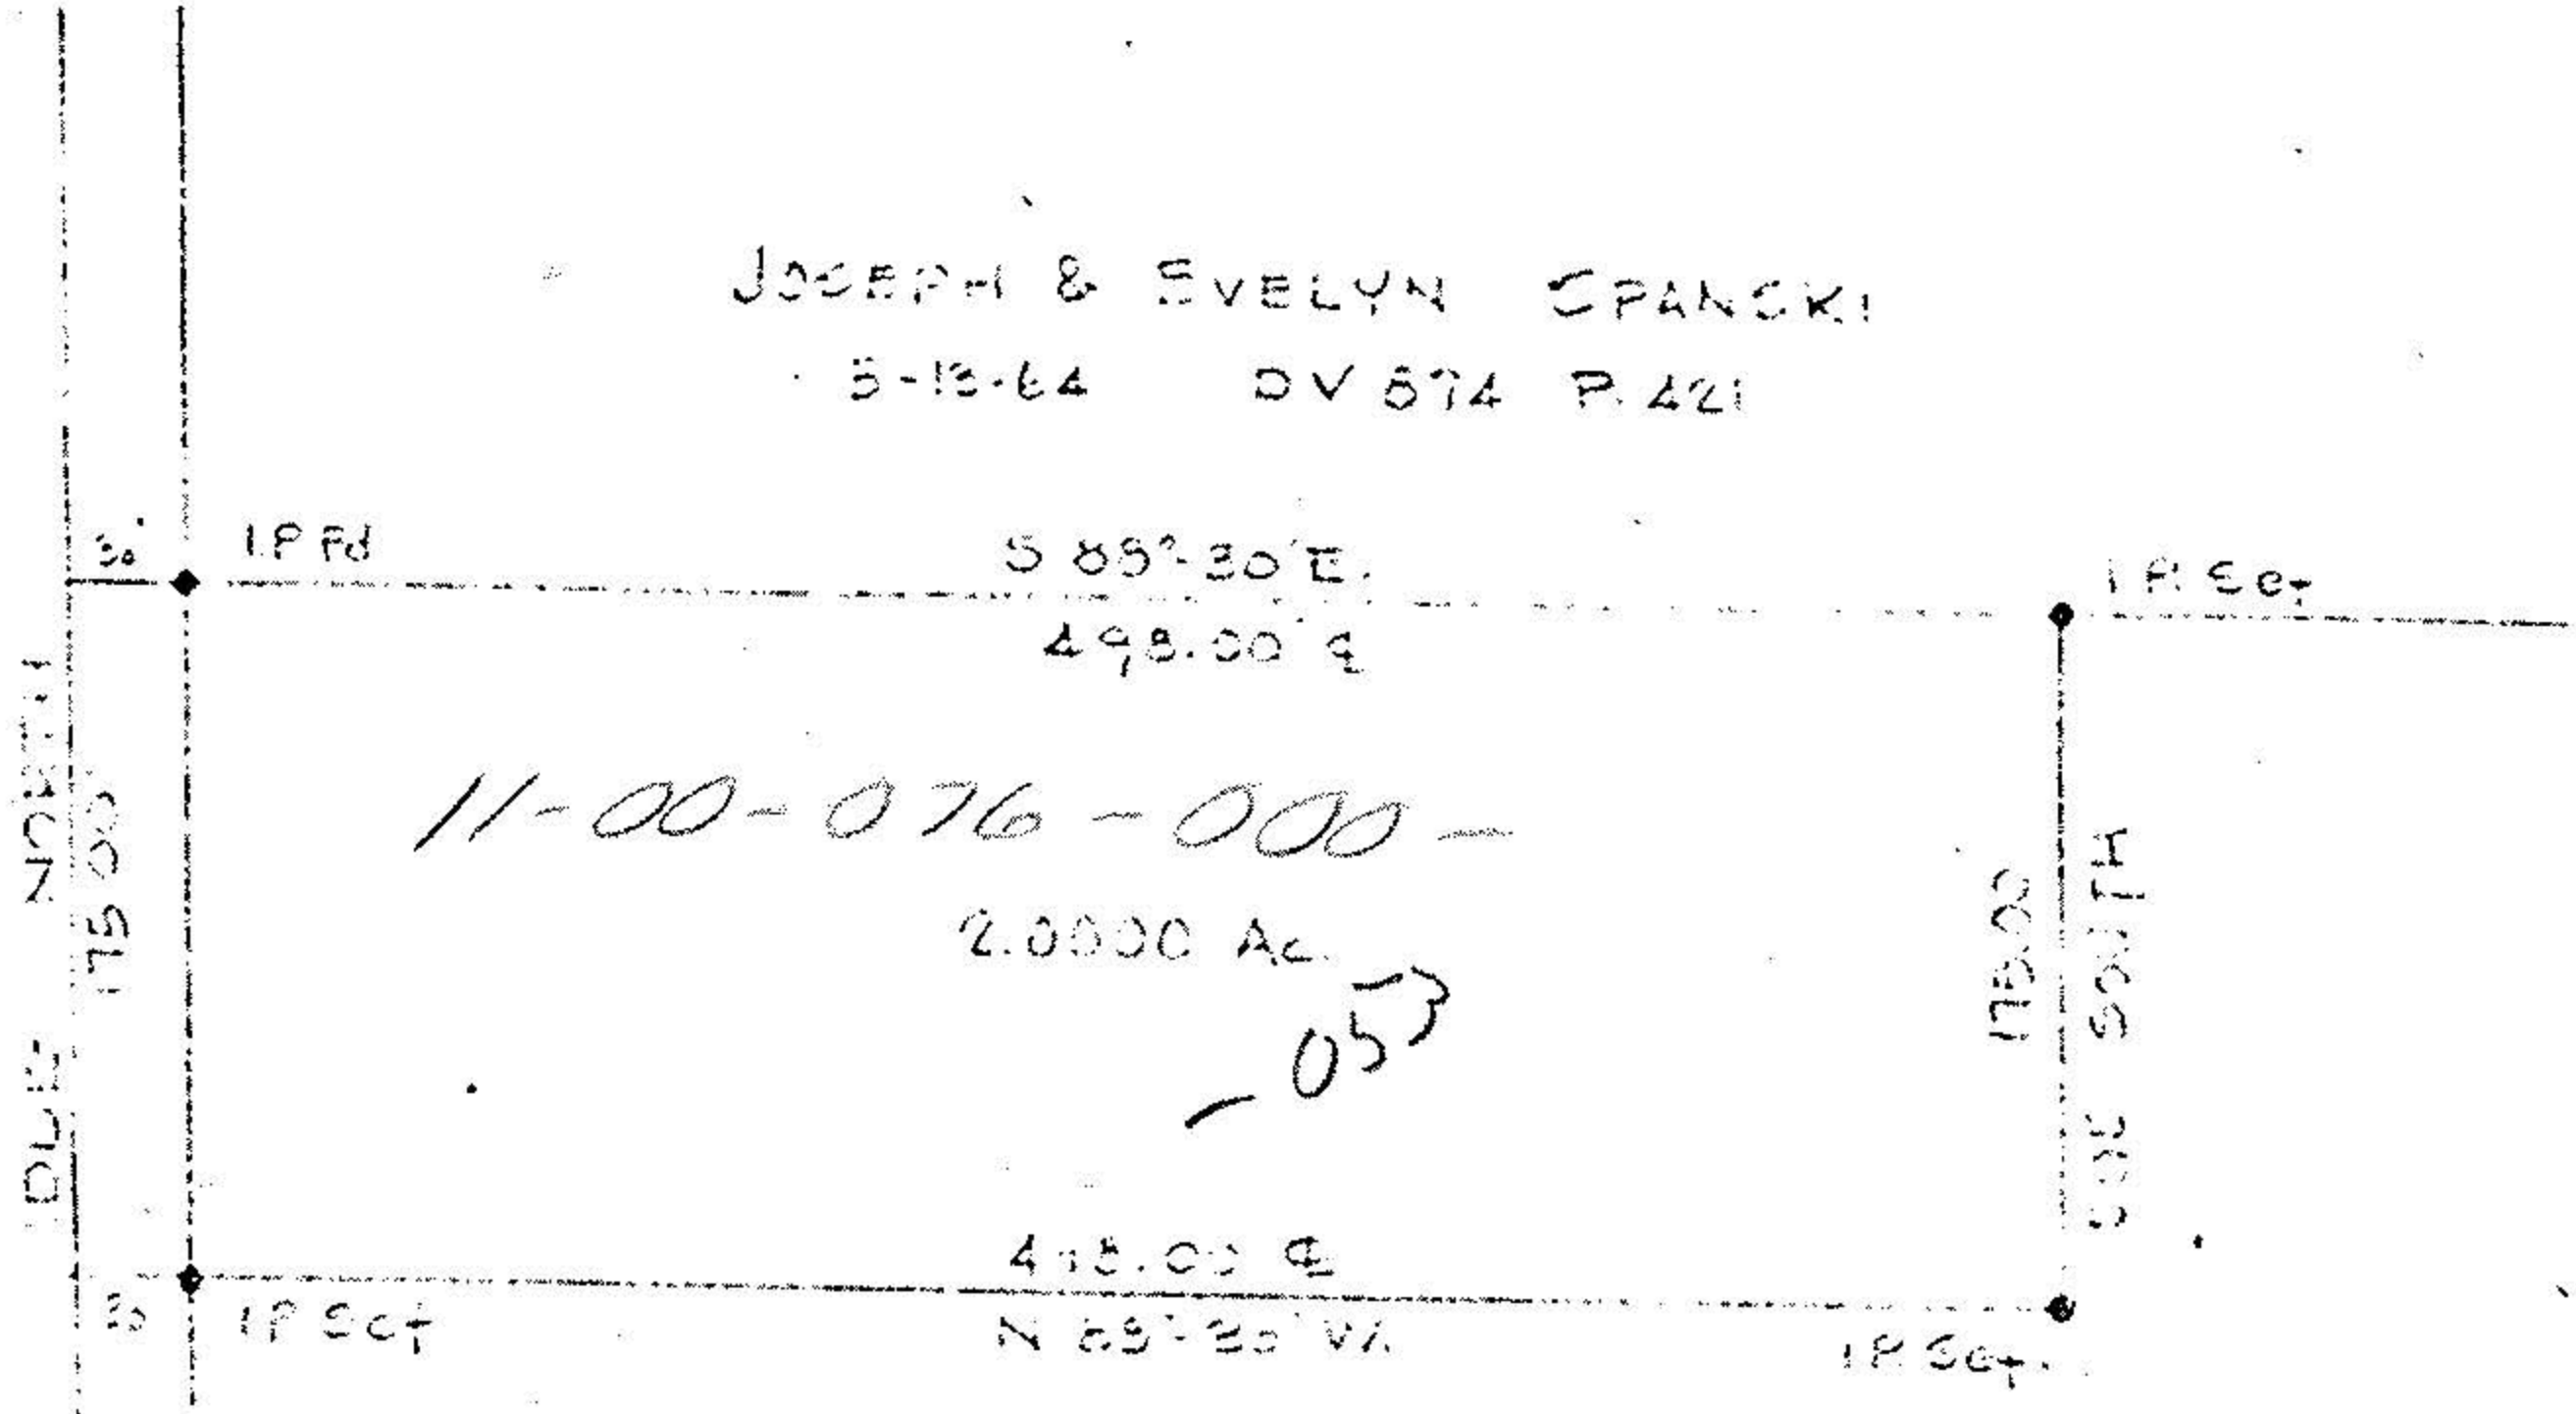

JUN 23 1977

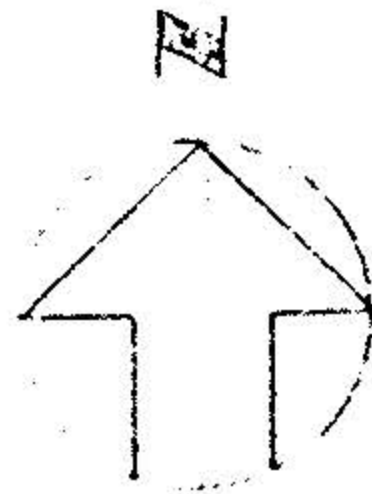

11-00-076 A

SURVEY FOR

PASQUALE & ELMA M. CUCUZZA

OL 76 EATON TWP, LORAIN COUNTY, OHIO

SCALE 1"=100'

JUNE 10, 1977

LAUNDON • SIMON • CALL & ASSOC
ENGINEERS SURVEYORS

JOB No 77-624

FB 107/11