


SURVEY PLAT

BEING A PART OF TRACT NUMBER 2, LOT NUMBER 6
 TOWNSHIP 2 NORTH - RANGE 18 WEST
 TOWNSHIP OF HUNTINGTON
 COUNTY OF LORAIN, STATE OF OHIO

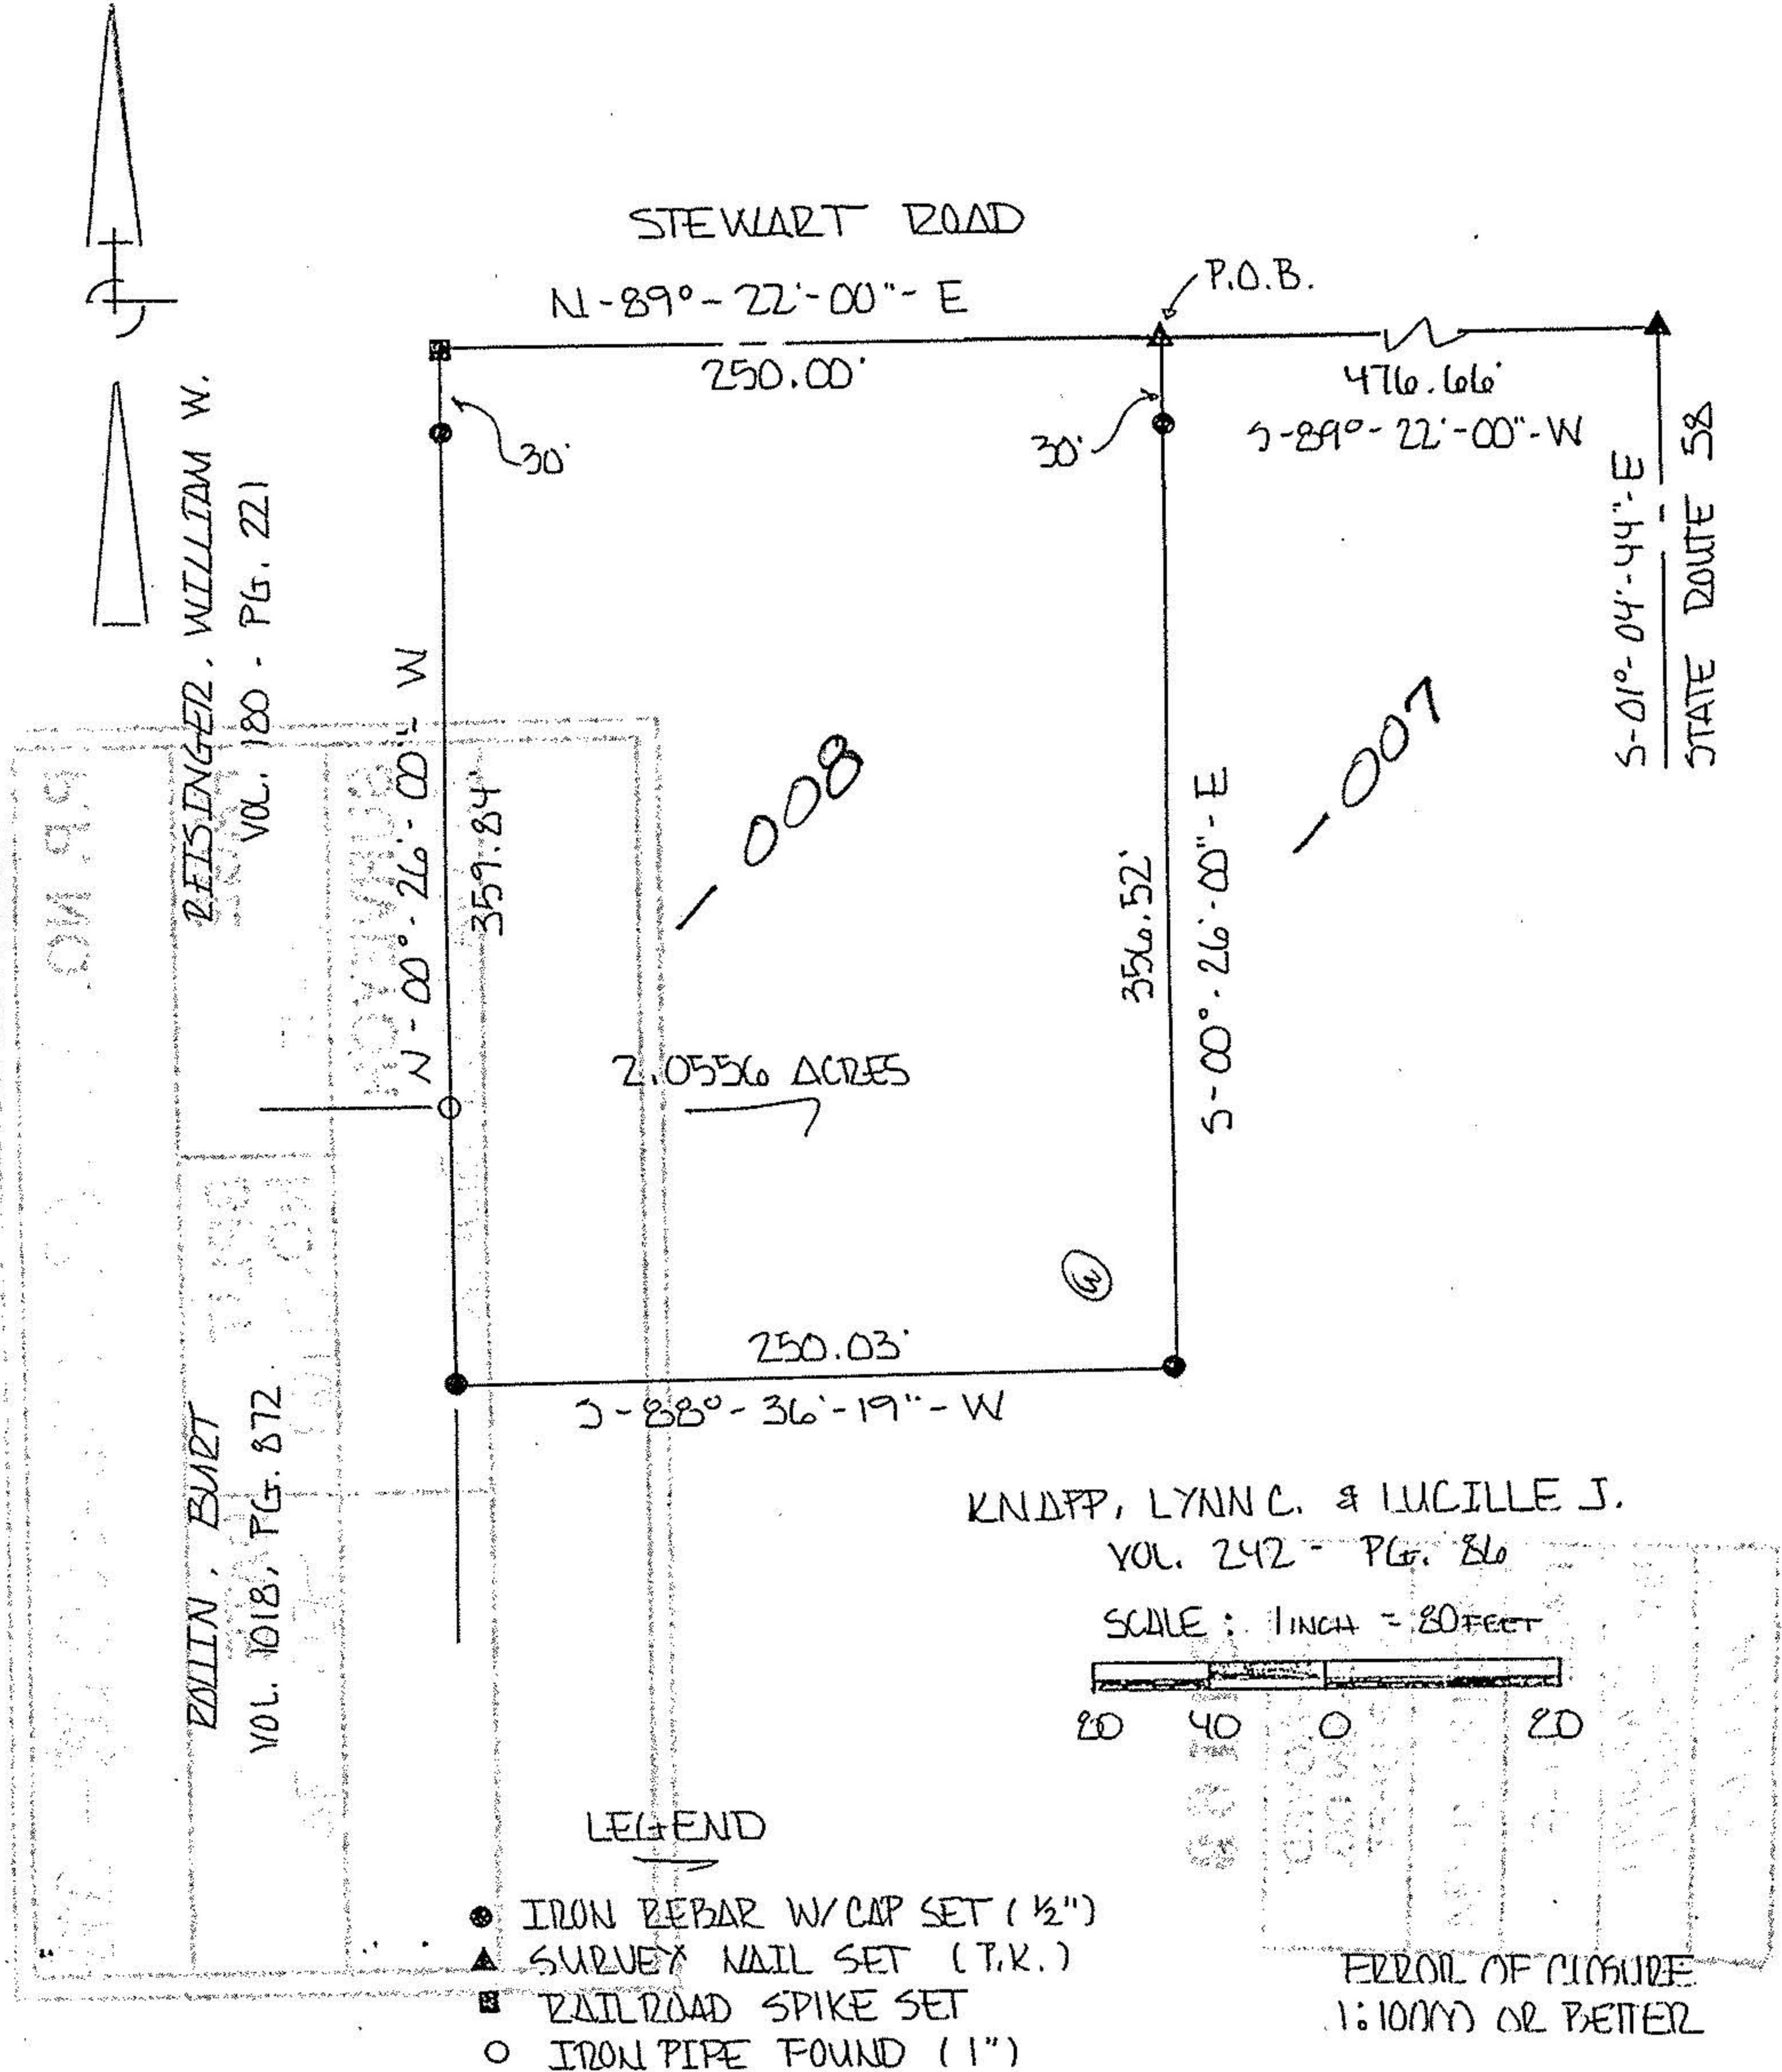

KNAPP, LYNN C. & LUCILLE J.
 VOL. 242 - PG. 86

SCALE: 1 INCH = 80 FEET



LEGEND

- IRON REBAR W/CAP SET (1/2")
- ▲ SURVEY NAIL SET (T.K.)
- RAILROAD SPIKE SET
- IRON PIPE FOUND (1")

ERROR OF MEASURE
 1:10000 OR BETTER

CERTIFICATION

I EDWARD G. BLACK, P.S., REGISTERED SURVEYOR NUMBER 6365,
 DO HEREBY CERTIFY THE ABOVE PLAT TO BE A TRUE REPRESENTATION
 OF AN ACTUAL FIELD SURVEY PERFORMED BY ME IN SEPTEMBER OF 1994.
 ALL BEARINGS ARE FOR THE PURPOSE OF ANGULAR MEASUREMENT ONLY
 AND WERE TAKEN FROM RECORDED DEED BOOK 180 - PAGE 221.

EDWARD G. BLACK, P.S. *Edward G. Black, P.S.*

